STAGE 2 TEMPORARY WIRING DIAGRAM

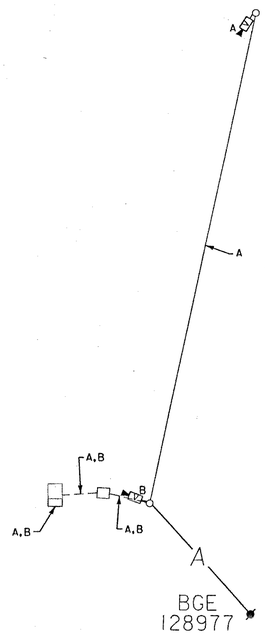

WIRING KEY

A, B } VIDEO DETECTION CAMERA CABLES

STAGE 3 TEMPORARY WIRING DIAGRAM

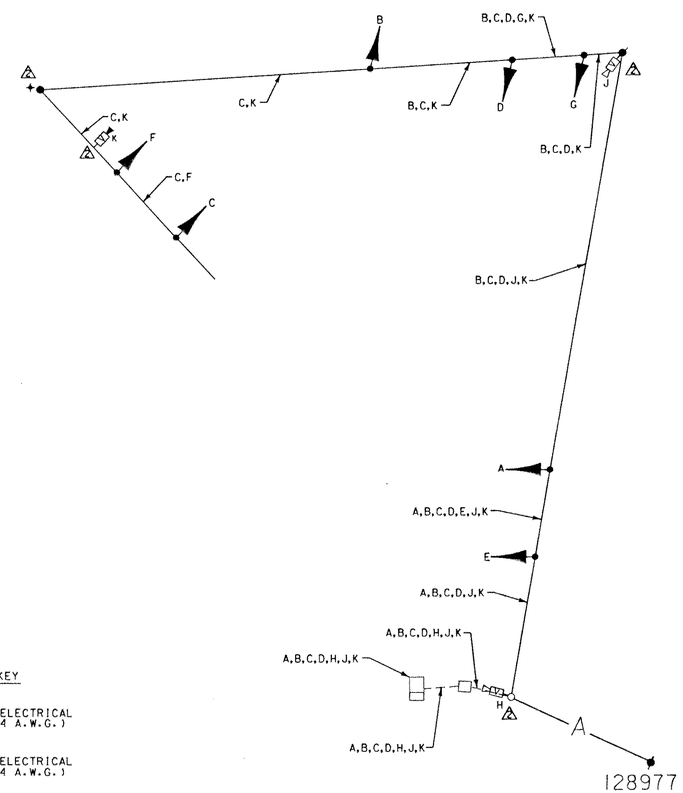

WIRING KEY

A, B, C, D } 7-CONDUCTOR ELECTRICAL CABLE (NO. 14 A.W.G.)

E, F, G } 5-CONDUCTOR ELECTRICAL CABLE (NO. 14 A.W.G.)

H, J, K } VIDEO DETECTION CAMERA CABLES

+ - 3/4 IN.x10 FT. LENGTH GROUND ROD

STAGES 4 AND 5 TEMPORARY WIRING DIAGRAM

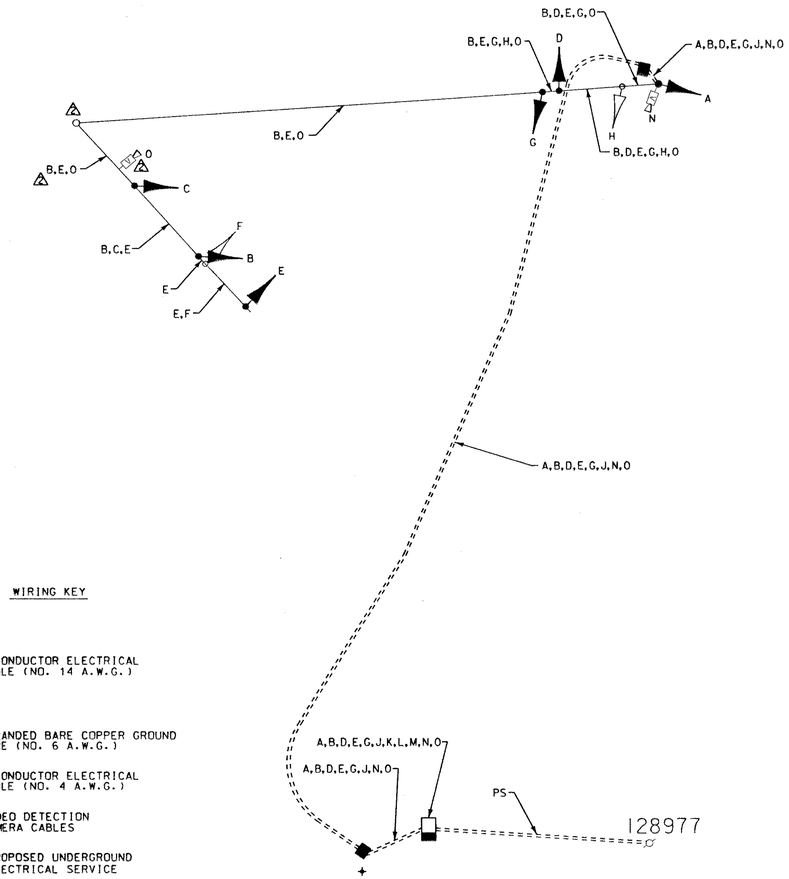

WIRING KEY

A, B, C, D, E, F, G, H } 5-CONDUCTOR ELECTRICAL CABLE (NO. 14 A.W.G.)

J } STRANDED BARE COPPER GROUND WIRE (NO. 6 A.W.G.)

K, L, M } 1-CONDUCTOR ELECTRICAL CABLE (NO. 4 A.W.G.)

N, O } VIDEO DETECTION CAMERA CABLES

PS - PROPOSED UNDERGROUND ELECTRICAL SERVICE

+ - 3/4 IN. X 10 FT. LENGTH GROUND ROD

STAGE 6 TEMPORARY WIRING DIAGRAM

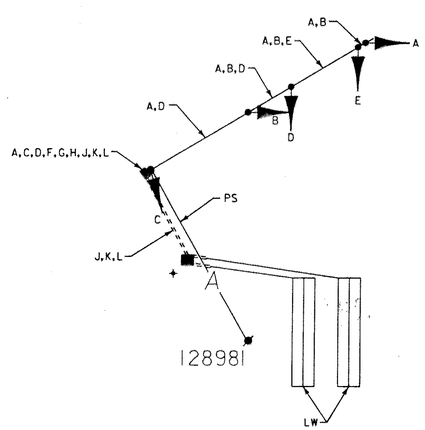

WIRING KEY

A, B, C, D, E } 5-CONDUCTOR ELECTRICAL CABLE (NO. 14 A.W.G.)

F, G, H } 1-CONDUCTOR ELECTRICAL CABLE (NO. 4 A.W.G.)

J } STRANDED BARE COPPER GROUND WIRE (NO. 6 A.W.G.)

K, L } 2-CONDUCTOR ELECTRICAL CABLE ALUMINUM SHIELDED (NO. 14 A.W.G.)

PS - PROPOSED OVERHEAD ELECTRICAL SERVICE

LW - LOOP WIRE (NO. 14 A.W.G.)

+ - 3/4 IN. X 10 FT. LENGTH GROUND ROD

2 ADDENDUM NO. 2
JANUARY . 2001
ADDED STAGE 2 WIRING DIAGRAM:
REVISED DETECTION

WR&A
Whitman, Requardt and Associates, LLP
2315 Saint Paul Street
Baltimore, Maryland 21218
(410) 235-3450

TSP-06

MARYLAND DOT - STATE HIGHWAY ADMINISTRATION
Office of Traffic & Safety
TRAFFIC ENGINEERING DESIGN DIVISION
GENERAL INFORMATION SHEET - STAGES 2,3,4,5,6
MD 32 AND CANINE ROAD

DRAWN BY: J. RASMUSSEN	F.A.P. NO.		TS NO. 3126	SHEET NO.
CHECKED BY: S.CHAMBERLAIN	S.H.A. NO.	AA6665170		
SCALE: NONE	COUNTY:	ANNE ARUNDEL	T.I.M.S. NO.	283 OF 314
DATE: 11/01	LOG MILE:			

M:\3(095)\tsp06md32.dgn