F H WA REGION NO	STATE	FED. AID PROJ. NO	SHEET NO.	TOTAL SHEETS
3	MD.			

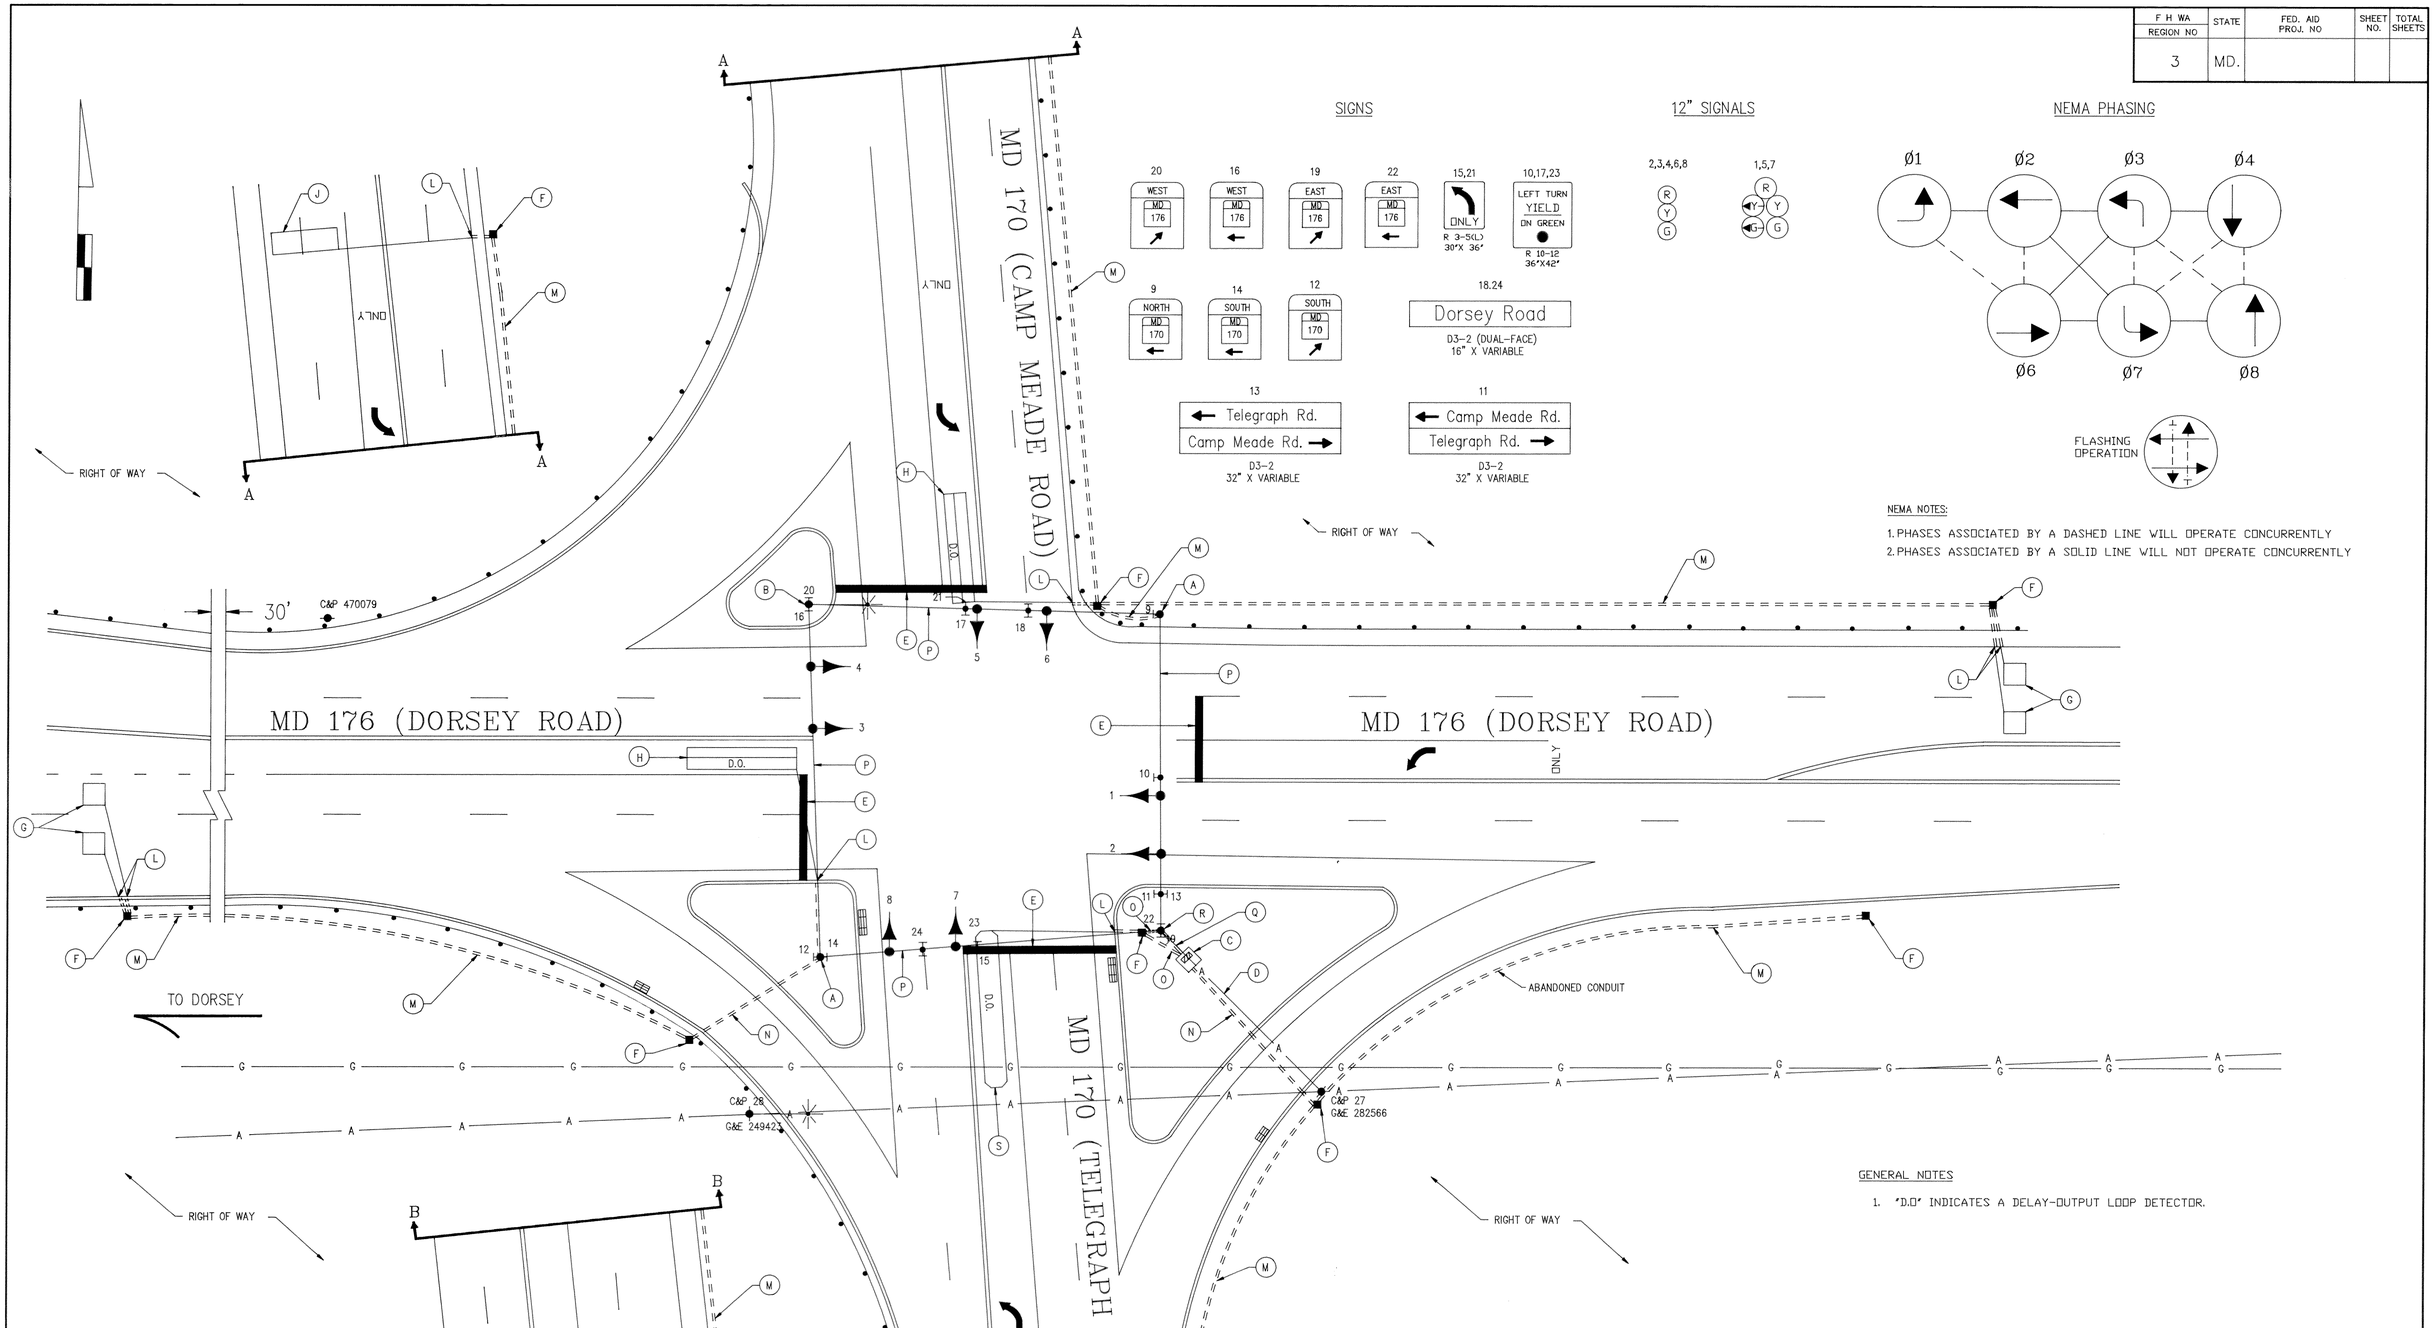

UTILITY LEGEND

G	GAS MAIN
W	WATER MAIN
S	SEWER MAIN
E	ELECTRIC CABLES
A	AERIAL CABLES
T	TELEPHONE CABLES

REVISIONS	APPROVALS
E 2-25-91 AS-BUILT TGM	ORIGINAL CHIEF, SIGNAL DESIGN SECTION ON ASST. DISTRICT ENGINEER, TRAFFIC CHIEF, TRAFFIC ENGINEERING DIVISION FILE DEPUTY CHIEF ENGINEER, OFFICE OF TRAFFIC

MDOT – STATE HIGHWAY ADMINISTRATION
Office of Traffic
TRAFFIC ENGINEERING DIVISION

SIGNAL # 02017005.43

DRAWN BY: J. GORDON
DES. BY: DENNIS DODA
CHK. BY: ALFRED BUDNICHUK

MD 176 & MD 170

COUNTY: ANNE ARUNDEL

DATE: 11-27-72 F.A.P. NO. N/A
SCALE: 1" = 20' S.H.A. NO. AW-343-452-085

TS/STD. NO. TS-800 E

SHEET NO. 1 OF 1