F H WA REGION NO	STATE	FED. AID PROJ. NO	SHEET NO.	TOTAL SHEETS
3	MD.			

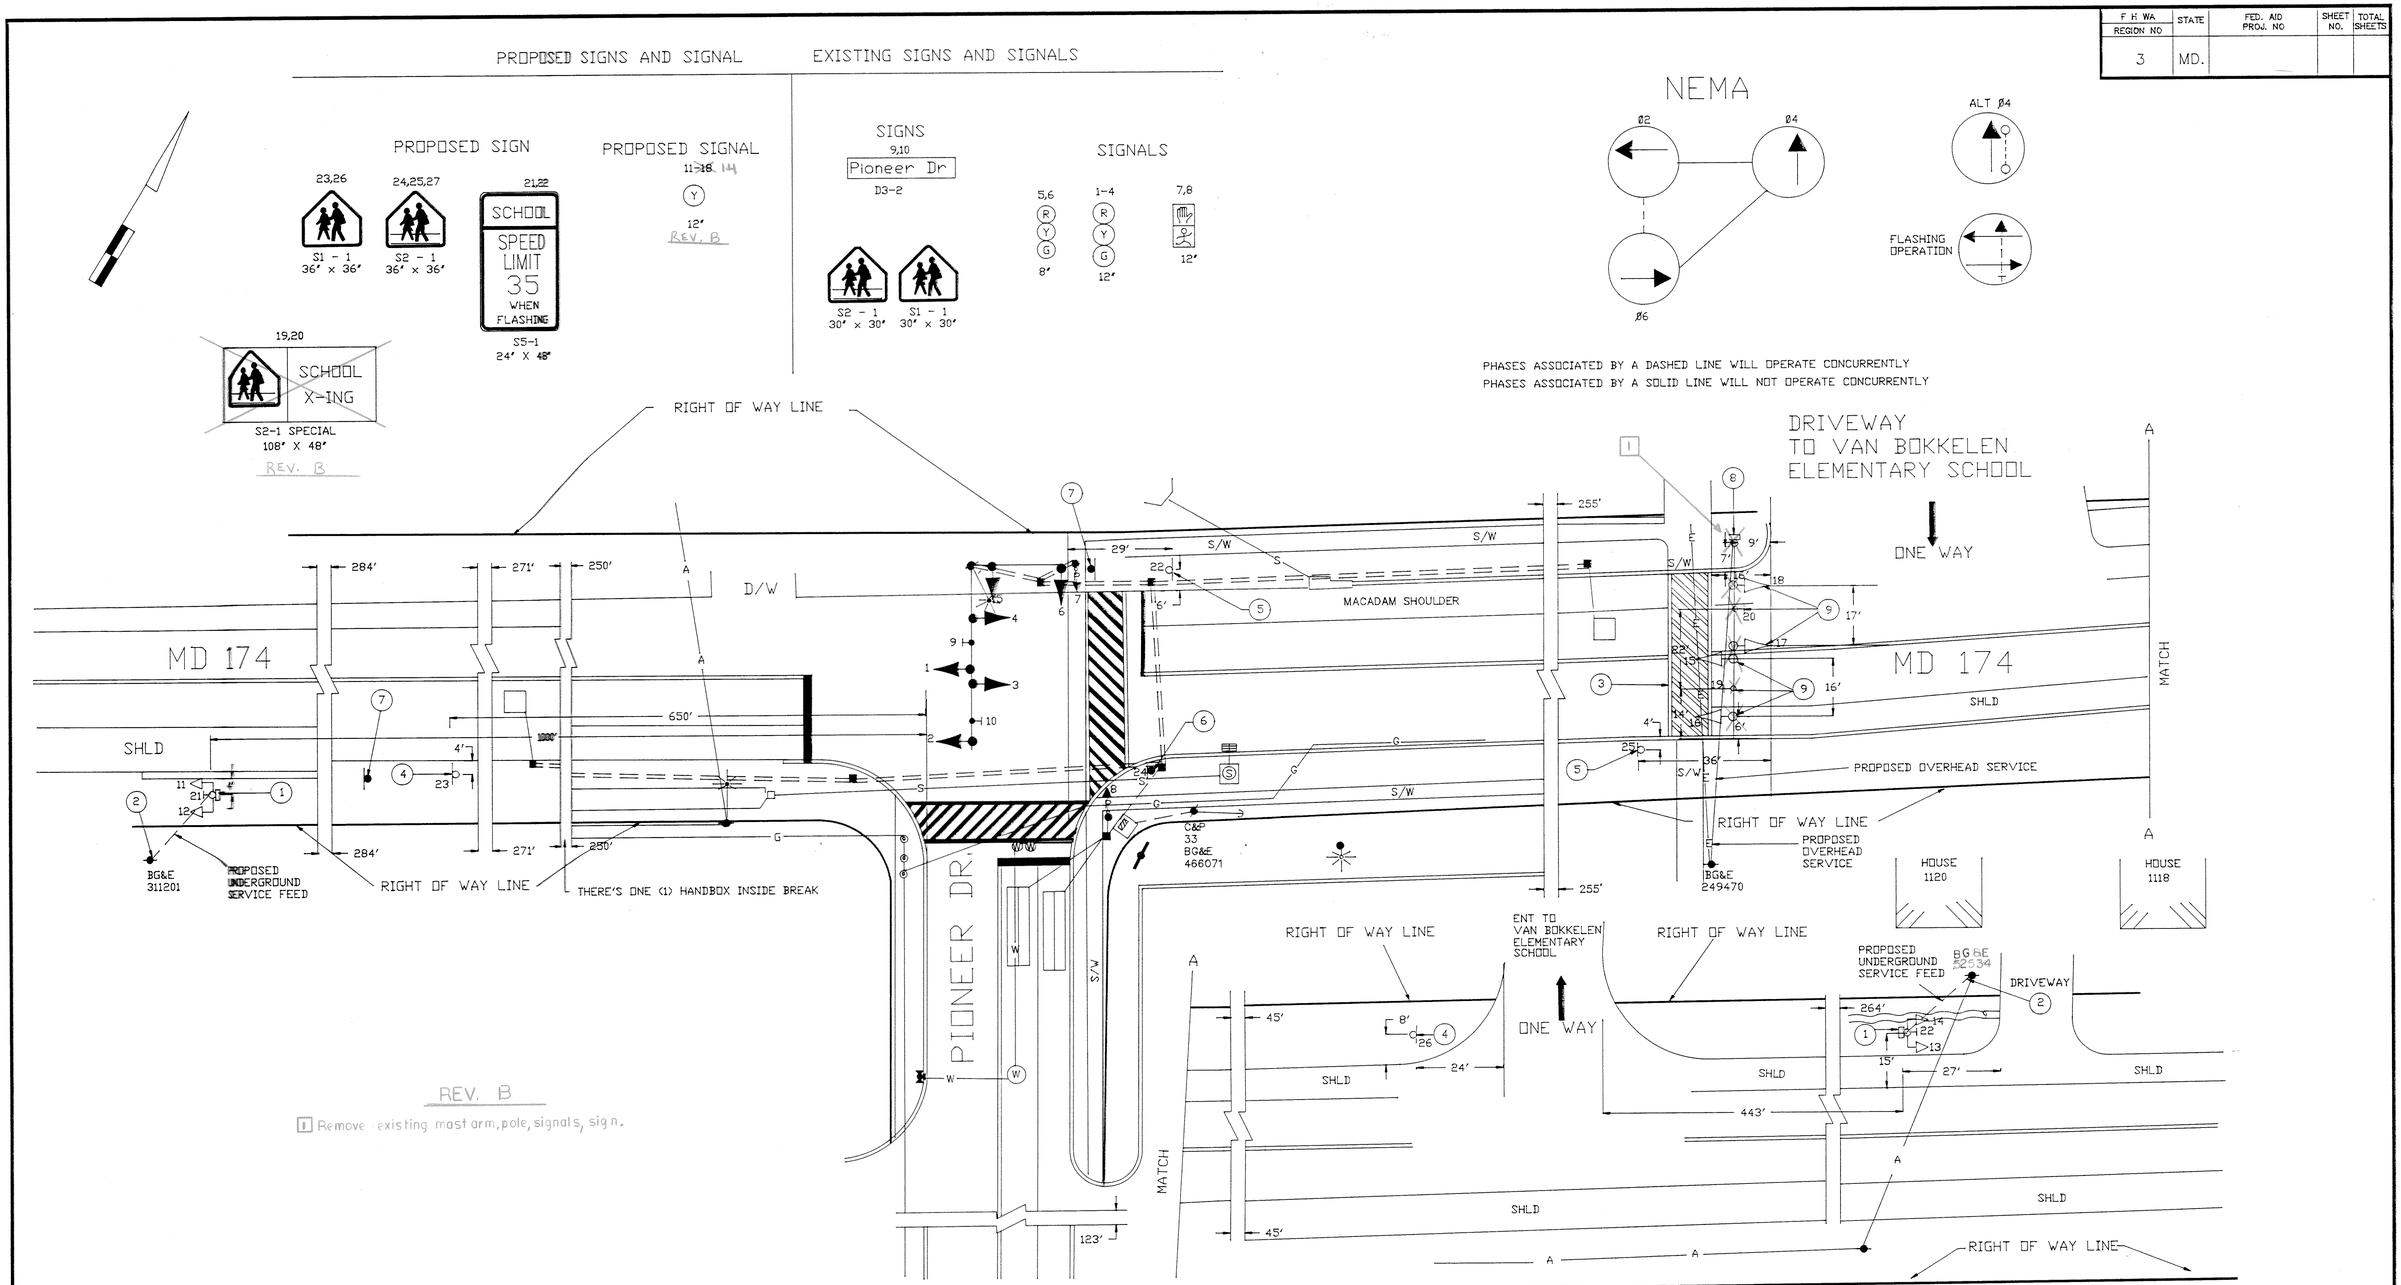

UTILITY LEGEND

- —G—G— GAS MAIN
- —W—W— WATER MAIN
- —S—S— SEWER MAIN
- —E—E— ELECTRIC CABLES
- —A—A— AERIAL CABLES
- —T—T— TELEPHONE CABLES

REVISIONS	APPROVALS
B 5-99 Remove ADVANCE HIB	CHIEF, SIGNAL DESIGN SECTION
ASBUILT 2/90 INSTALL H.I.B FOR SCHOOL CROSSINGS	ASST. DISTRICT ENGINEER, TRAFFIC
	CHIEF, BUREAU OF TRAFFIC ENGINEERING
	DEPUTY CHIEF ENGINEER, OFFICE OF TRAFFIC

NOTE: THIS IS REVISION TO TS-2494 THE ORIGINAL TS-2494 IS ON FILE.

MDOT – STATE HIGHWAY ADMINISTRATION
Office of Traffic
TRAFFIC ENGINEERING DIVISION

SIGNAL #

REDRAWN DRAWN BY ACAD: DERRICK DICKERSON
DES. BY: R R ZACHERL (FOR STS)
CHK. BY:

MD 174 AND PIONEER DR
VAN BOKKELEN ELEMENTARY SCHOOL
COUNTY: ANNE ARUNDEL

DATE: 7/28/88
SCALE: 1"=20'
F.A.P. NO.
S.H.A. NO.
TS/FILE NO. TS-2494 (A)
SHEET NO. ___ OF ___

02017400.48