F H WA REGION NO	STATE	FED. AID PROJ. NO	SHEET NO.	TOTAL SHEETS
3	MD.			

EXISTING SIGNALS

1-8

R
Y
G

12"

PROPOSED SIGNALS & SIGNS

9,10 — 12"

11a,12b — W 11a-2 30" x 30"

11b,12a — W 11a-2 30" x 30"

M 6-2 21" x 15" Right Arrow

M 6-2 21" x 15" Left Arrow

PUSH BUTTON TO CROSS ODENTON RD.
START CROSSING WATCH FOR TURNING CARS
DON'T START FINISH CROSSING IF STARTED
FLASHING
PEDESTRIANS SHOULD NOT BE IN CROSSWALK
STEADY
R 10-3C 12" x 9"

PUSH BUTTON TO CROSS ODENTON RD.
START CROSSING WATCH FOR TURNING CARS
DON'T START FINISH CROSSING IF STARTED
FLASHING
PEDESTRIANS SHOULD NOT BE IN CROSSWALK
STEADY
R 10-3C 12" x 9"

NEMA PHASES:

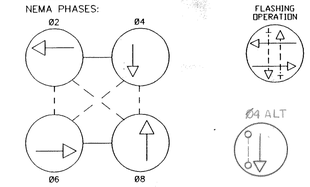

NEMA NOTES:
1. PHASES ASSOCIATED BY A DASHED LINE WILL OPERATE CONCURRENTLY.
2. PHASES ASSOCIATED BY A SOLID LINE WILL NOT OPERATE CONCURRENTLY.

WARNING: HIGH VOLTAGE LINES IN AREA

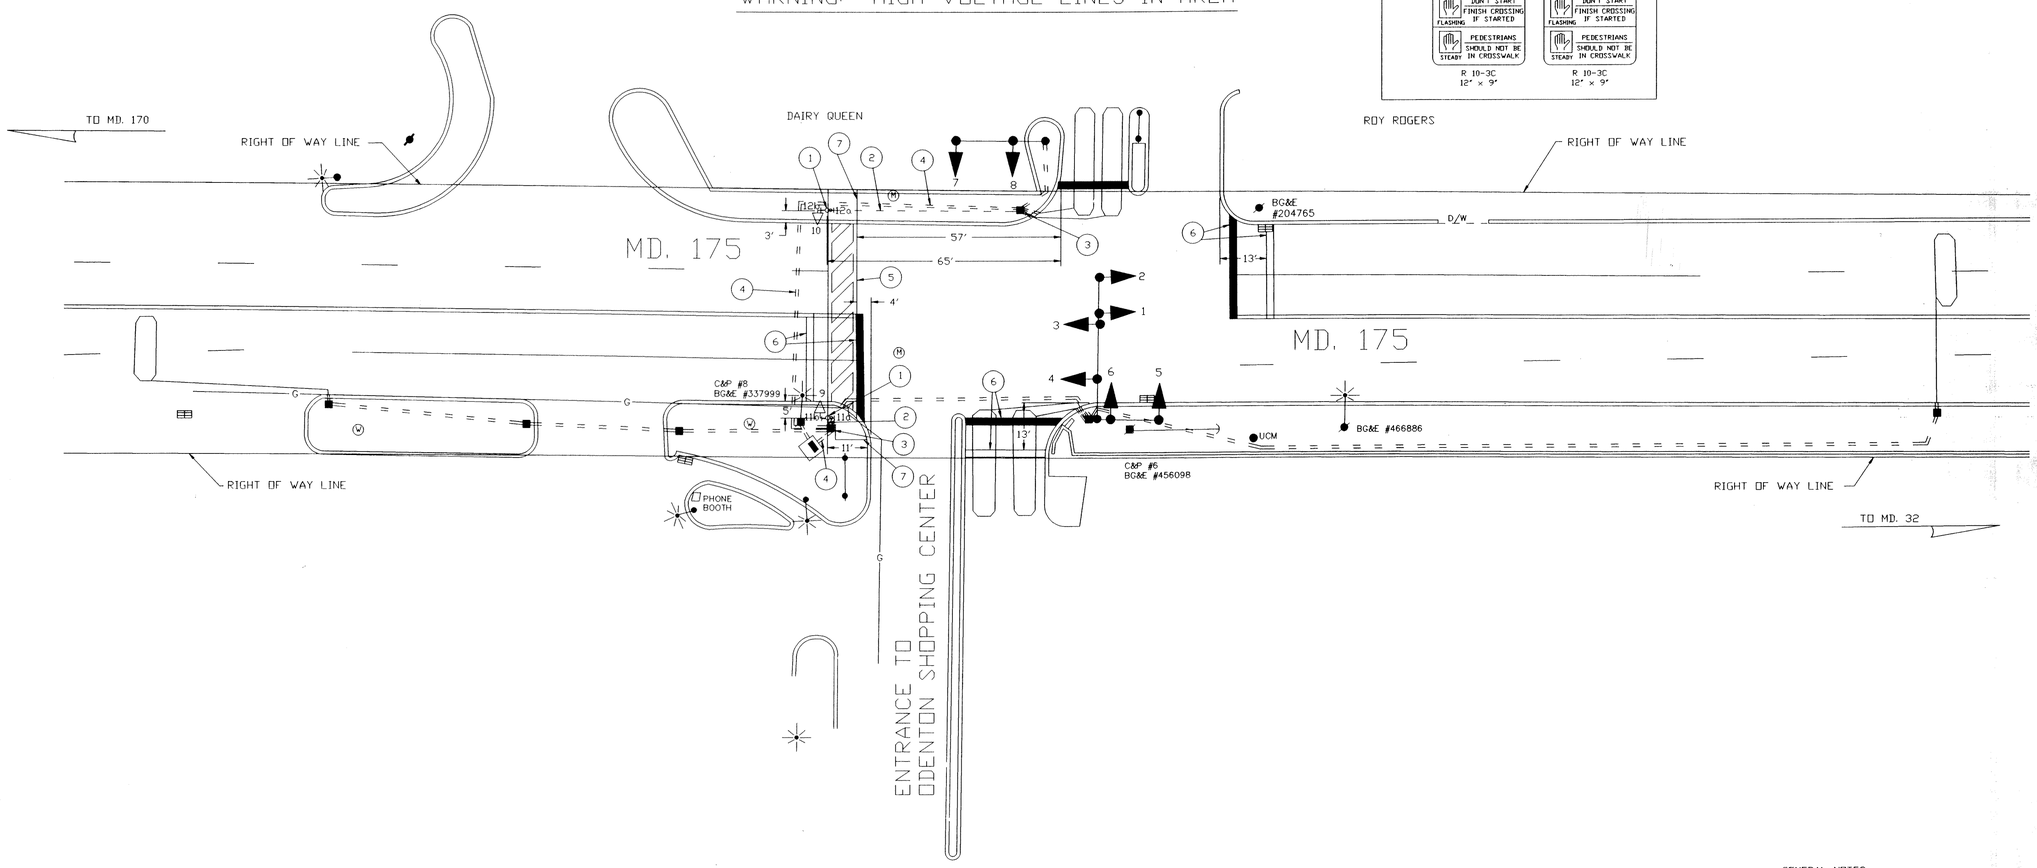

GENERAL NOTES:
1. REVISION 'D' IS A MODIFICATION TO WORK COMPLETED UNDER CONTRACT NO. AA 207-501-585, DATED 11-19-74.
2. THE ORIGINAL TS-1241 IS ON FILE.

UTILITY LEGEND

—G—G—	GAS MAIN
—W—W—	WATER MAIN
—S—S—	SEWER MAIN
—E—E—	ELECTRIC CABLES
—A—A—	AERIAL CABLES
—T—T—	TELEPHONE CABLES

REVISIONS	APPROVALS
D. 04/93 - ADD PED. SIGNALS BUTTONS, & SIGNS TO N/S SHA #	CHIEF, SIGNAL DESIGN SECTION
C. 1/93 AS BUILT	ASST. DISTRICT ENGINEER, TRAFFIC
B. 3-9-79 CORRECT LOCATION OF EXISTING CONDUIT	CHIEF, TRAFFIC ENGINEERING DESIGN DIVISION
A. 12/15/78 AS BUILT AA 207-501-585	DIRECTOR, OFFICE OF TRAFFIC & SAFETY
GLYNIS DODA DAZ	

NOTE: THIS IS A REVISION TO AA 207-501-585 DATED 11-19-74 ORIGINAL PLAN ON FILE

MDOT – STATE HIGHWAY ADMINISTRATION
Office of Traffic & Safety
TRAFFIC ENGINEERING DESIGN DIVISION SIGNAL # 02017502.35

DRAWN BY: DENNIS DODA
DES. BY: DENNIS DODA
CHK. BY: A. BUDINCHUK 1/17/78

MD. 175 & the ENTRANCE TO ODENTON SHOPPING CENTER

COUNTY: ANNE ARUNDEL

DATE: 11-19-74
SCALE: 1"= 20'
F.A.P. NO.
S.H.A. NO. AA 207-501-585

TS/STD. NO. TS-1241 D

SHEET NO. 1 OF 1

F#7

02017502.35