F H WA REGION NO	STATE	FED. AID PROJ. NO	SHEET NO.	TOTAL SHEETS
3	MD.			

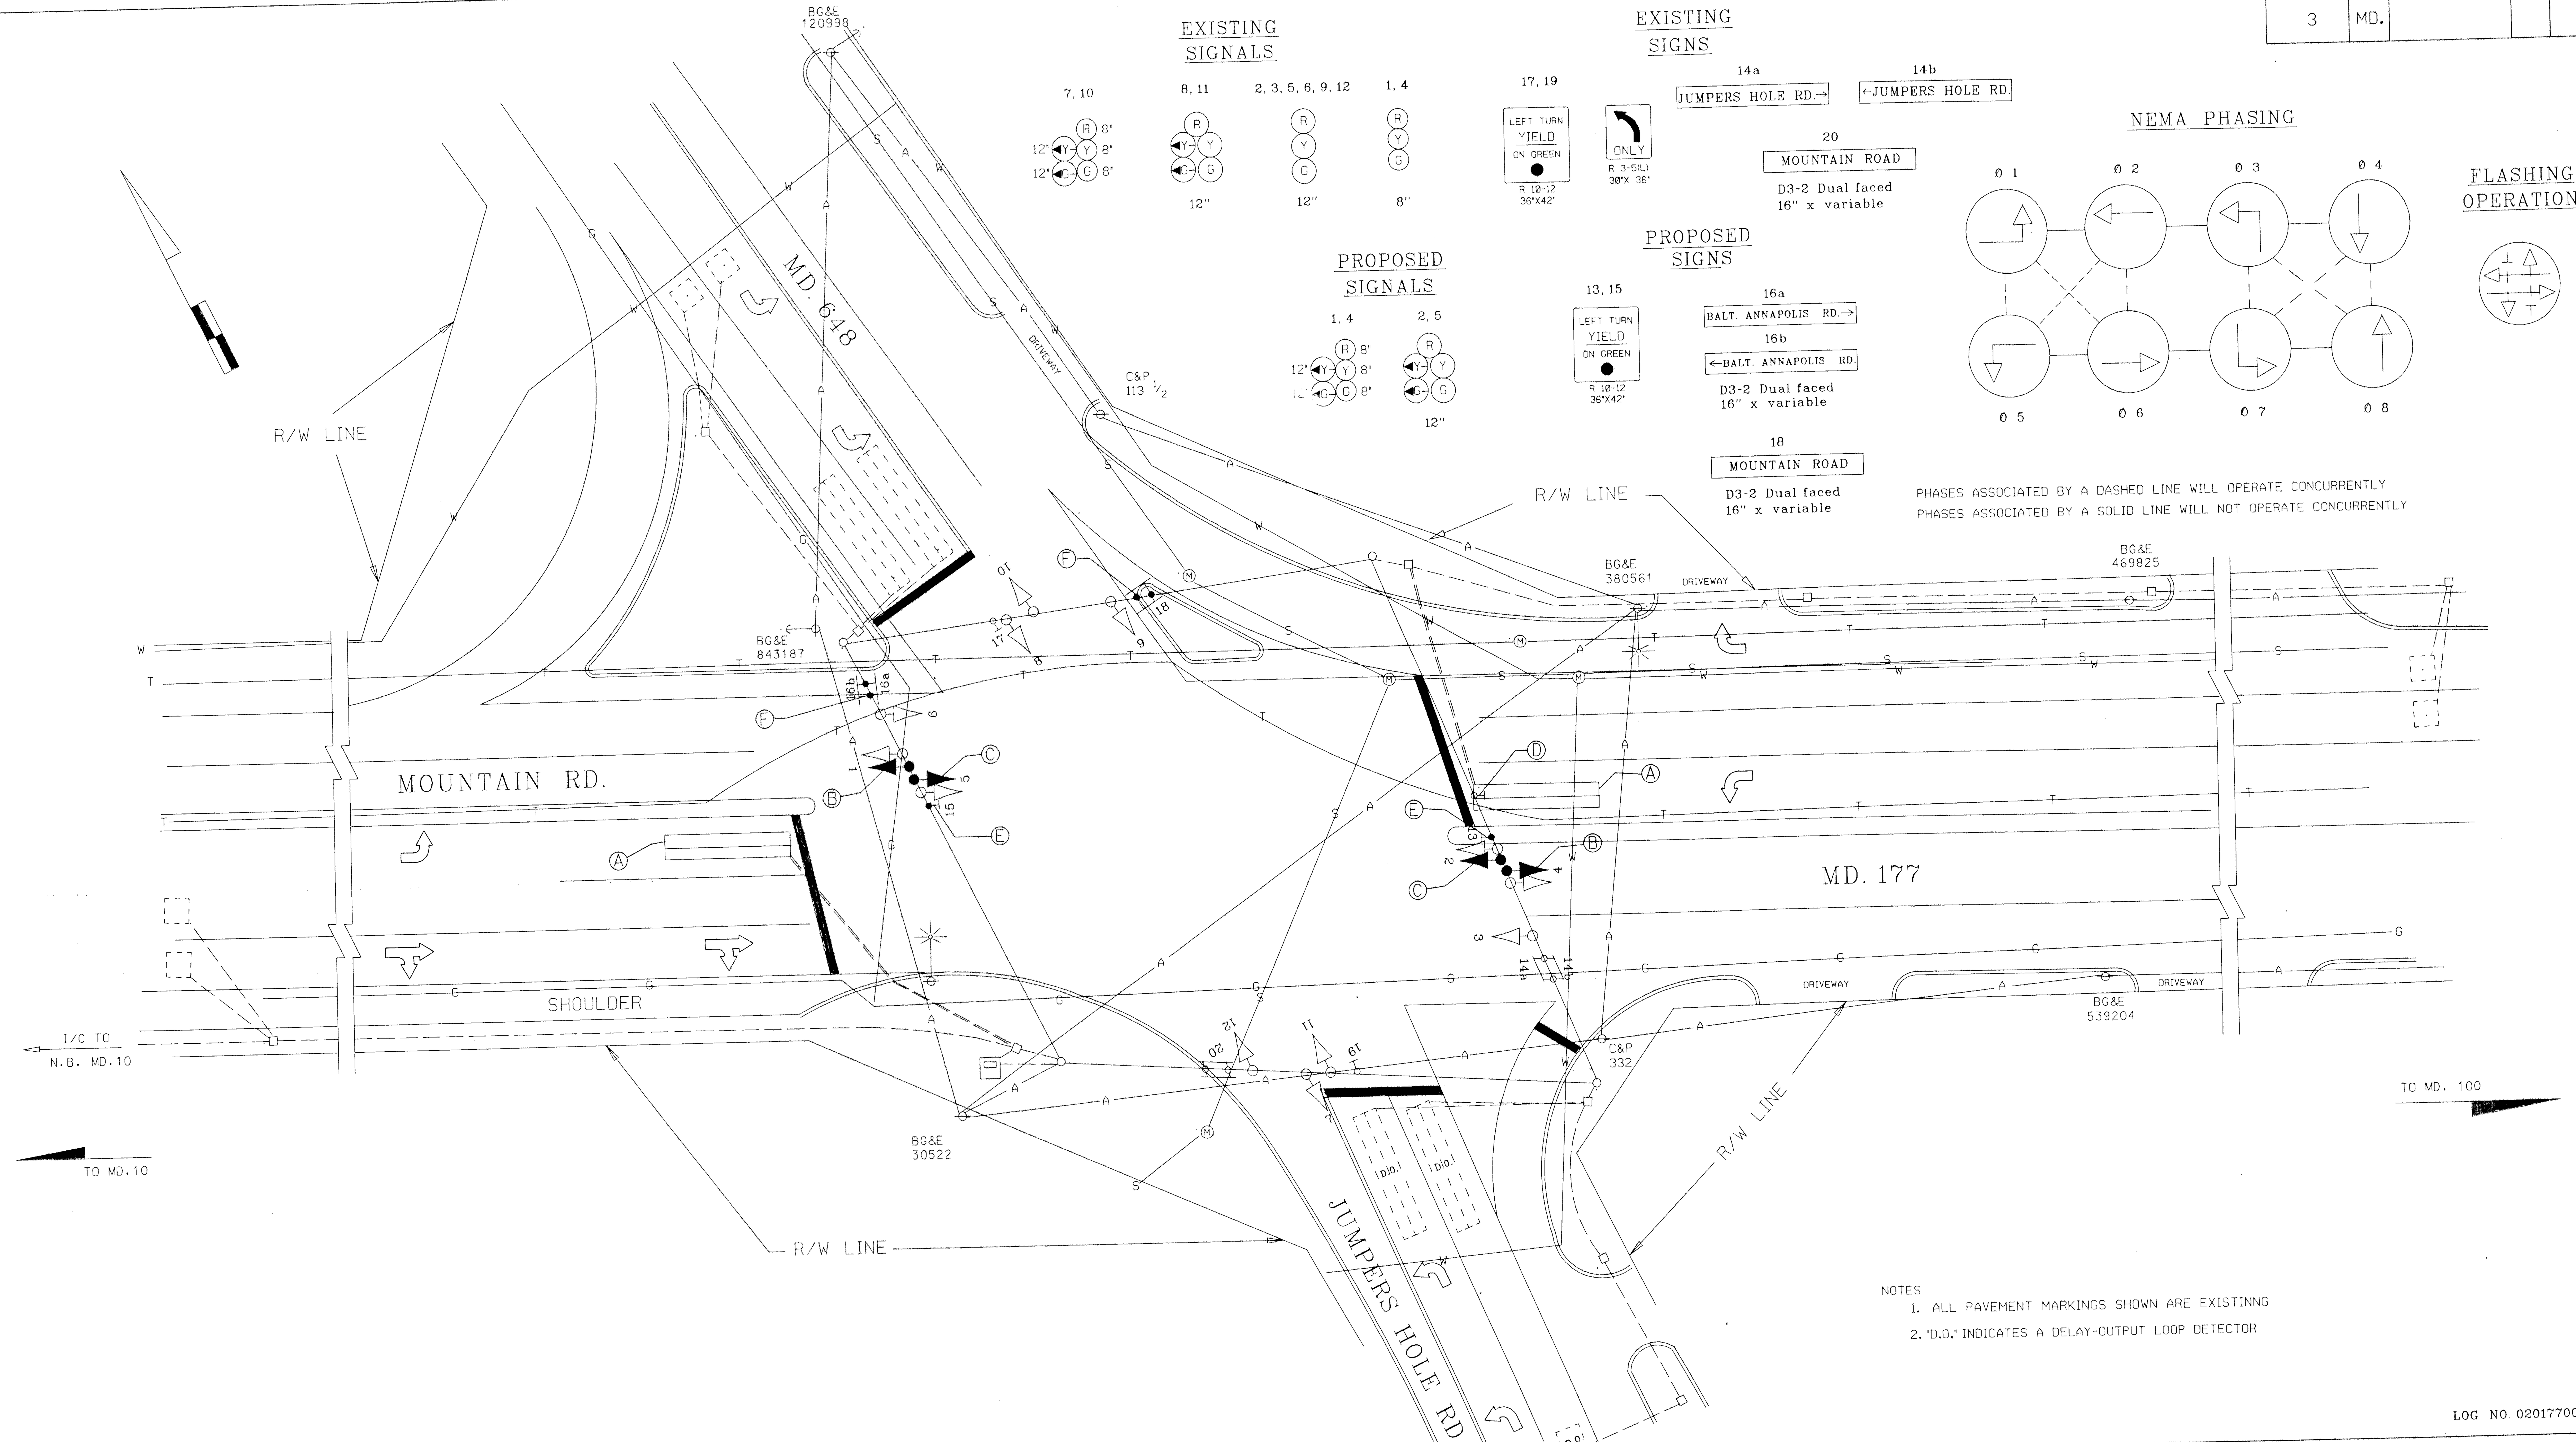

NOTES
1. ALL PAVEMENT MARKINGS SHOWN ARE EXISTINNG
2. "D.O." INDICATES A DELAY-OUTPUT LOOP DETECTOR

LOG NO. 02017700.80

REVISIONS	APPROVALS
Ⓖ 6-21-94 INSTALL E/B AND W/B E/P LEFT TURNS FOR MD 177 ONTO JUMPERS HOLE RD AND MD 648 — RBC/AA	CHIEF, SIGNAL DESIGN SECTION
Ⓕ 1-14-92 INSTALL N/B E/P LEFT TURN FOR JUMPERS HOLE RD. RECUT LOOP DETECTORS N/B JUMPERS HOLE RD. — MAR	ASST. DISTRICT ENGINEER, TRAFFIC
	CHIEF, TRAFFIC ENGINEERING DESIGN DIVISION
	DEPUTY CHIEF ENGINEER, OFFICE OF TRAFFIC & SAFTEY

ORIGINAL ON FILE

MDOT - STATE HIGHWAY ADMINISTRATION
OFFICE OF TRAFFIC & SAFETY
TRAFFIC ENGINEERING DESIGN DIVISION

DRAWN BY: R.B.C./A.A.
DES. BY:
CHK. BY:

MD. 177 (MOUNTAIN RD.) @ MD. 648/JUMPERS HOLE ROAD

SIGNAL # 97
COUNTY: ANNE ARUNDEL

DATE: REDRAWN 6/94
SCALE: 1" = 20'
F.A.P. NO. 2/94
S.H.A. NO. AW 603-505-576
TS/STD. NO. TS-97G
SHEET NO. ___ OF ___

F#7

02017700.80