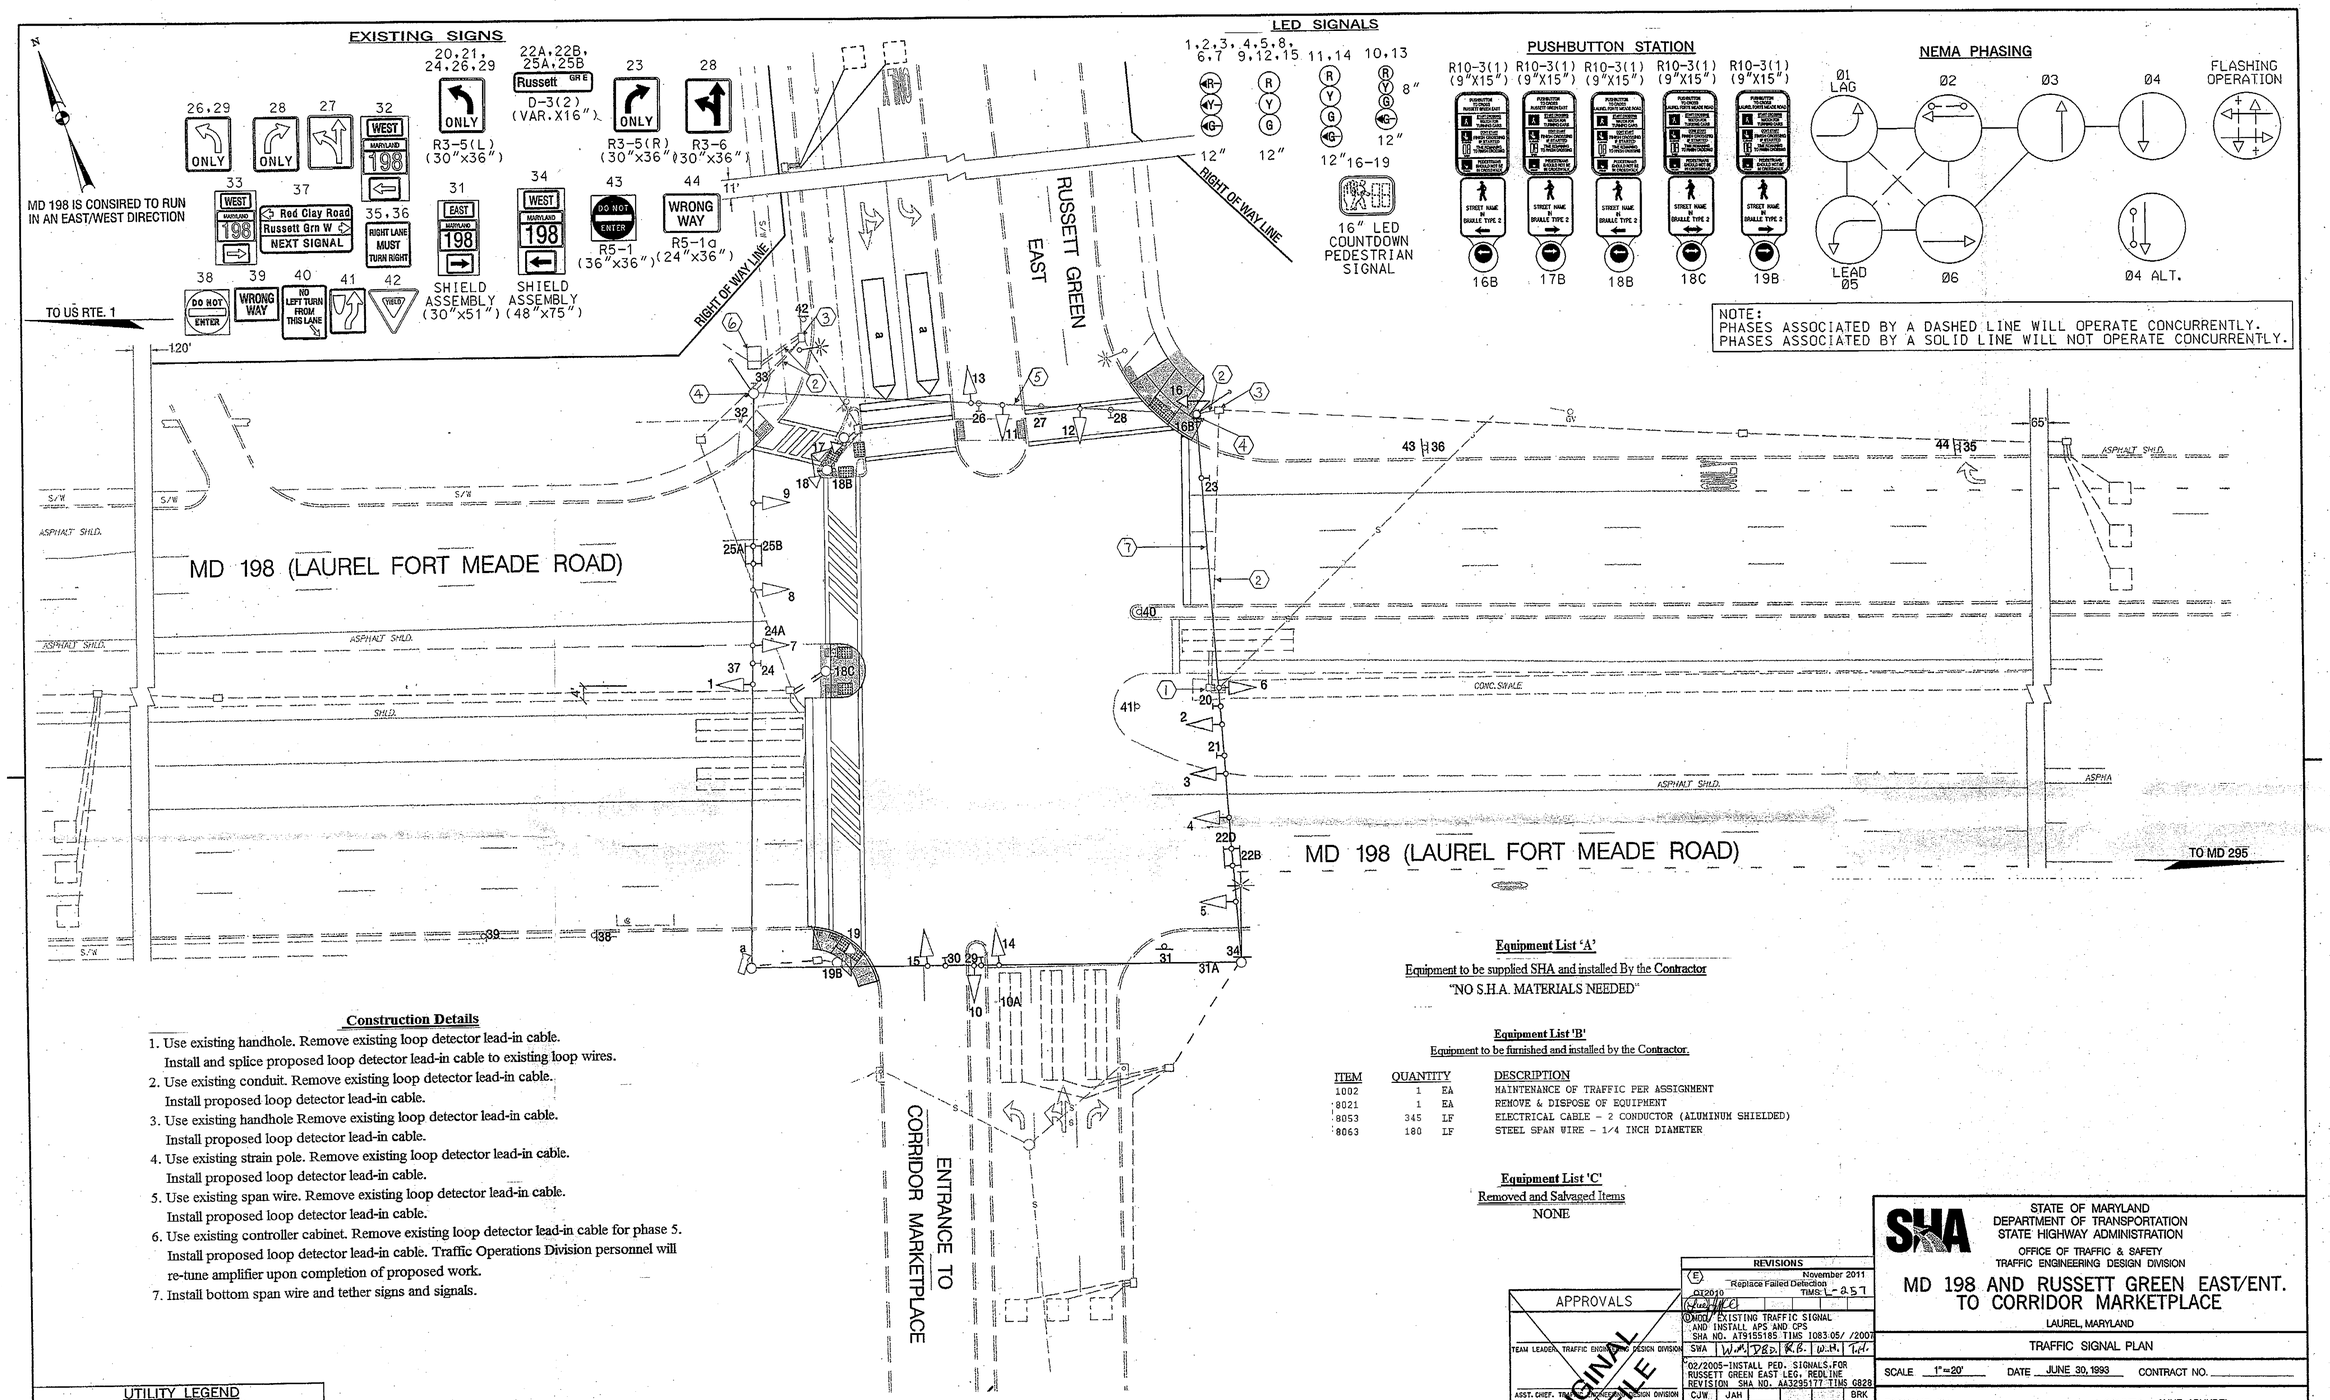

Construction Details

1. Use existing handhole. Remove existing loop detector lead-in cable. Install and splice proposed loop detector lead-in cable to existing loop wires.
2. Use existing conduit. Remove existing loop detector lead-in cable. Install proposed loop detector lead-in cable.
3. Use existing handhole Remove existing loop detector lead-in cable. Install proposed loop detector lead-in cable.
4. Use existing strain pole. Remove existing loop detector lead-in cable. Install proposed loop detector lead-in cable.
5. Use existing span wire. Remove existing loop detector lead-in cable. Install proposed loop detector lead-in cable.
6. Use existing controller cabinet. Remove existing loop detector lead-in cable for phase 5. Install proposed loop detector lead-in cable. Traffic Operations Division personnel will re-tune amplifier upon completion of proposed work.
7. Install bottom span wire and tether signs and signals.

Equipment List 'A'

Equipment to be supplied SHA and installed By the Contractor

"NO S.H.A. MATERIALS NEEDED"

Equipment List 'B'

Equipment to be furnished and installed by the Contractor.

ITEM	QUANTITY		DESCRIPTION
1002	1	EA	MAINTENANCE OF TRAFFIC PER ASSIGNMENT
8021	1	EA	REMOVE & DISPOSE OF EQUIPMENT
8053	345	LF	ELECTRICAL CABLE - 2 CONDUCTOR (ALUMINUM SHIELDED)
8063	180	LF	STEEL SPAN WIRE - 1/4 INCH DIAMETER

Equipment List 'C'

Removed and Salvaged Items

NONE

UTILITY LEGEND

SD	STORM DRAIN
G	GAS MAIN
W	WATER MAIN
S	SEWER MAIN
E	ELECTRIC CABLES
A	AERIAL CABLES
T	TELEPHONE CABLES

BY: SSMITH

SABRA, WANG & ASSOCIATES, INC.
1504 JOH AVENUE
SUITE 160
BALTIMORE, MD 21227
(410) 737-6564
WWW.SABRA-WANG.COM

APPROVALS

TEAM LEADER, TRAFFIC ENGINEERING DESIGN DIVISION

ASST. CHIEF, TRAFFIC ENGINEERING DESIGN DIVISION

CHIEF, TRAFFIC ENGINEERING DESIGN DIVISION

DIRECTOR, OFFICE OF TRAFFIC & SAFETY

ORIGINAL ON FILE

REVISIONS

(E) November 2011 — Replace Failed Detection — OT2010 — TIMS: L-257

(D) MOD/ EXISTING TRAFFIC SIGNAL AND INSTALL APS AND CPS — SHA NO. AT9155185 TIMS 1083.05/ /2007 — SWA | W.W. | DBD | K.B. | W.H. | T.H.

(C) 02/2005-INSTALL PED. SIGNALS.FOR RUSSETT GREEN EAST LEG. REDLINE REVISION SHA NO. AA3235177 TIMS 0828 — CJW | JAH | BRK

(B) 03/2001 - AS BUILT: INSTALL PEDS, PUSHBUTTONS, PAVEMENT MARKINGS FOR LEG OF MD 198 - SHA OT-2000 — W.M. | MAR | DAZ | BRK | T.H.

(A) 06-16-1995 - MODIFICATION FOR ENT. TO CORRIDIR MARKETPLACE SHA NO. BW 862-802-512 — A.A. | S.R. | DAZ | BAK | T.H.

STATE OF MARYLAND
DEPARTMENT OF TRANSPORTATION
STATE HIGHWAY ADMINISTRATION
OFFICE OF TRAFFIC & SAFETY
TRAFFIC ENGINEERING DESIGN DIVISION

MD 198 AND RUSSETT GREEN EAST/ENT. TO CORRIDOR MARKETPLACE

LAUREL, MARYLAND

TRAFFIC SIGNAL PLAN

SCALE 1"=20' DATE JUNE 30, 1993 CONTRACT NO.

DESIGNED BY
DRAWN BY P. DORR
CHECKED BY S.A.R.
F.A.P. NO. N/A

COUNTY ANNE ARUNDEL
LOGMILE 02019801.69
T.I.M.S. NO.
TOD NO.

TS NO. 3150E | DRAWING 1 OF 1 | SHEET NO. 1 OF 1