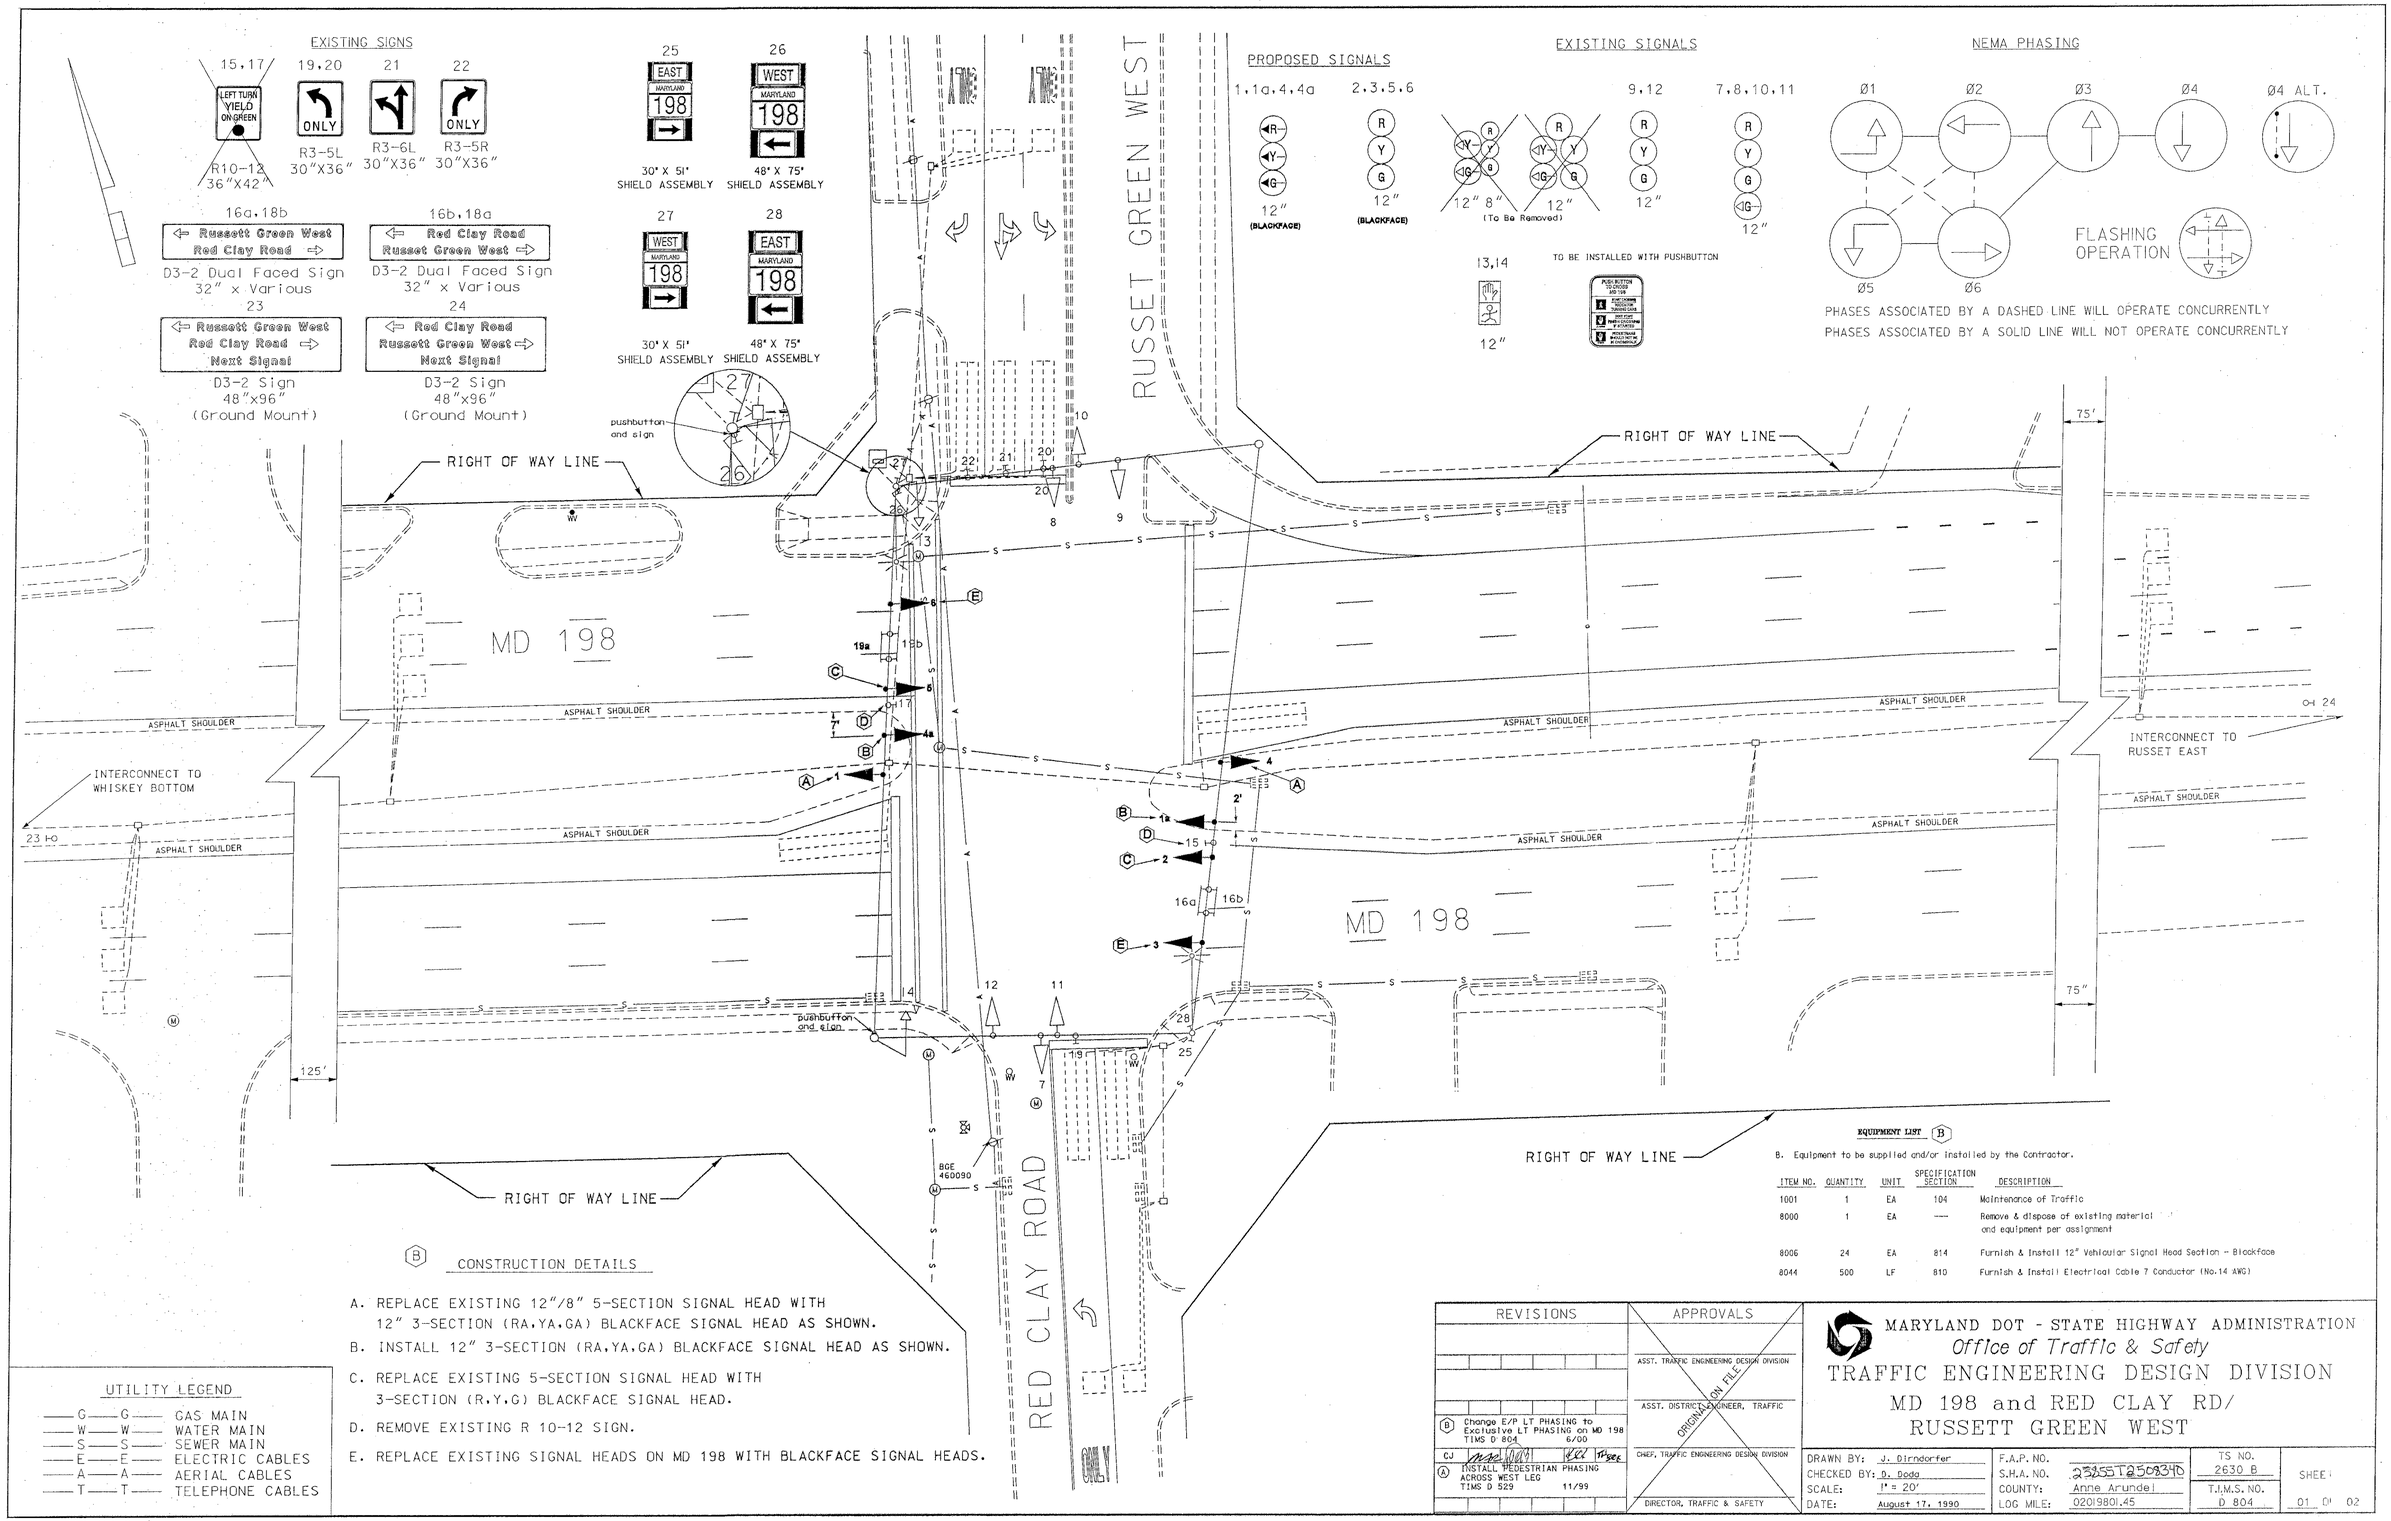

CONSTRUCTION DETAILS

A. REPLACE EXISTING 12"/8" 5-SECTION SIGNAL HEAD WITH 12" 3-SECTION (RA,YA,GA) BLACKFACE SIGNAL HEAD AS SHOWN.

B. INSTALL 12" 3-SECTION (RA,YA,GA) BLACKFACE SIGNAL HEAD AS SHOWN.

C. REPLACE EXISTING 5-SECTION SIGNAL HEAD WITH 3-SECTION (R,Y,G) BLACKFACE SIGNAL HEAD.

D. REMOVE EXISTING R 10-12 SIGN.

E. REPLACE EXISTING SIGNAL HEADS ON MD 198 WITH BLACKFACE SIGNAL HEADS.

UTILITY LEGEND

G — G	GAS MAIN
W — W	WATER MAIN
S — S	SEWER MAIN
E — E	ELECTRIC CABLES
A — A	AERIAL CABLES
T — T	TELEPHONE CABLES

EQUIPMENT LIST (B)

B. Equipment to be supplied and/or installed by the Contractor.

ITEM NO.	QUANTITY	UNIT	SPECIFICATION SECTION	DESCRIPTION
1001	1	EA	104	Maintenance of Traffic
8000	1	EA	----	Remove & dispose of existing material and equipment per assignment
8006	24	EA	814	Furnish & Install 12" Vehicular Signal Head Section - Blackface
8044	500	LF	810	Furnish & Install Electrical Cable 7 Conductor (No.14 AWG)

REVISIONS	APPROVALS
(B) Change E/P LT PHASING to Exclusive LT PHASING on MD 198 TIMS D 804 6/00	ASST. TRAFFIC ENGINEERING DESIGN DIVISION
CJ (A) INSTALL PEDESTRIAN PHASING ACROSS WEST LEG TIMS D 529 11/99	ASST. DISTRICT ENGINEER, TRAFFIC
	CHIEF, TRAFFIC ENGINEERING DESIGN DIVISION
	DIRECTOR, TRAFFIC & SAFETY

ORIGINAL ON FILE

MARYLAND DOT - STATE HIGHWAY ADMINISTRATION
Office of Traffic & Safety
TRAFFIC ENGINEERING DESIGN DIVISION
MD 198 and RED CLAY RD/
RUSSETT GREEN WEST

DRAWN BY: J. Dirndorfer	F.A.P. NO.	TS NO. 2630 B	SHEET
CHECKED BY: D. Dodd	S.H.A. NO. 0325ST2508340		
SCALE: 1" = 20'	COUNTY: Anne Arundel	T.M.S. NO. D 804	
DATE: August 17, 1990	LOG MILE: 0201980L45		01 OF 02