F.H.W.A. REGION NO.	STATE	FED. AID PROJ. NO.	SHEET NO.	TOTAL SHEETS
3	MD.			

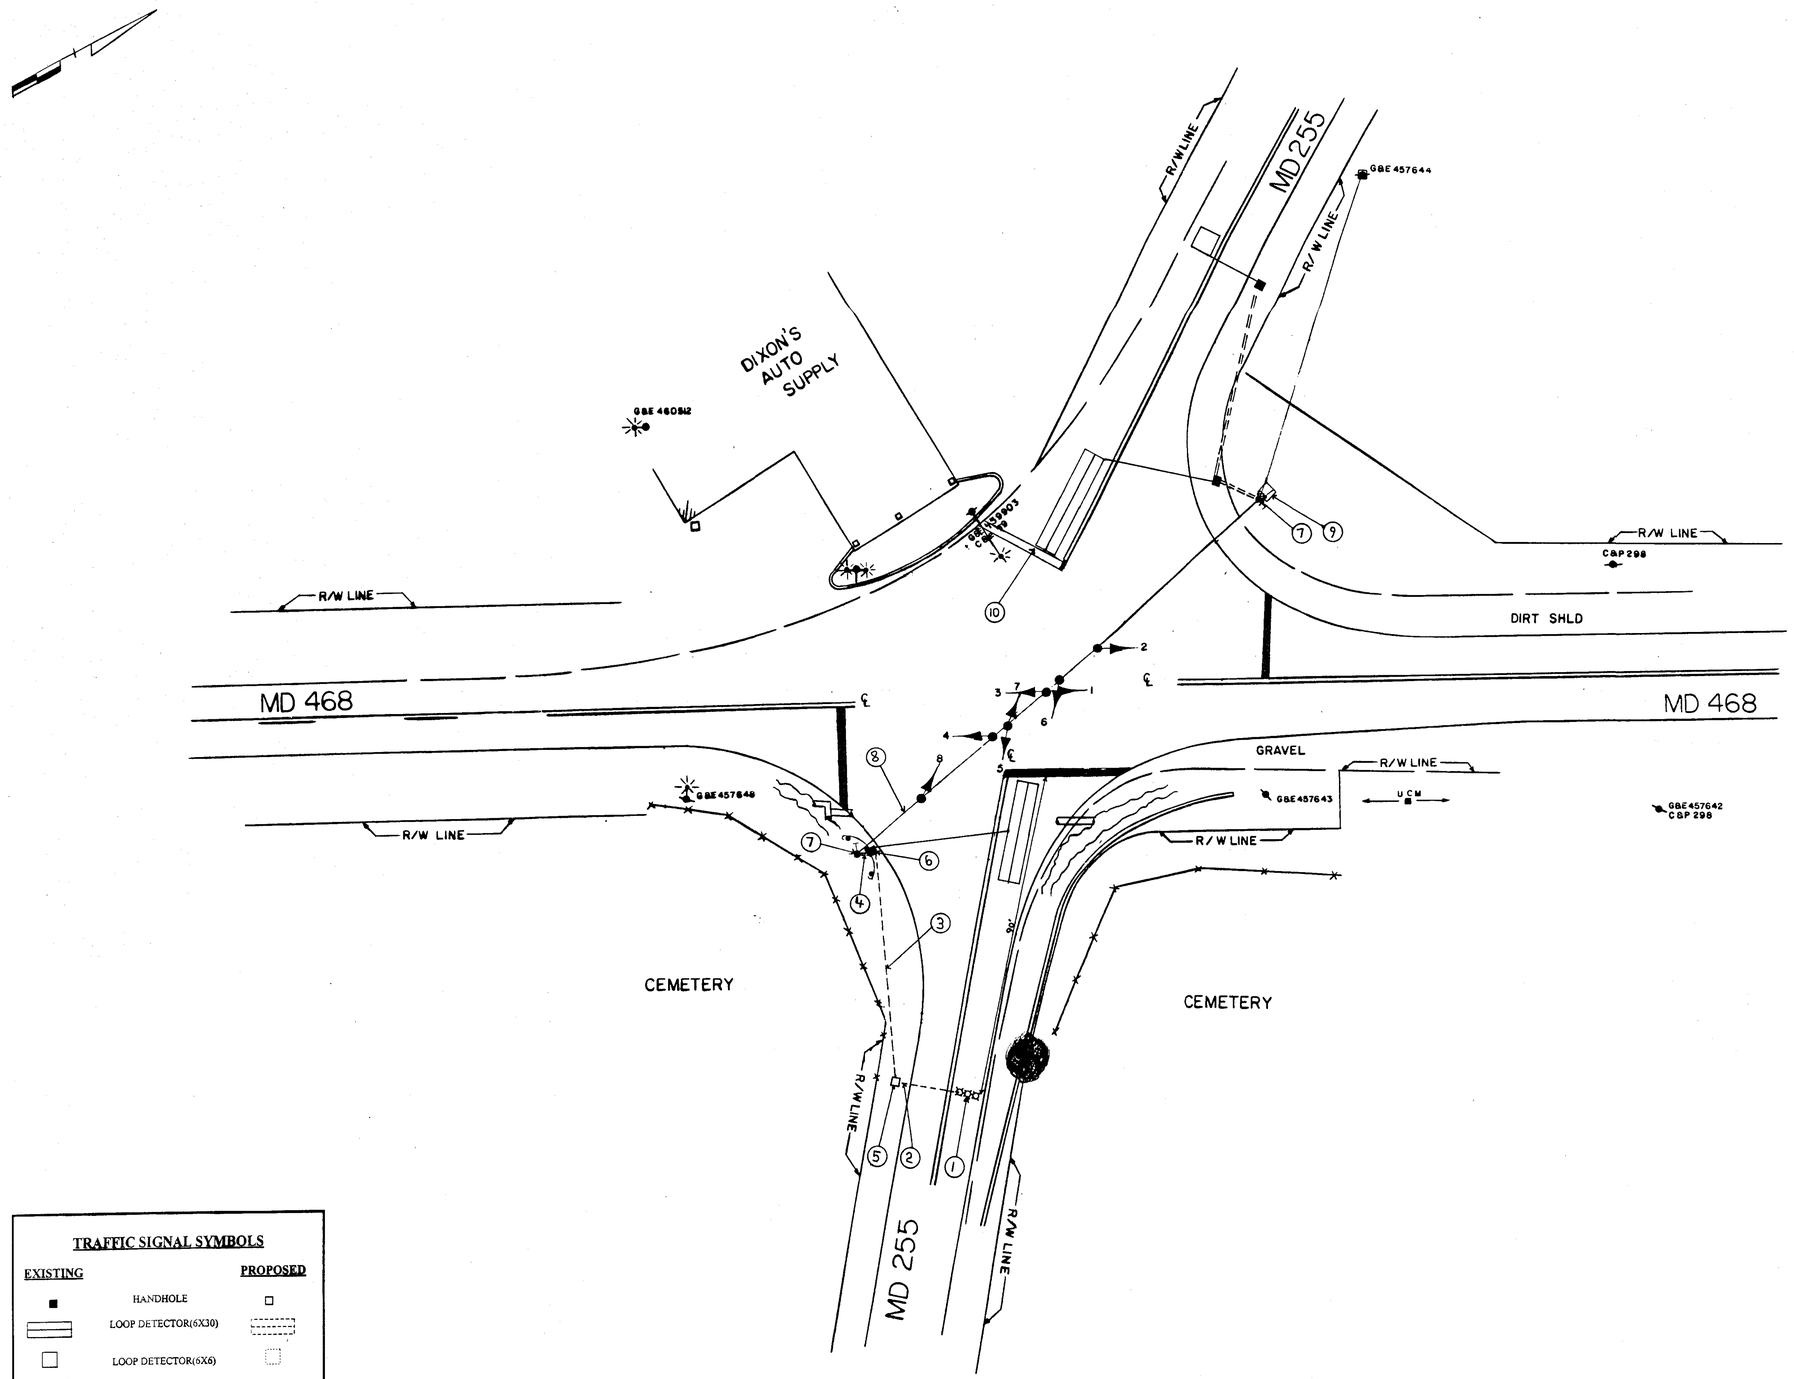

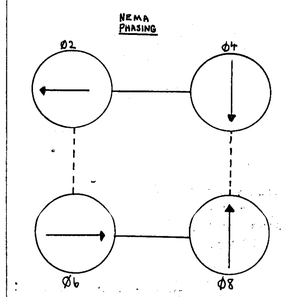

TRAFFIC SIGNAL SYMBOLS

EXISTING		PROPOSED
■	HANDHOLE	□
▭	LOOP DETECTOR(6X30)	▭
□	LOOP DETECTOR(6X6)	⬚
- - - -	CONDUIT	- - - -
✱✱✱	MICRO LOOP PROBE SET	✱✱✱

APPROVAL: REGIONAL TRAFFIC ENGINEER — 6/12/75

APPROVAL: CHIEF-BUREAU OF TRAFFIC ENGINEERING — 6/12/75

APPROVAL: ASS'T. CHIEF ENGINEER TRAFFIC — 6-16-75

B Install Triple-loop Probes
Sign no.: A-090-B-652
Sign no.: A-090-B-653
Sh.A. No.: AW 903-CO
F.A.P. No.: ENG-0900-005418
TMD 8/26/85 — 8/76

A 12-18-78
ASBUILT
AA 972X-000-585
EBA

REVISIONS

STATE OF MARYLAND
DEPARTMENT OF TRANSPORTATION
STATE HIGHWAY ADMINISTRATION

TRAFFIC DIVISION – BUREAU OF TRAFFIC ENGINEERING

MD 468 & MD 255
(GALESVILLE)

SCALE 1" = 20' DATE 4-26-75 CONTRACT NO.

DRAWN BY: DIMITRIOS A ZAFIRIS COUNTY: ANNE ARUNDEL

DESIGNED BY: D DODA 5-8-75 SIGNAL NO.: 02186

CHECKED BY: 6-12-75

DRAWING NO. TS-1307A

BRUNING 44.511 19927