FHWA REGION NO.	STATE	FED. AID PROJ. NO.	SHEET NO.	TOTAL SHEETS
3	MD			

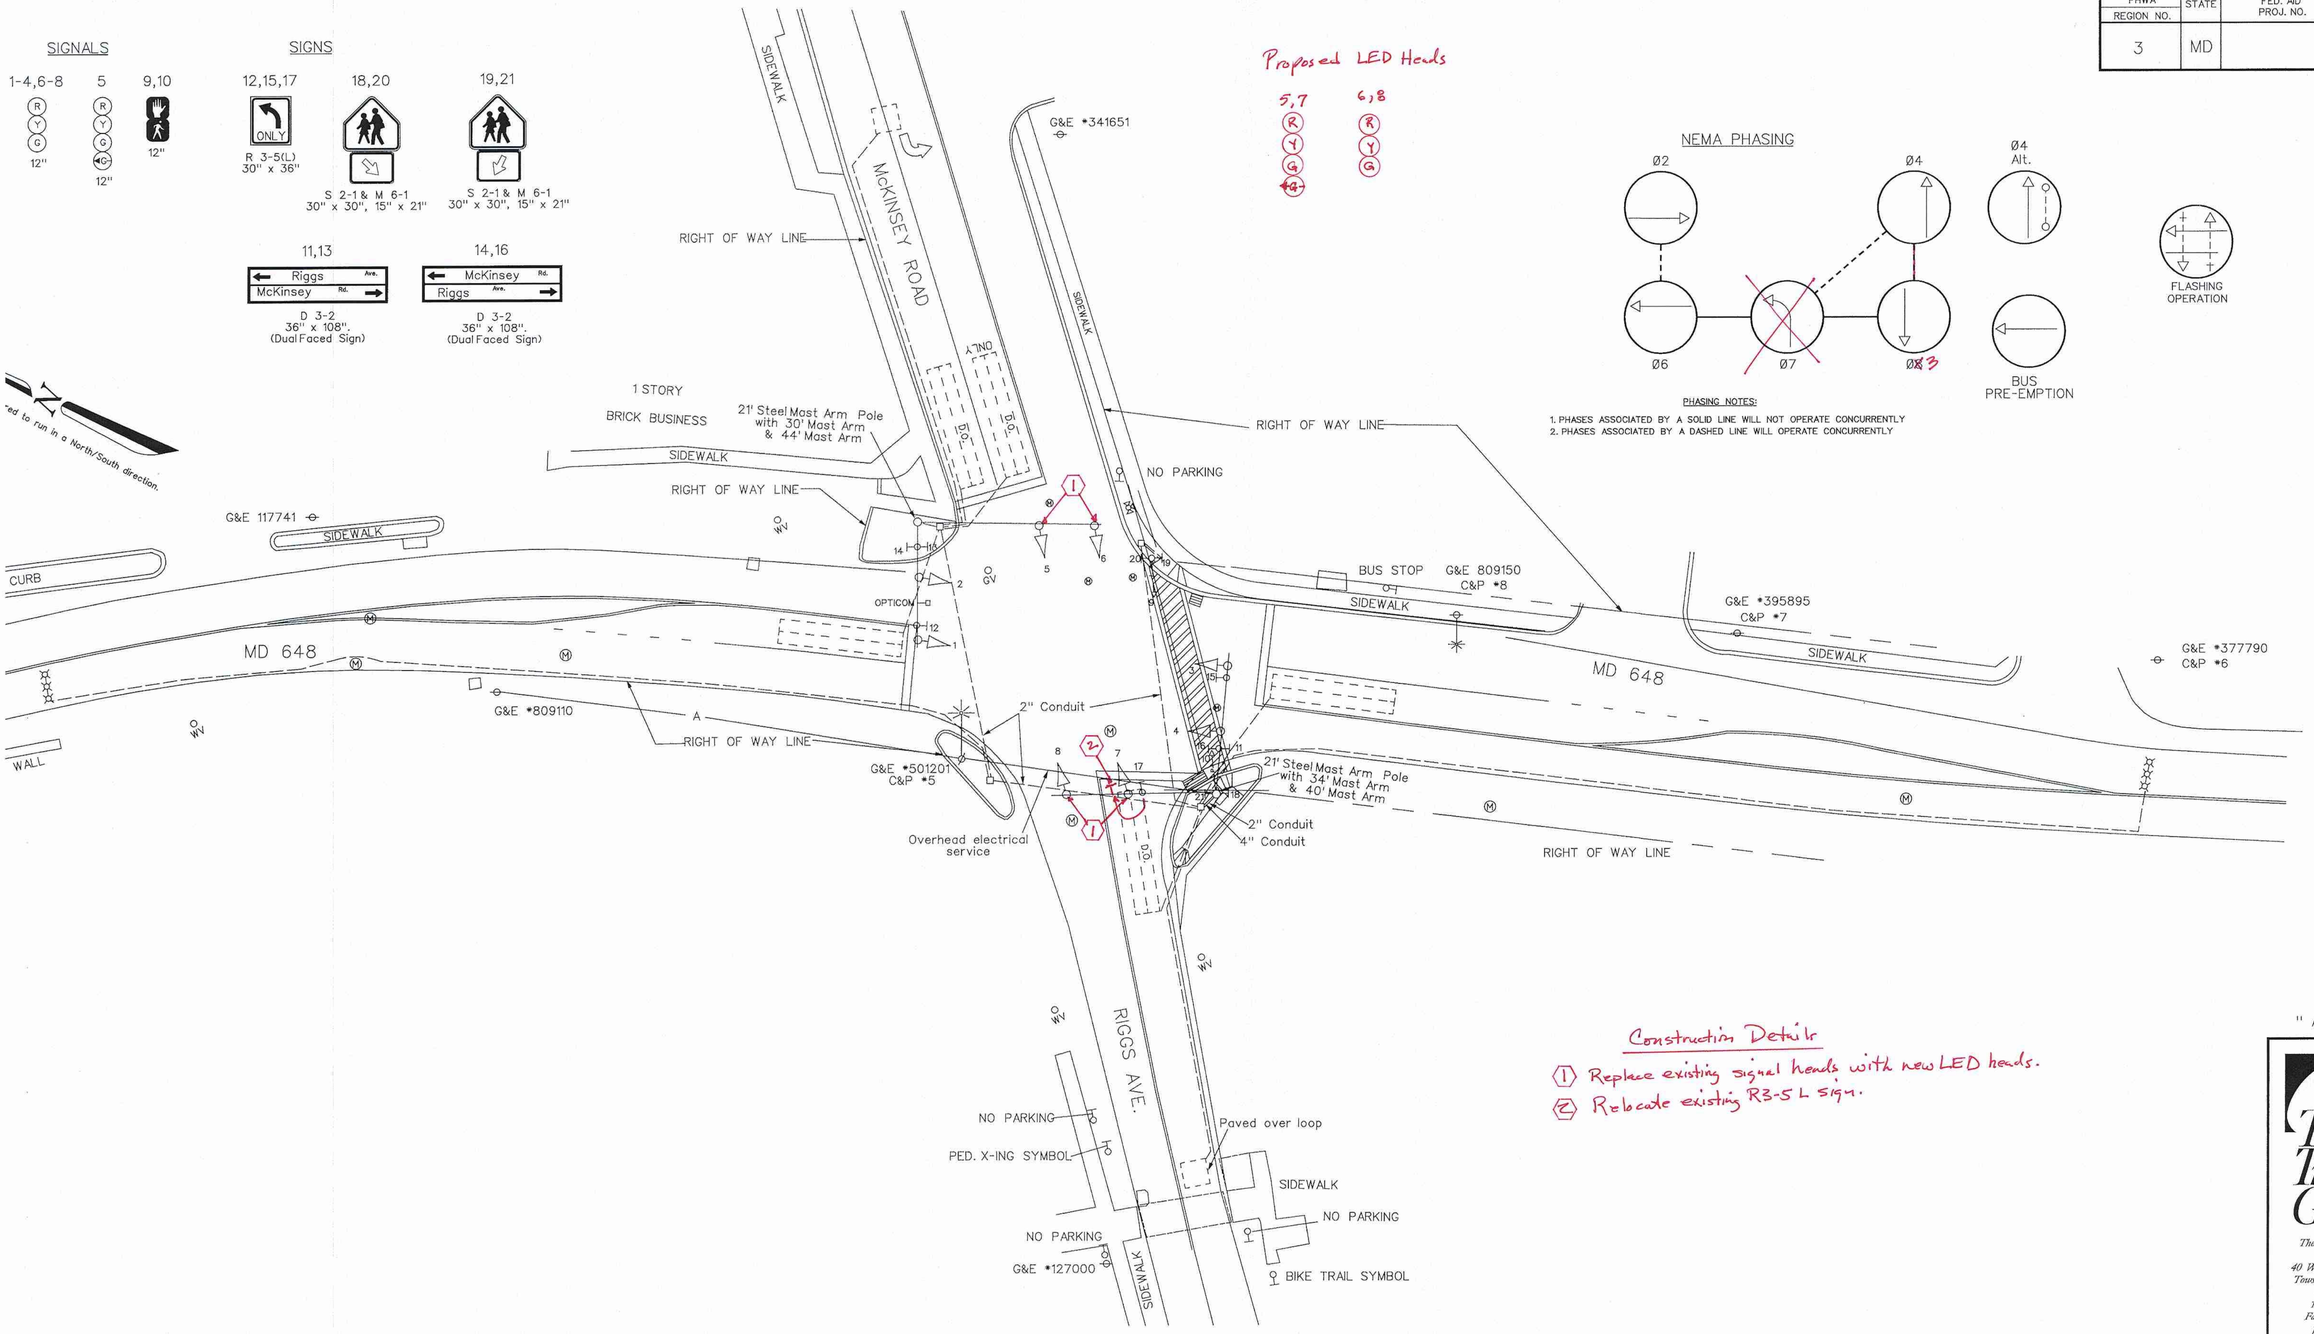

Construction Details

1. Replace existing signal heads with new LED heads.
2. Relocate existing R3-5 L sign.

" AS-BUILT "

The Traffic Group
The Traffic Group, Inc.
Suite 600
40 W. Chesapeake Avenue
Towson, Maryland 21204
410-583-8405
1-800-583-8411
Fax 410-321-8458
Job. No. 960709
ASBUILT.DGN

GEOMETRIC LEGEND

EXISTING GEOMETRICS
PROPOSED GEOMETRICS

UTILITY LEGEND

G	GAS MAIN
W	WATER MAIN
S	SEWER MAIN
E	ELECTRIC CABLES
D	STORM DRAIN
A	AERIAL CABLES
T	TELEPHONE CABLES

REVISIONS

(E) 3 split side street phasing. 8-30-10

DJD

(D) October 7, 1996
ASBUILT
S.H.A. NO. 855-2507057
FJH

APPROVALS

ASST. DIVISION CHIEF TRAFFIC ENGINEERING DESIGN DIVISION

CHIEF, TRAFFIC ENGINEERING DESIGN DIVISION

ASST. DISTRICT ENGINEER - TRAFFIC

DIRECTOR, OFFICE OF TRAFFIC & SAFETY

ORIGINAL ON FILE

MDOT – STATE HIGHWAY ADMINISTRATION
Office of Traffic & Safety
TRAFFIC ENGINEERING DESIGN DIVISION

DRAWN BY: J. SPENCE
DES. BY:
CHK. BY:

(Traffic Signal Plan)
MD 648 & McKinsey Road / Riggs Avenue
COUNTY: ANNE ARUNDEL
LOG MILE * 02064803.63

DATE: February 2, 1987
SCALE: 1" = 20'
F.A.P. NO. N/A
S.H.A. NO. 855-25057057
TS/STD. NO. 305D RE
SHEET NO. 1 of 1