F H W A REGION NO.	STATE	FED. AID PROJ. NO.	SHEET NO.	TOTAL SHEETS
3	MD			

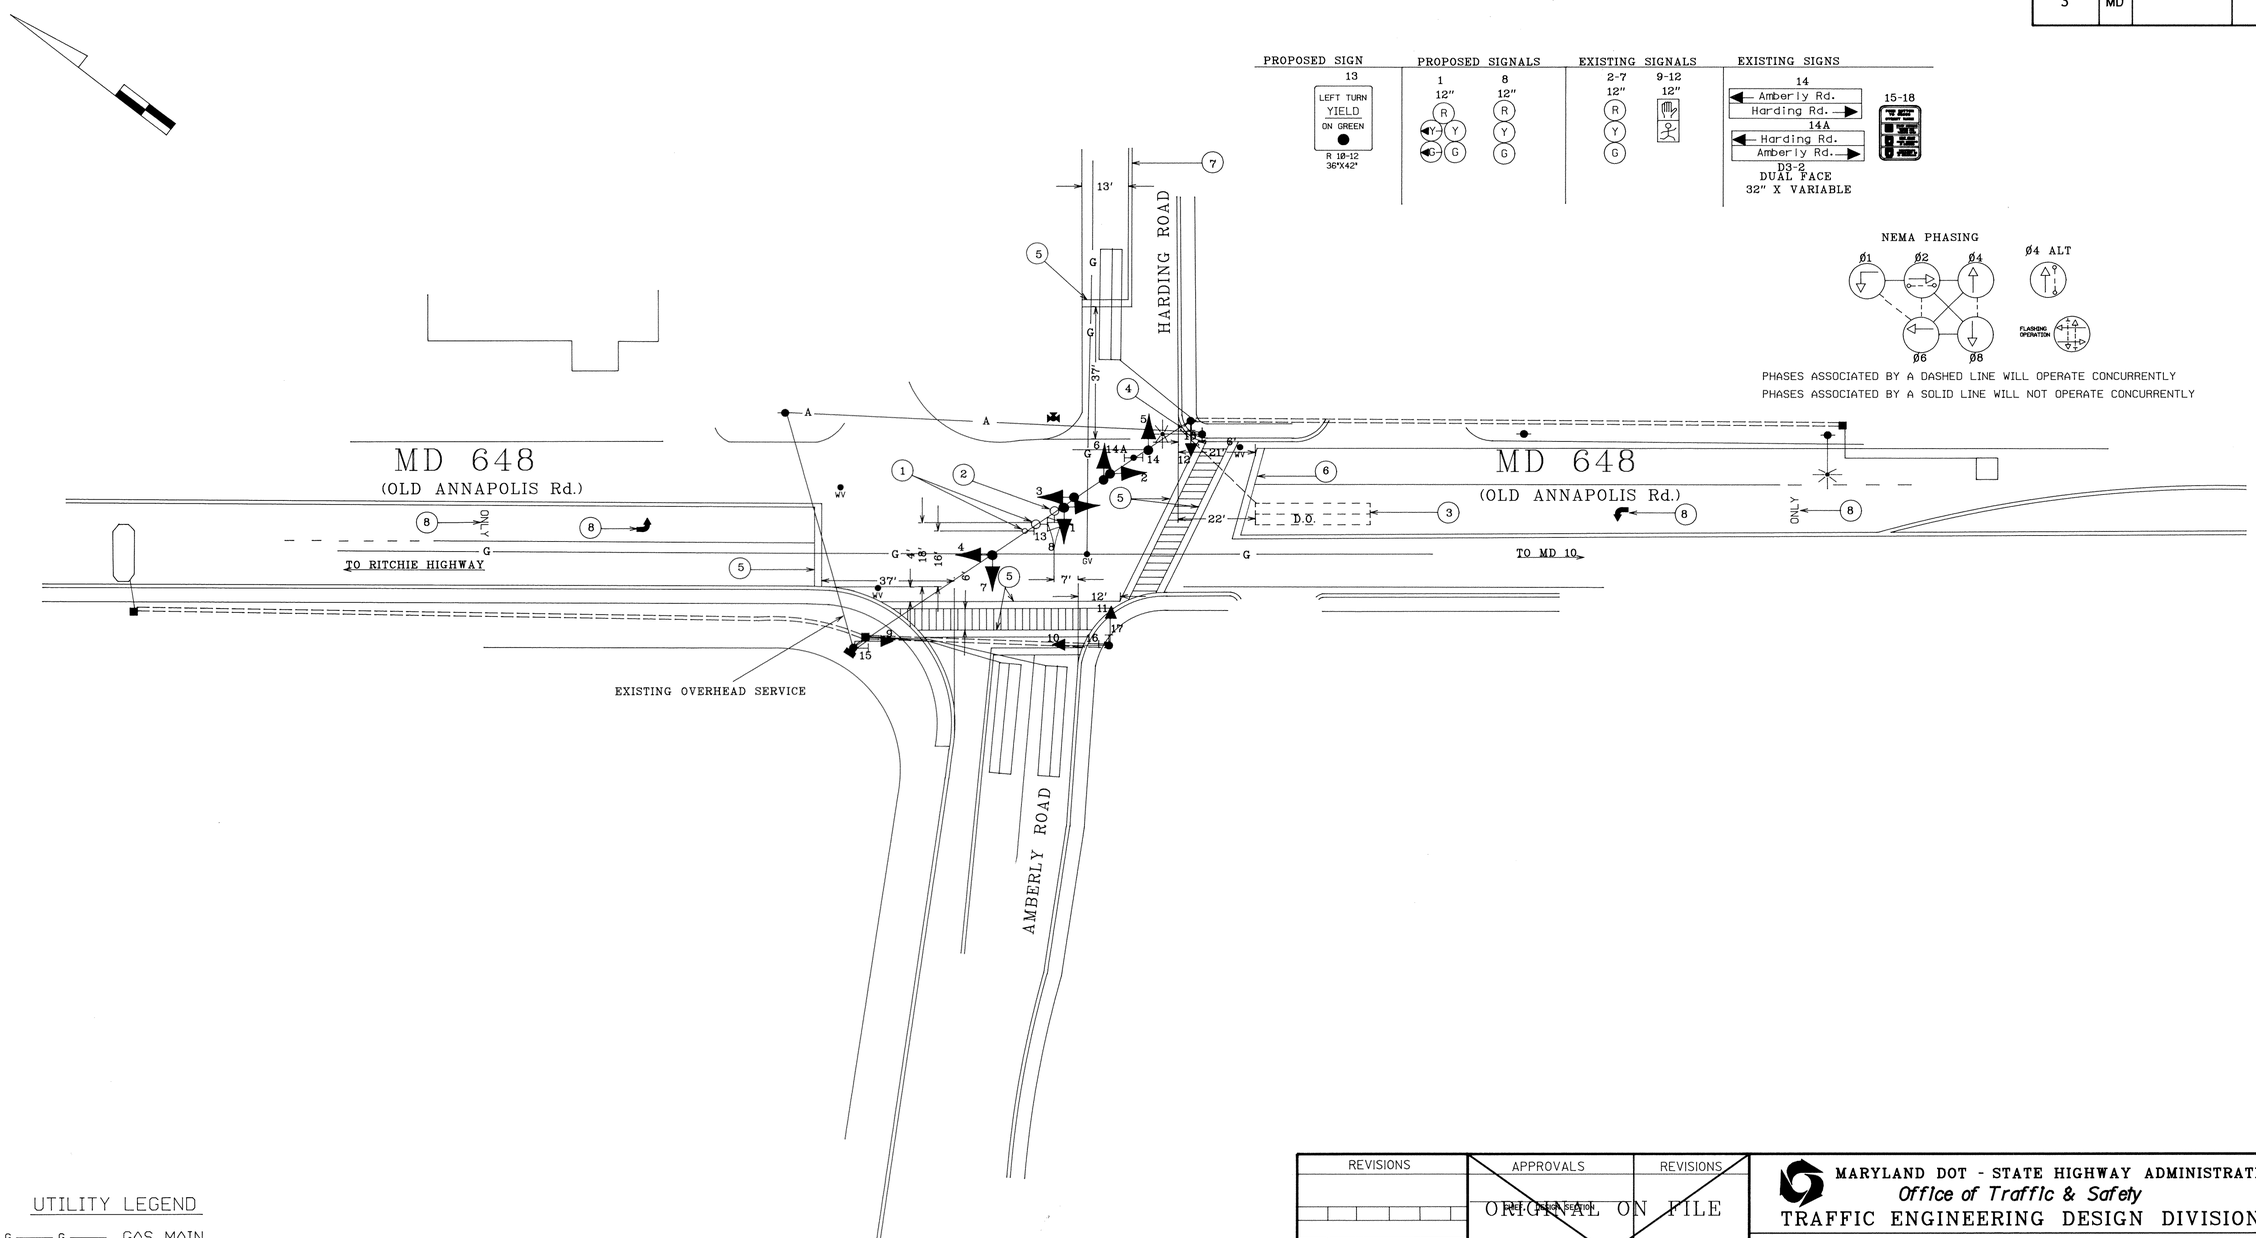

UTILITY LEGEND

—— G —— G ——	GAS MAIN
—— W —— W ——	WATER MAIN
—— S —— S ——	SEWER MAIN
—— E —— E ——	ELECTRIC CABLES
—— A —— A ——	AERIAL CABLES
—— T —— T ——	TELEPHONE CABLES

REVISIONS	APPROVALS	REVISIONS
6/93 NB INSTALL E/P LEFT-TURN FOR NB MD 648	CHIEF, DESIGN SECTION	
7/13/76 ABBUILT & ADDITION OF FED P.B.S ON AMBERLY AA-966X-000-585	ASST. DISTRICT ENGINEER, TRAFFIC	
DCD	CHIEF, TRAFFIC ENGINEERING DESIGN DIVISION	
	DIRECTOR, TRAFFIC & SAFETY	

ORIGINAL ON FILE
DATED 3/31/75

MARYLAND DOT - STATE HIGHWAY ADMINISTRATION
Office of Traffic & Safety
TRAFFIC ENGINEERING DESIGN DIVISION

MD 648 AND AMBERLY Rd/HARDING Rd

ORIGINAL
DRAWN BY: D. DODA
CHECK BY: A. BUDNICHUK
SCALE: 1" = 20'

F.A.P. NO.
S.H.A. NO.
COUNTY ANNE ARUNDEL

TS-1191 (B)

___ OF ___

F#9

02E64802.46