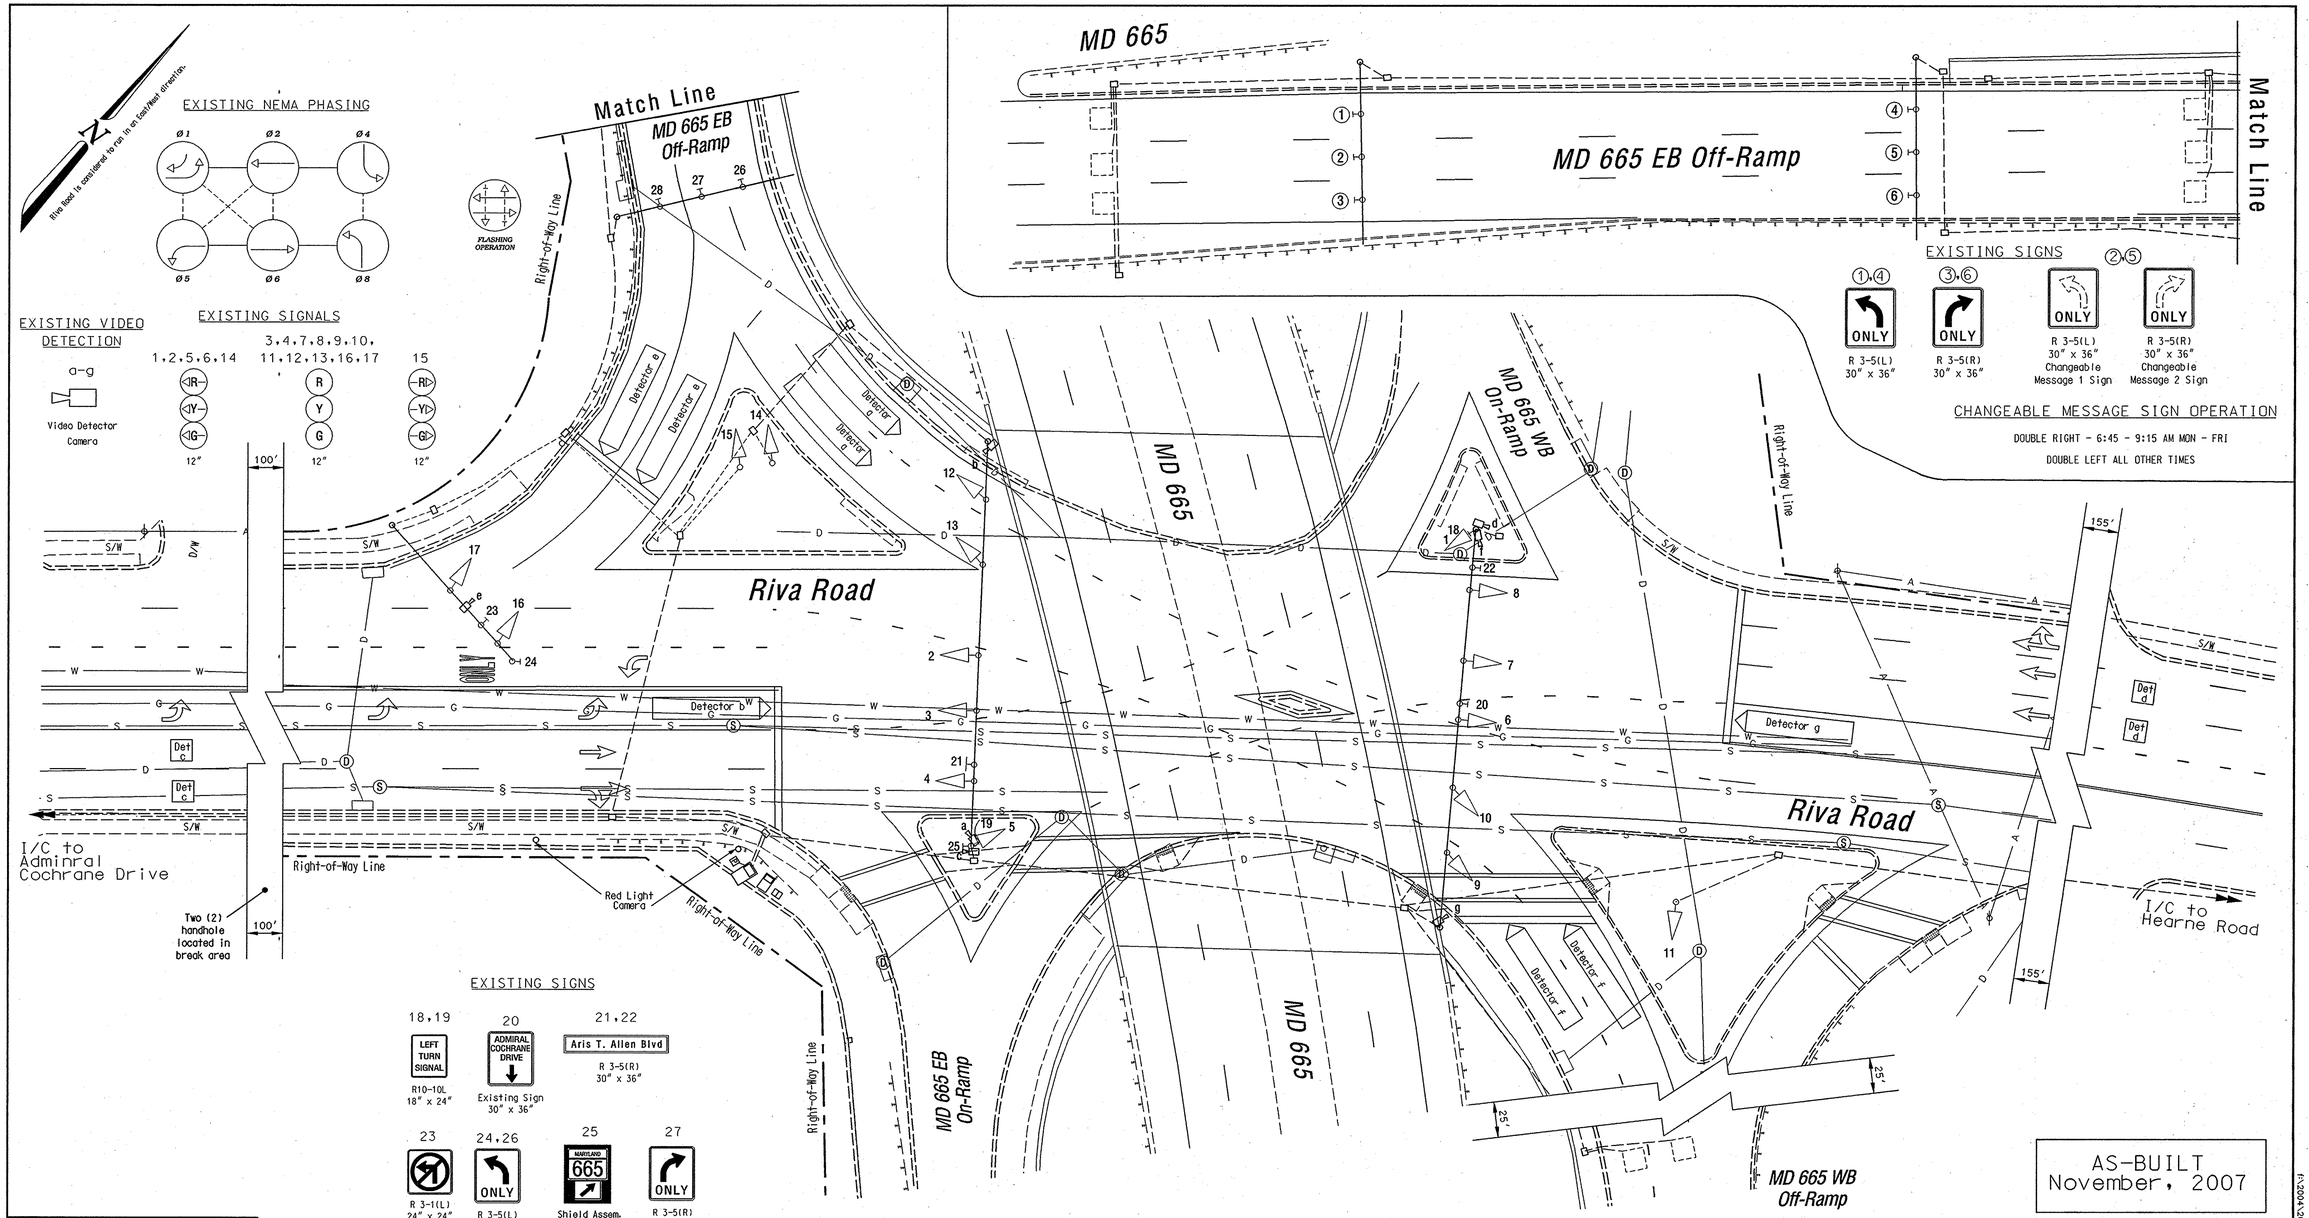

GEOMETRIC LEGEND

- EXISTING GEOMETRICS
- PROPOSED GEOMETRICS

UTILITY LEGEND

G	GAS MAIN
W	WATER MAIN
S	SEWER MAIN
E	ELECTRIC CABLES
D	STORM DRAIN
A	AERIAL CABLES
T	TELEPHONE CABLES

Revision 'D'

The Traffic Group

The Traffic Group, Inc.
410-931-6600
Fax 410-931-6601

REVISIONS

D	Install video detection equip. due to geometric changes and mill and overlay S.H.A. No.:BW996M82				10/03/06
FDB					
C	Signalize SB MD 665 ramp right turn movement S.H.A. No.:BW996M82				02/08/05
TMZ	SMH	MAR	WH	TH	
B	Install nearside sig. hds., pedestal poles and assoc. equip. for MD 665 ramps S.H.A. No.:BW996M82				02/08/90
DJD					

APPROVALS

TEAM LEADER, TRAFFIC ENGINEERING DESIGN DIVISION

ASST. CHIEF TRAFFIC ENGINEERING DESIGN DIVISION

CHIEF, TRAFFIC ENGINEERING DESIGN DIVISION

DIRECTOR, TRAFFIC & SAFETY

ORIGINAL ON FILE

MARYLAND DOT - STATE HIGHWAY ADMINISTRATION
Office of Traffic & Safety
TRAFFIC ENGINEERING DESIGN DIVISION
(Traffic Signal Plan)

MD 665 (Patuxent Boulevard) at Riva Road

DRAWN BY:	JSL	F.A.P. NO.	N/A	TS NO. 2249-D	SHEET NO.
CHECKED BY:	JWH	S.H.A. NO.	AA 309-503-572		
SCALE:	1" = 20'	COUNTY:	Anne Arundel	T.I.M.S. NO. HS 8¾	1 OF 2
DATE:	10/86	LOG MILE:	02066500.93		

F:\2004\2004-0502\dgns\MD 665\ne hwy.dgn 11/21/2007