F.H.W.A. REGION NO.	STATE	FED. AID PROJ. NO.	SHEET NO.	TOTAL SHEETS
3	MD.		217	476

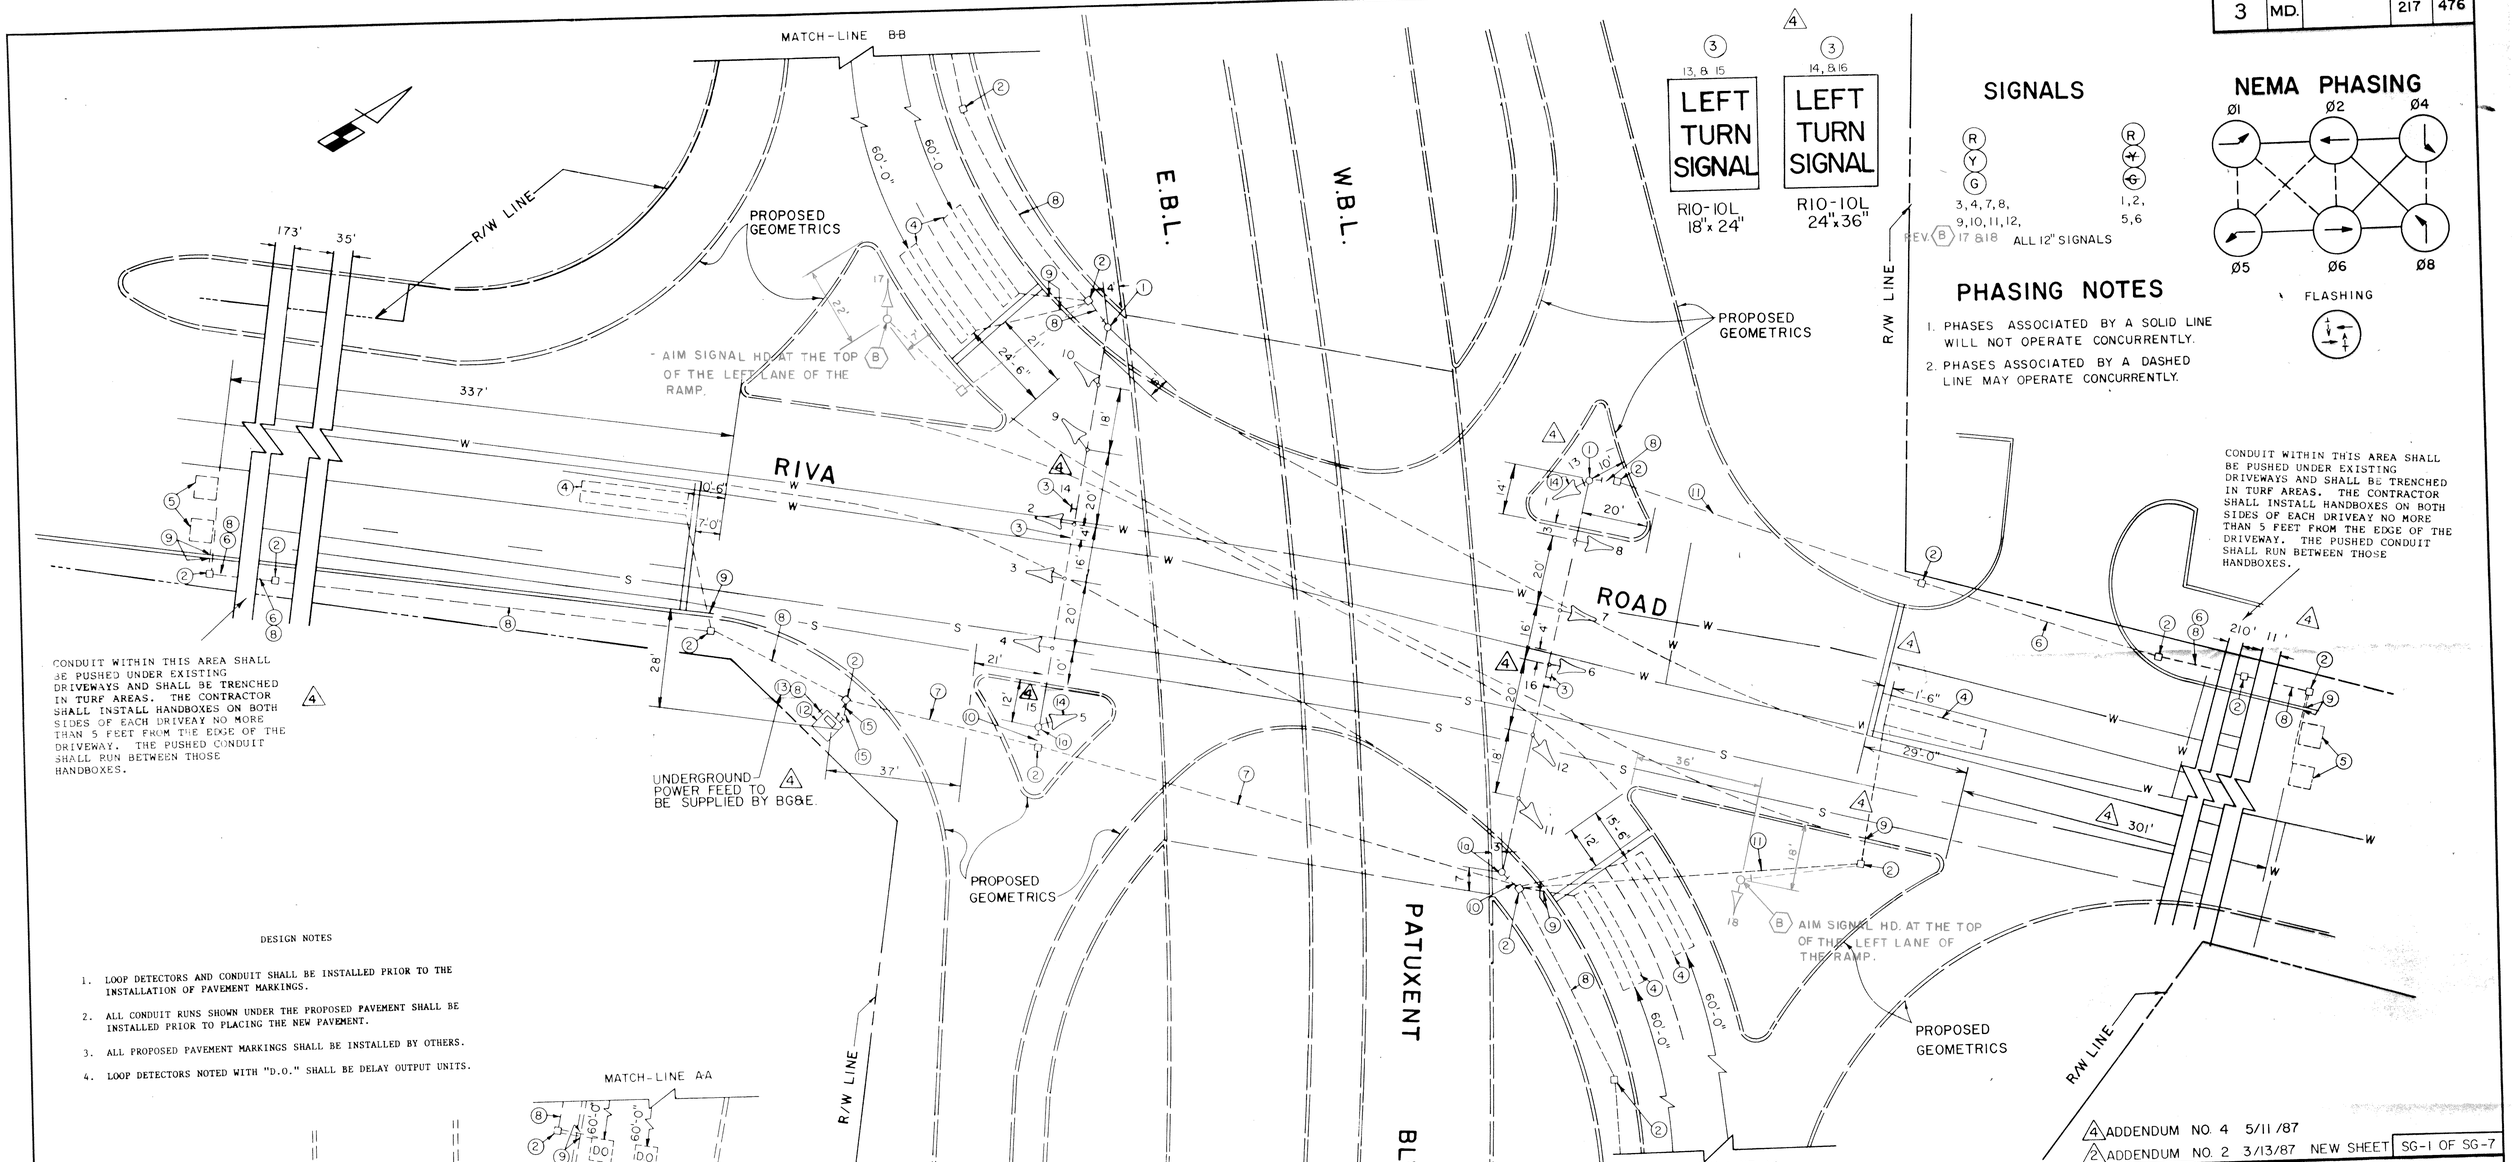

DESIGN NOTES

1. LOOP DETECTORS AND CONDUIT SHALL BE INSTALLED PRIOR TO THE INSTALLATION OF PAVEMENT MARKINGS.
2. ALL CONDUIT RUNS SHOWN UNDER THE PROPOSED PAVEMENT SHALL BE INSTALLED PRIOR TO PLACING THE NEW PAVEMENT.
3. ALL PROPOSED PAVEMENT MARKINGS SHALL BE INSTALLED BY OTHERS.
4. LOOP DETECTORS NOTED WITH "D.O." SHALL BE DELAY OUTPUT UNITS.

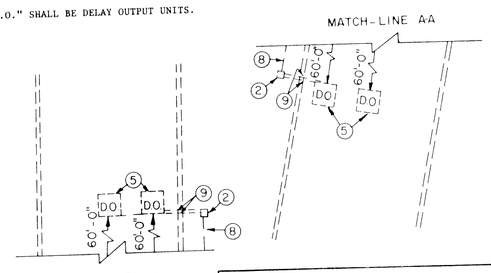

LEGEND OF UNDERGROUND UTILITIES

—G—G—	GAS MAIN
—W—W—	WATER MAIN
—S—S—	SEWER MAIN
—E—E—	ELECTRIC CABLES
—T—T—	TELEPHON CABLES
—A—A—	AERIAL CABLES

ADDENDUM NO. 4 5/11/87
ADDENDUM NO. 2 3/13/87 NEW SHEET SG-1 OF SG-7

KCI/WBCM A JOINT VENTURE
KIDDE CONSULTANTS, INC.
WHITNEY, BAILEY, COX AND MAGNANI
1020 CROMWELL BRIDGE ROAD
TOWSON, MARYLAND 21204
(301) 321-5500

APPROVAL: CHIEF SIGNAL DESIGN SECTION
APPROVAL: ASS'T DISTRICT TRAFFIC ENGINEER
APPROVAL: CHIEF - BUREAU OF TRAFFIC ENGINEERING
APPROVAL: DEPUTY CHIEF ENGINEER OFFICE OF TRAFFIC

REVISIONS
B 2-8-90 INSTALL NEARSIDE SIG. HDS., PEDESTAL POLES & ASSOC. EQUIP. FOR MD 665 RAMPS DJD

STATE OF MARYLAND
DEPARTMENT OF TRANSPORTATION
STATE HIGHWAY ADMINISTRATION
BUREAU OF TRAFFIC ENGINEERING
OFFICE OF TRAFFIC

FINAL SIGNAL DESIGN
PATUXENT BLVD. (MD.665) @ RIVA ROAD
TS-3096

SCALE 1" = 20' DATE 10/86 CONTRACT NO. AA 309-503-572
DRAWN BY: JSL COUNTY: ANNE ARUNDEL
T.S. NO.: 2249 (B)
DESIGNED BY: JWH SIGNAL NO.:
CHECKED BY: TAR

SHEET NO. 217 OF 476

02066500-93