F H W A REGION NO.	STATE	FED. AID PROJ. NO.	SHEET NO.	TOTAL SHEETS
3	MD	SEE BELOW	1	2

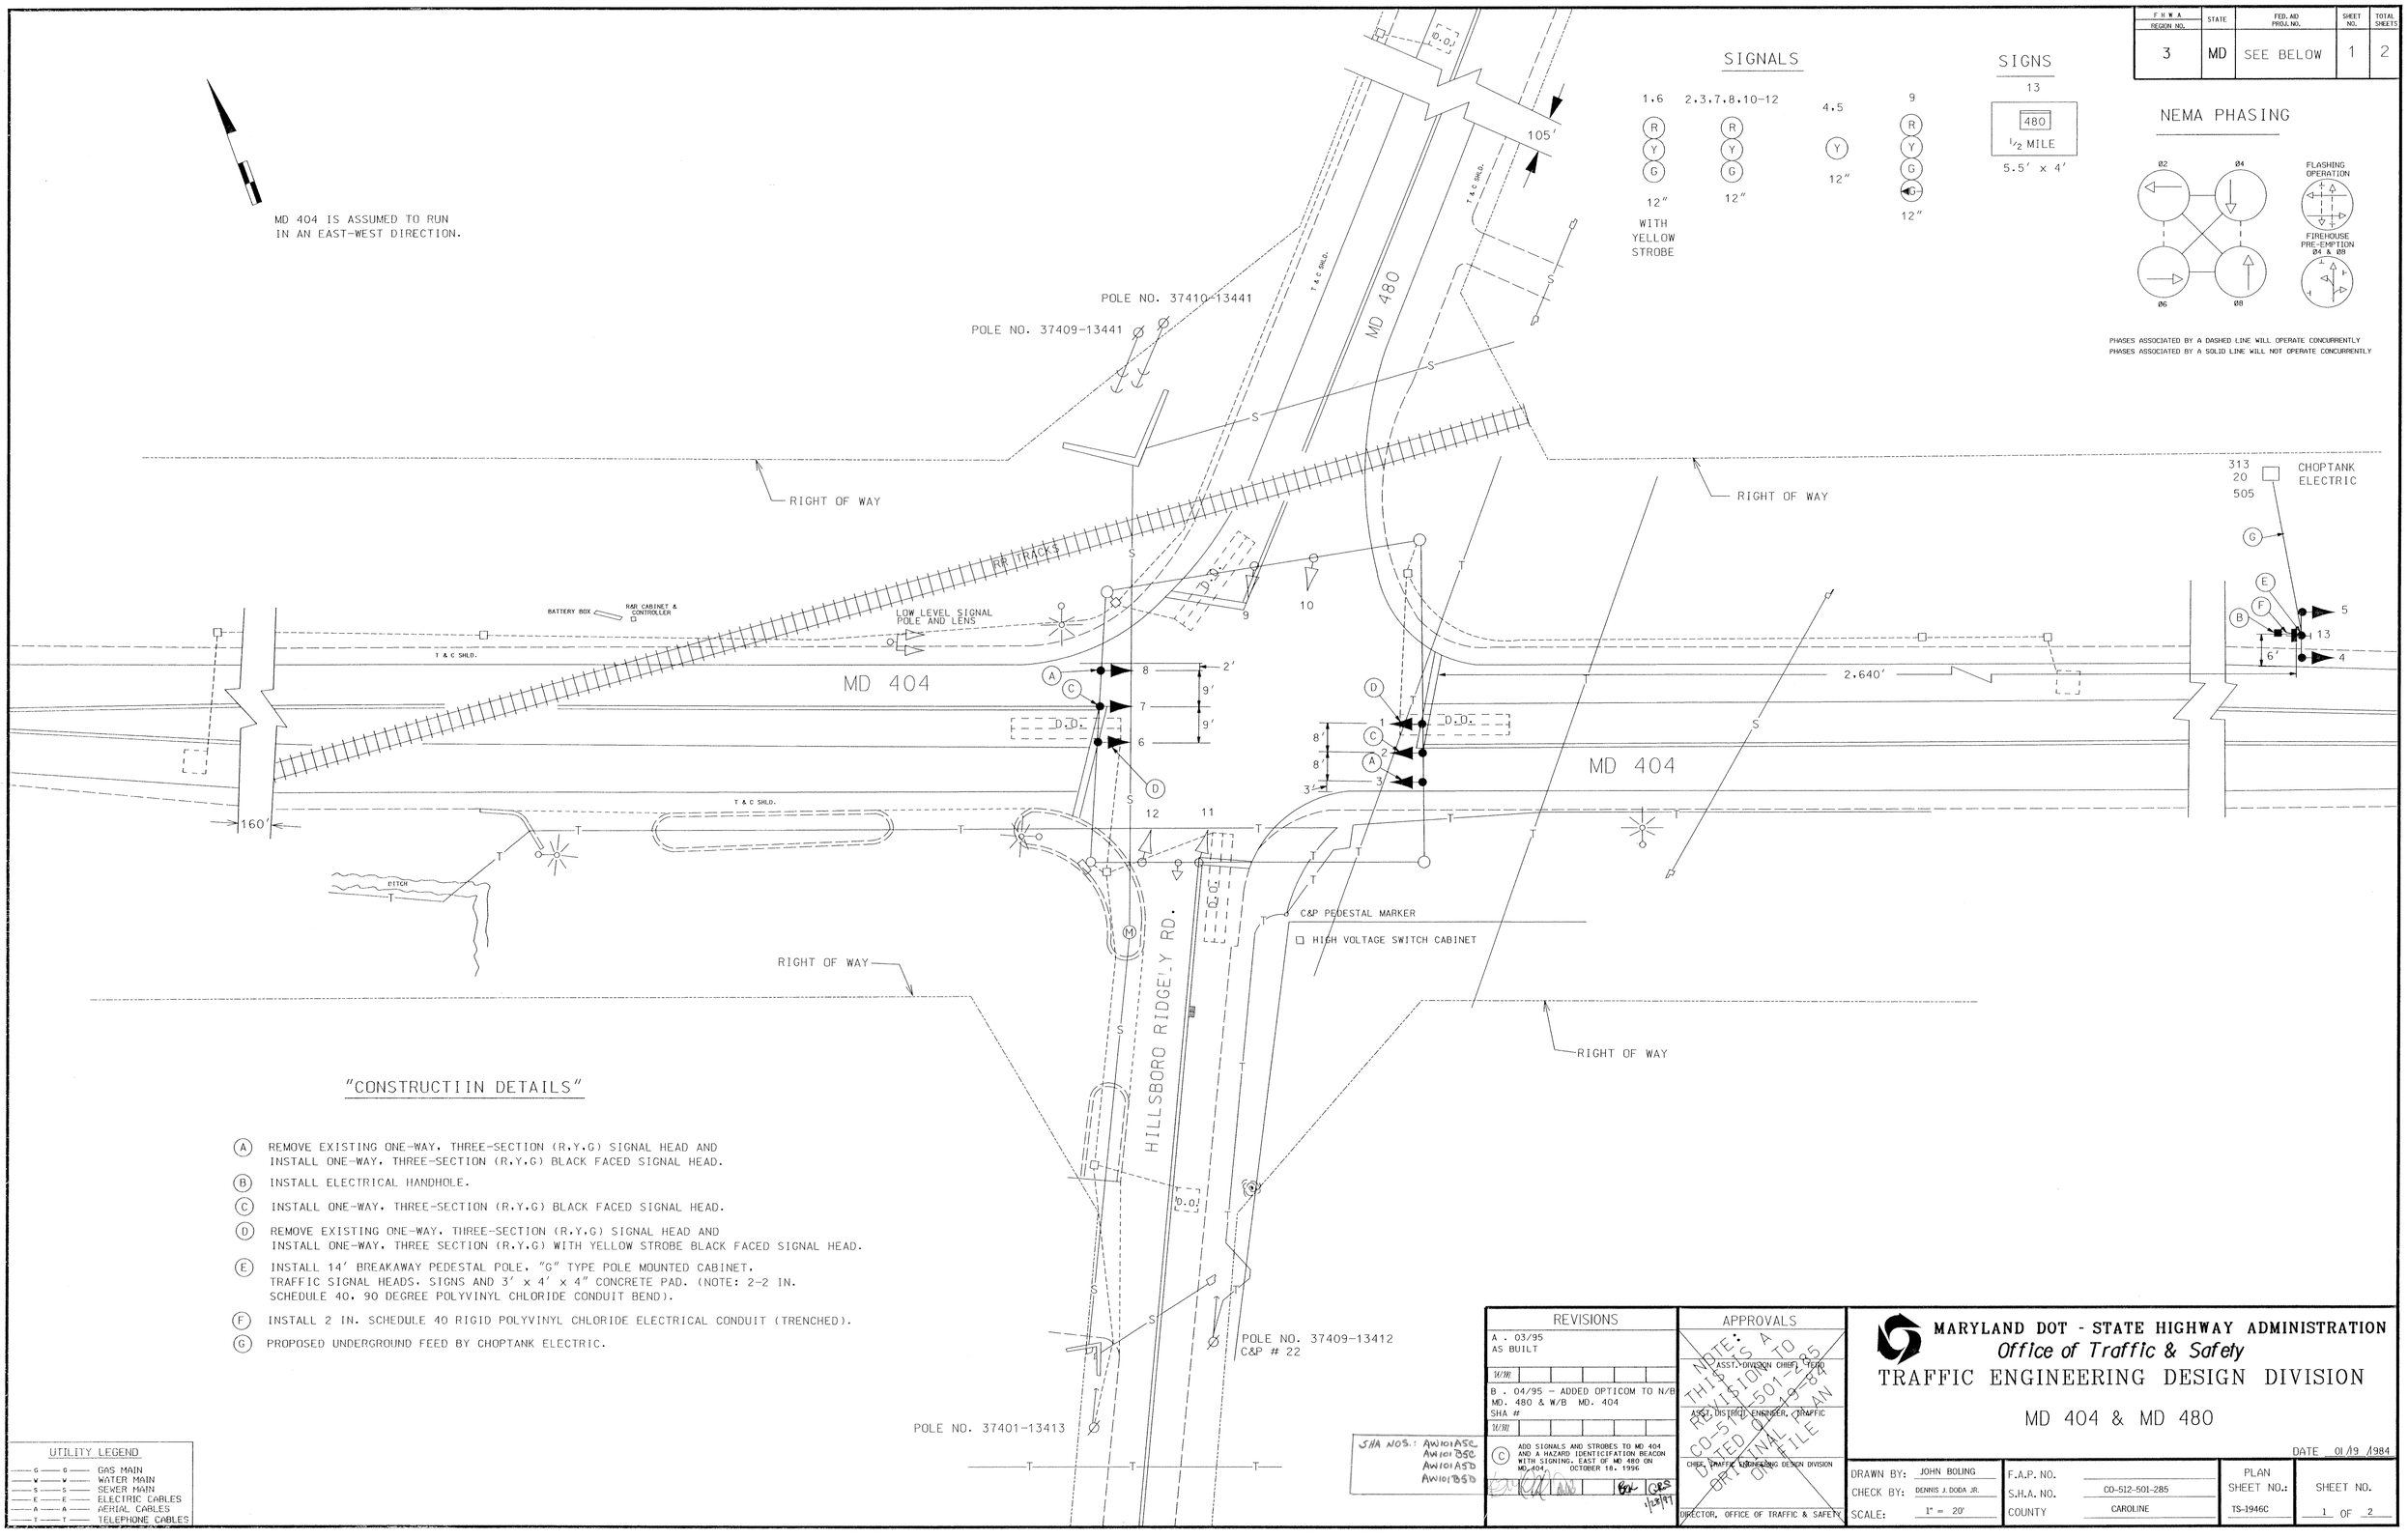

"CONSTRUCTIIN DETAILS"

(A) REMOVE EXISTING ONE-WAY, THREE-SECTION (R,Y,G) SIGNAL HEAD AND INSTALL ONE-WAY, THREE-SECTION (R,Y,G) BLACK FACED SIGNAL HEAD.

(B) INSTALL ELECTRICAL HANDHOLE.

(C) INSTALL ONE-WAY, THREE-SECTION (R,Y,G) BLACK FACED SIGNAL HEAD.

(D) REMOVE EXISTING ONE-WAY, THREE-SECTION (R,Y,G) SIGNAL HEAD AND INSTALL ONE-WAY, THREE SECTION (R,Y,G) WITH YELLOW STROBE BLACK FACED SIGNAL HEAD.

(E) INSTALL 14' BREAKAWAY PEDESTAL POLE, "G" TYPE POLE MOUNTED CABINET, TRAFFIC SIGNAL HEADS, SIGNS AND 3' x 4' x 4" CONCRETE PAD. (NOTE: 2-2 IN. SCHEDULE 40, 90 DEGREE POLYVINYL CHLORIDE CONDUIT BEND).

(F) INSTALL 2 IN. SCHEDULE 40 RIGID POLYVINYL CHLORIDE ELECTRICAL CONDUIT (TRENCHED).

(G) PROPOSED UNDERGROUND FEED BY CHOPTANK ELECTRIC.

UTILITY LEGEND

G	GAS MAIN
W	WATER MAIN
S	SEWER MAIN
E	ELECTRIC CABLES
A	AERIAL CABLES
T	TELEPHONE CABLES

SHA NOS.: AW101ASC, AW101BSC, AW101ASD, AW101BSD

REVISIONS

A . 03/95 AS BUILT

B . 04/95 - ADDED OPTICOM TO N/B MD. 480 & W/B MD. 404 SHA #

(C) ADD SIGNALS AND STROBES TO MD 404 AND A HAZARD IDENTICIFATION BEACON WITH SIGNING, EAST OF MD 480 ON MD 404. OCTOBER 18, 1996

APPROVALS

NOTE: THIS IS A REVISION TO CO-512-501-285 DATED 01-19-84 ORIGINAL PLAN ON FILE

ASST. DIVISION CHIEF, TFDD

ASST. DISTRICT ENGINEER, TRAFFIC

CHIEF, TRAFFIC ENGINEERING DESIGN DIVISION

DIRECTOR, OFFICE OF TRAFFIC & SAFETY

MARYLAND DOT - STATE HIGHWAY ADMINISTRATION

Office of Traffic & Safety

TRAFFIC ENGINEERING DESIGN DIVISION

MD 404 & MD 480

DATE 01/19/1984

DRAWN BY:	JOHN BOLING	F.A.P. NO.		PLAN SHEET NO.:	SHEET NO.
CHECK BY:	DENNIS J. DODA JR.	S.H.A. NO.	CO-512-501-285		
SCALE:	1" = 20'	COUNTY	CAROLINE	TS-1946C	1 OF 2

LOG NO. 05040400.74