F.H.WA REGION NO	STATE	FED. AID PROJ. NO	SHEET NO.	TOTAL SHEETS
3	MD.			

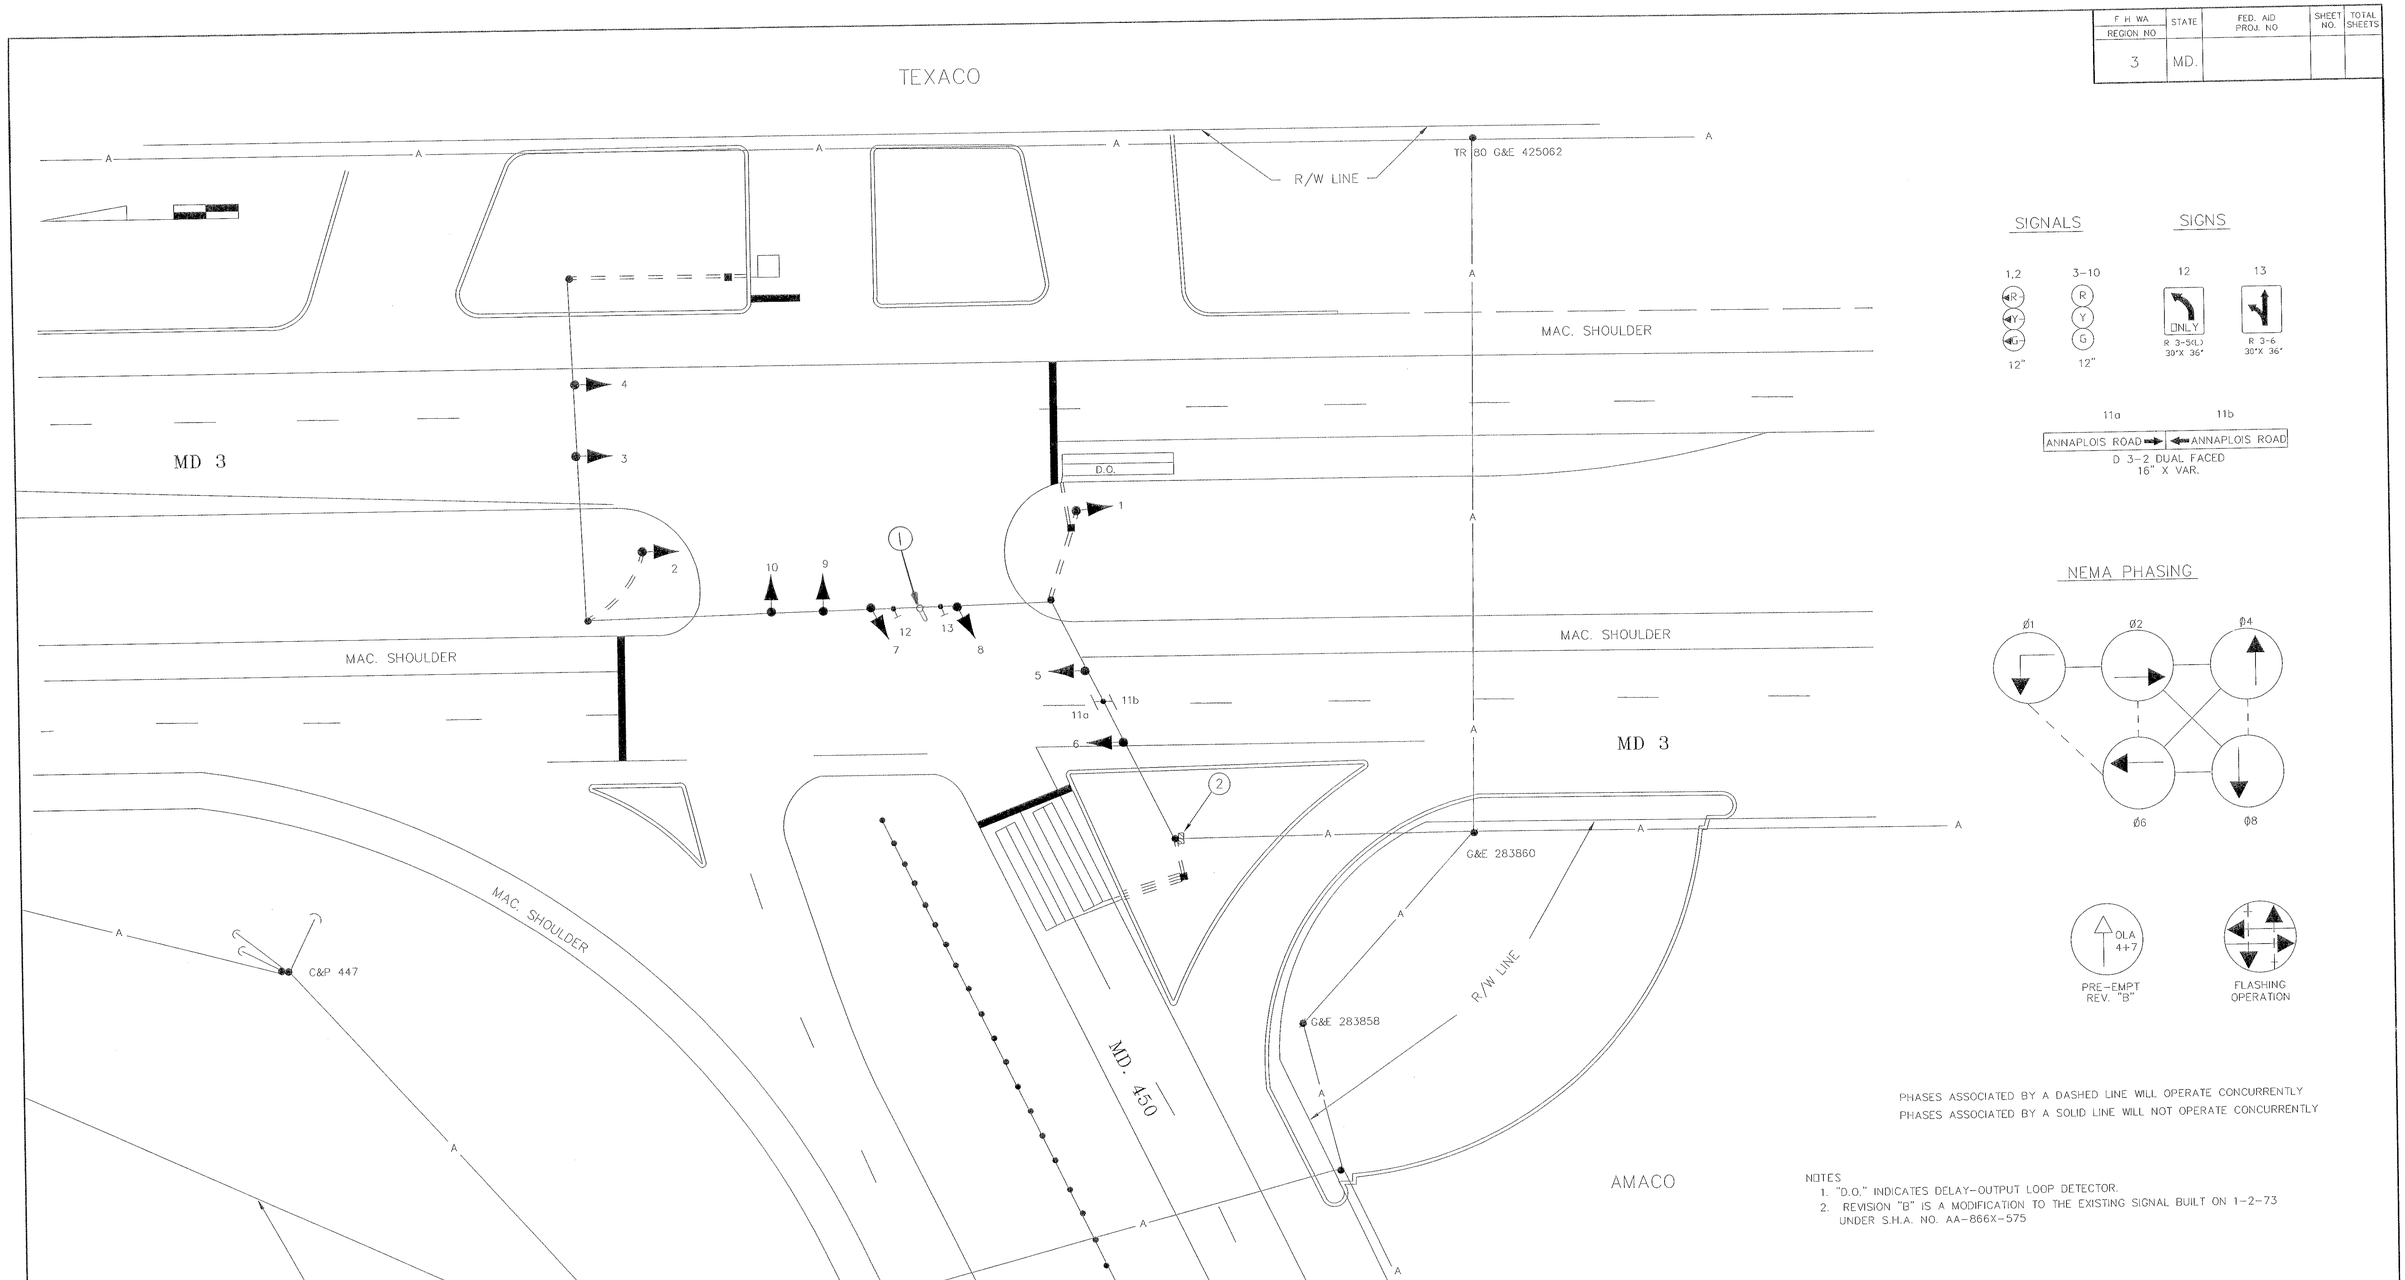

NOTES
1. "D.O." INDICATES DELAY-OUTPUT LOOP DETECTOR.
2. REVISION "B" IS A MODIFICATION TO THE EXISTING SIGNAL BUILT ON 1-2-73 UNDER S.H.A. NO. AA-866X-575

REVISIONS	APPROVALS
B 8/92 INSTALL OPTICOM PRE-EMPTION	ORIGINAL
MAR A 8-1-73 ASBUILT	CHIEF, SIGNAL DESIGN SECTION
JG	ON
	ASST. DISTRICT ENGINEER, TRAFFIC
	CHIEF, TRAFFIC ENGINEERING DESIGN DIVISION
	FILE
	DIRECTOR, OFFICE OF TRAFFIC & SAFETY

MDOT – STATE HIGHWAY ADMINISTRATION
OFFICE OF TRAFFIC & SAFETY
TRAFFIC ENGINEERING DESIGN DIVISION

DRAWN BY: DENNIS DODA
DES. BY: DENNIS DODA
CHK. BY: WILLIAM FITCH

MD 3 & MD 450

SIGNAL # 16000302.25
COUNTY: PRINCE GEORGE'S

DATE: 1-2-73
SCALE: 1"=20'
F.A.P. NO.
S.H.A. NO. AA-866X-575
TS/STD. NO. TS-512 (B)
SHEET NO. ___ OF ___

F# 41

16000302.25