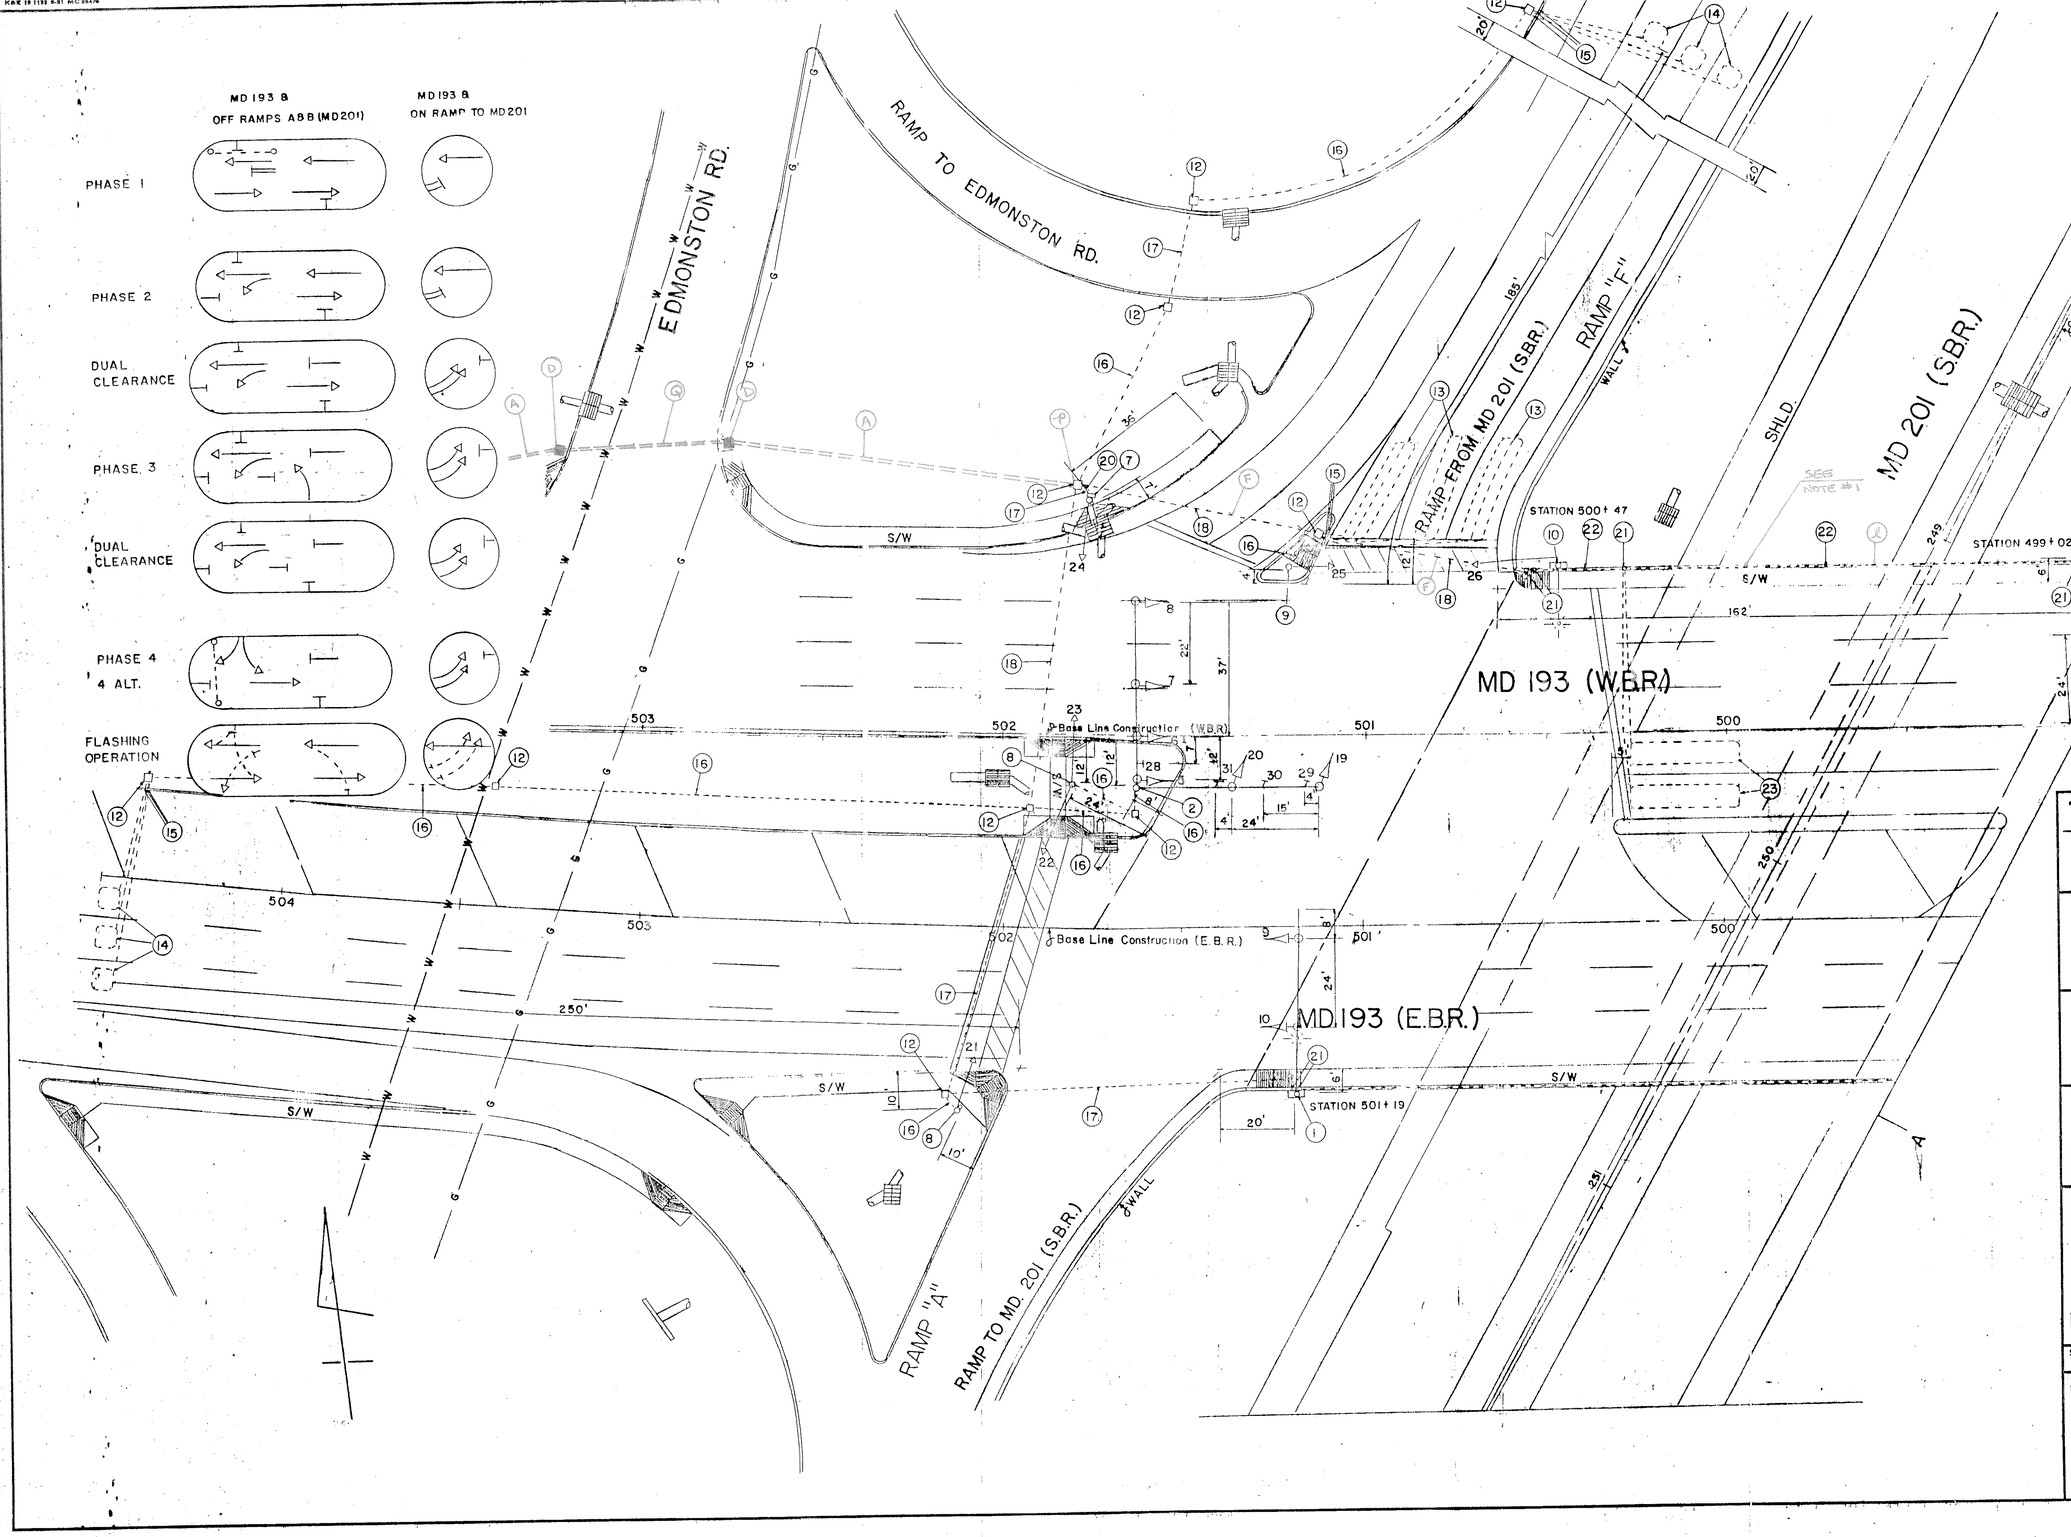

APPROVAL: CHIEF SIGNAL DESIGN SECTION

APPROVAL: DISTRICT TRAFFIC ENGINEER

APPROVAL: CHIEF BUREAU OF TRAFFIC ENGINEERING

APPROVAL: DEPUTY CHIEF ENGINEER TRAFFIC

REVISIONS

STATE OF MARYLAND
DEPARTMENT OF TRANSPORTATION
STATE HIGHWAY ADMINISTRATION

OFFICE OF TRAFFIC – BUREAU OF TRAFFIC ENGINEERING

MD. 193 and MD. 201 (Interchange)

SCALE 1" = 20' DATE 1/30/84 CONTRACT NO. P474-501-371

DRAWN BY: D.L.A. COUNTY: PRINCE GEORGE'S

DESIGNED BY: SIGNAL NO.:

CHECKED BY: DRAWING NO. TS-1931

16019305.80