K&E BALTIMORE 17 0152 PHOENIX 18-79 MC 4198
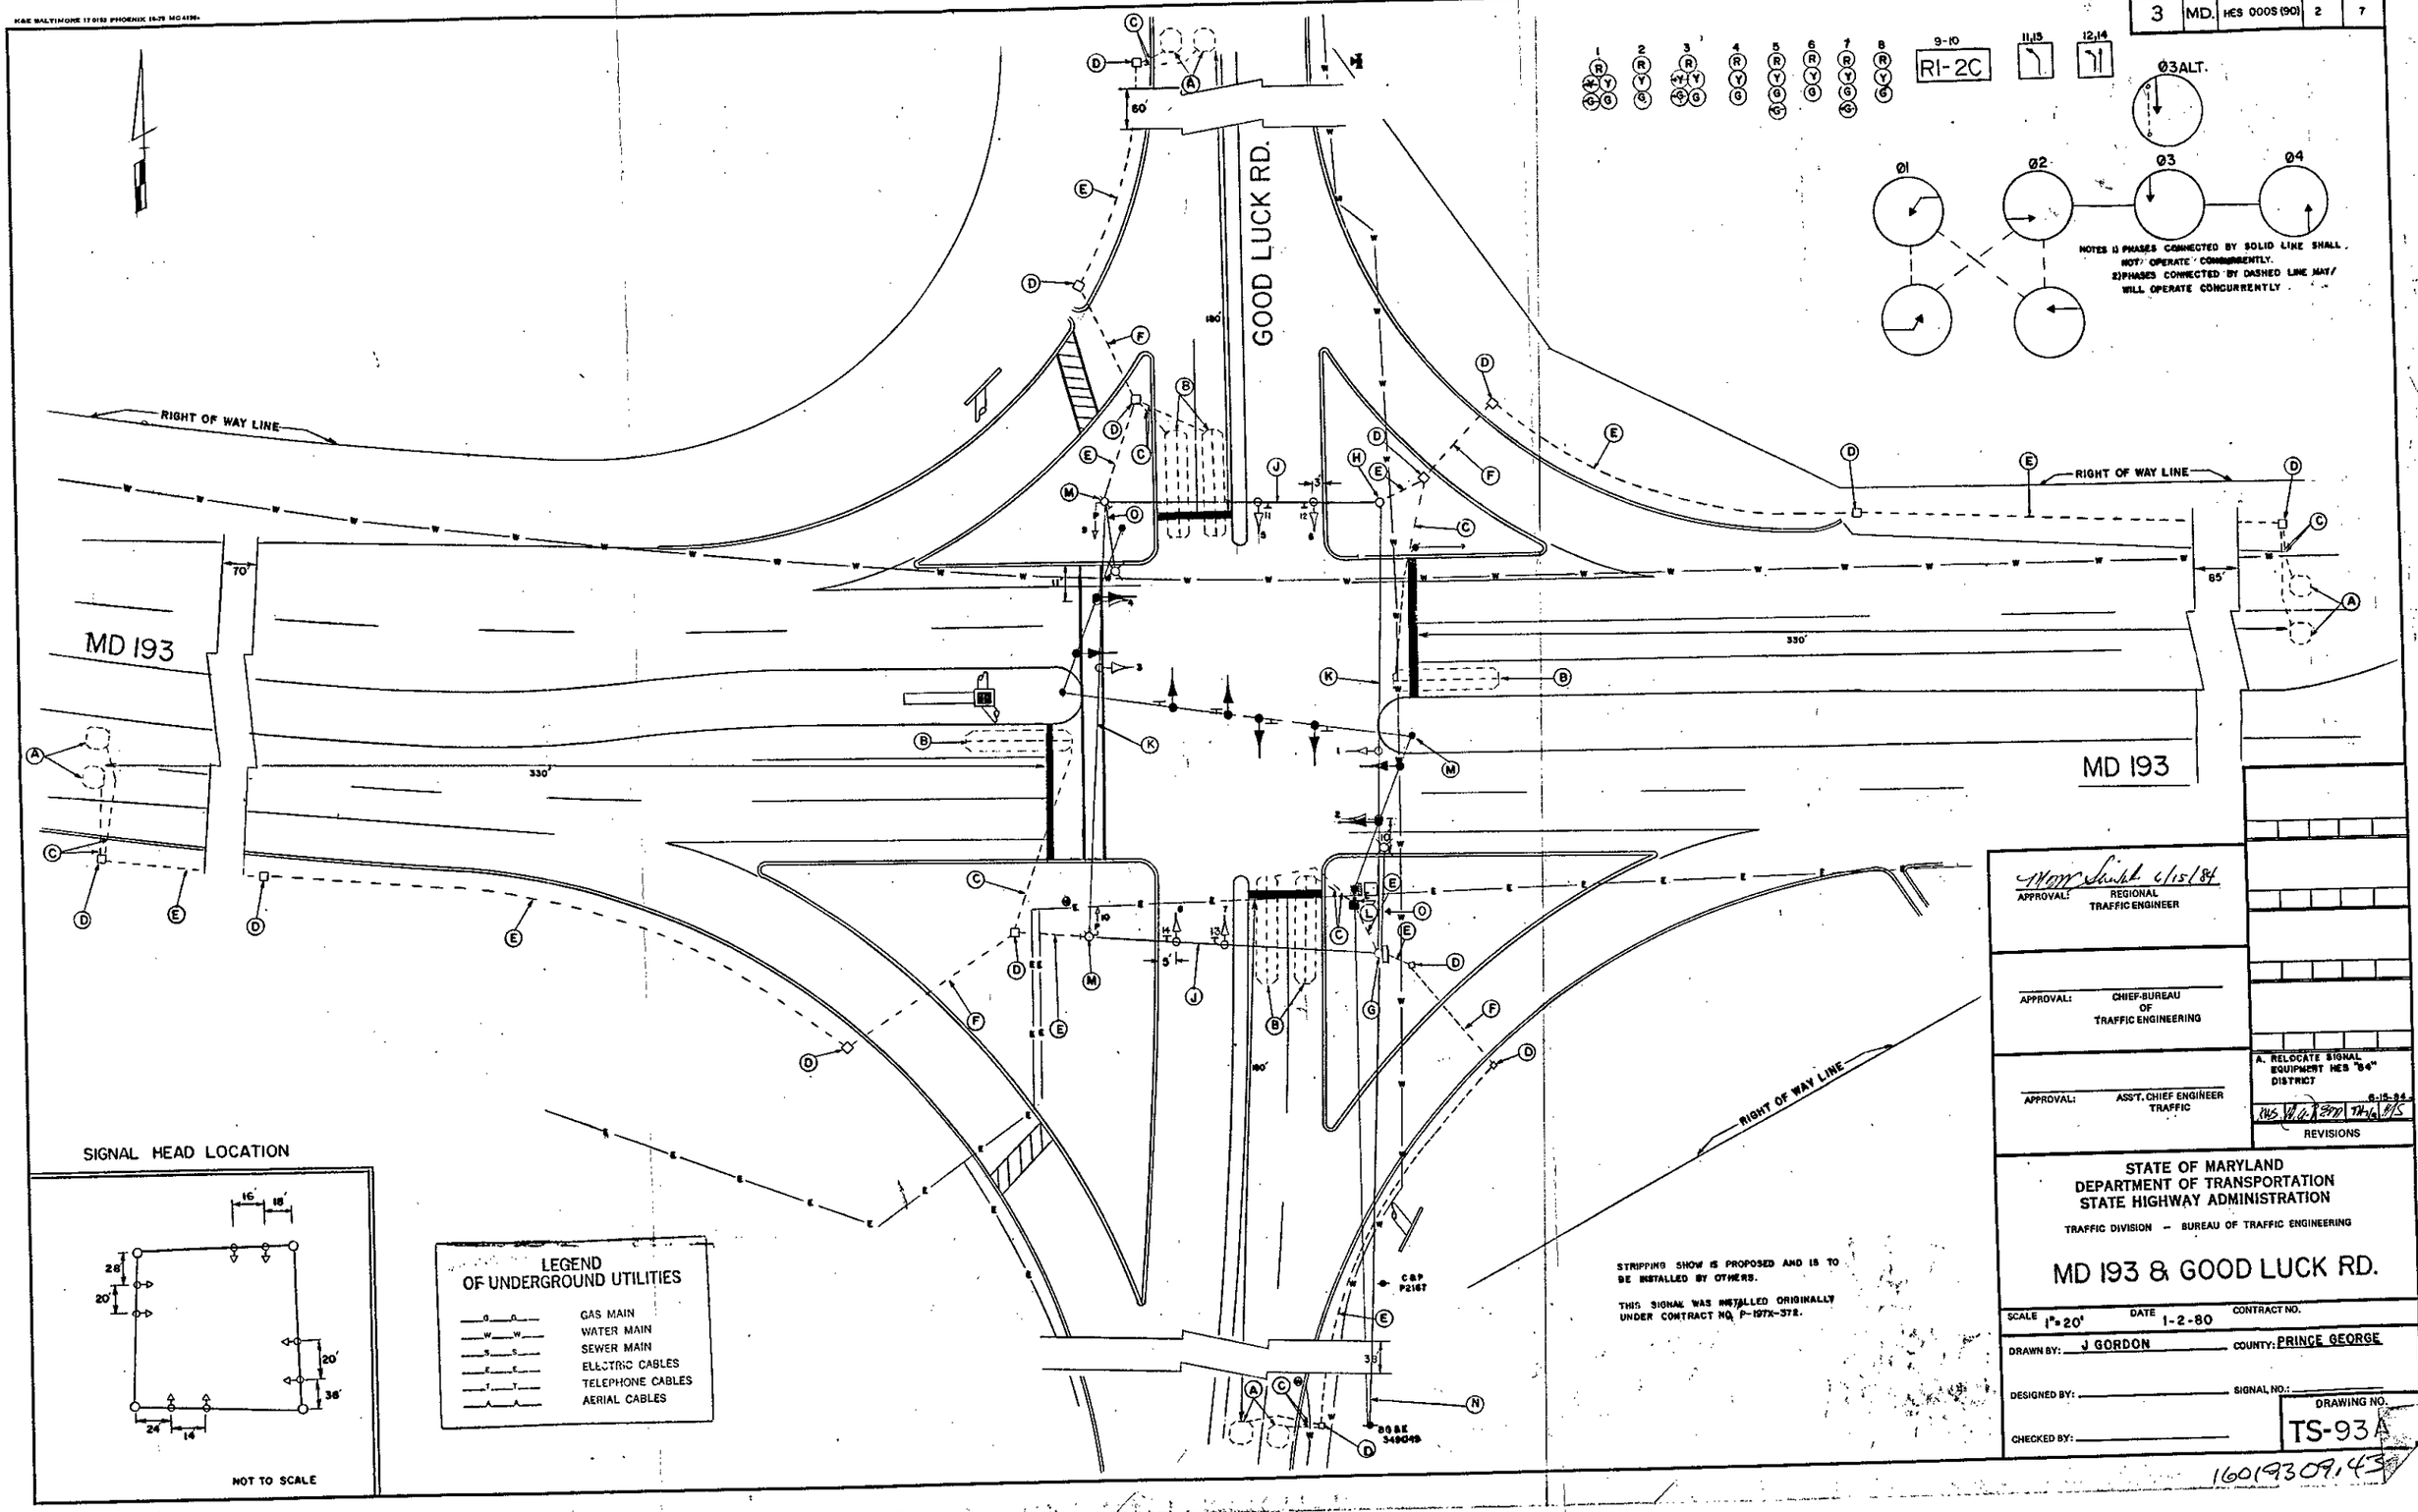
F.H.W.A. REGION NO.	STATE	FED. AID PROJ. NO.	SHEET NO.	TOTAL SHEETS
3	MD.	HES 000S (90)	2	7