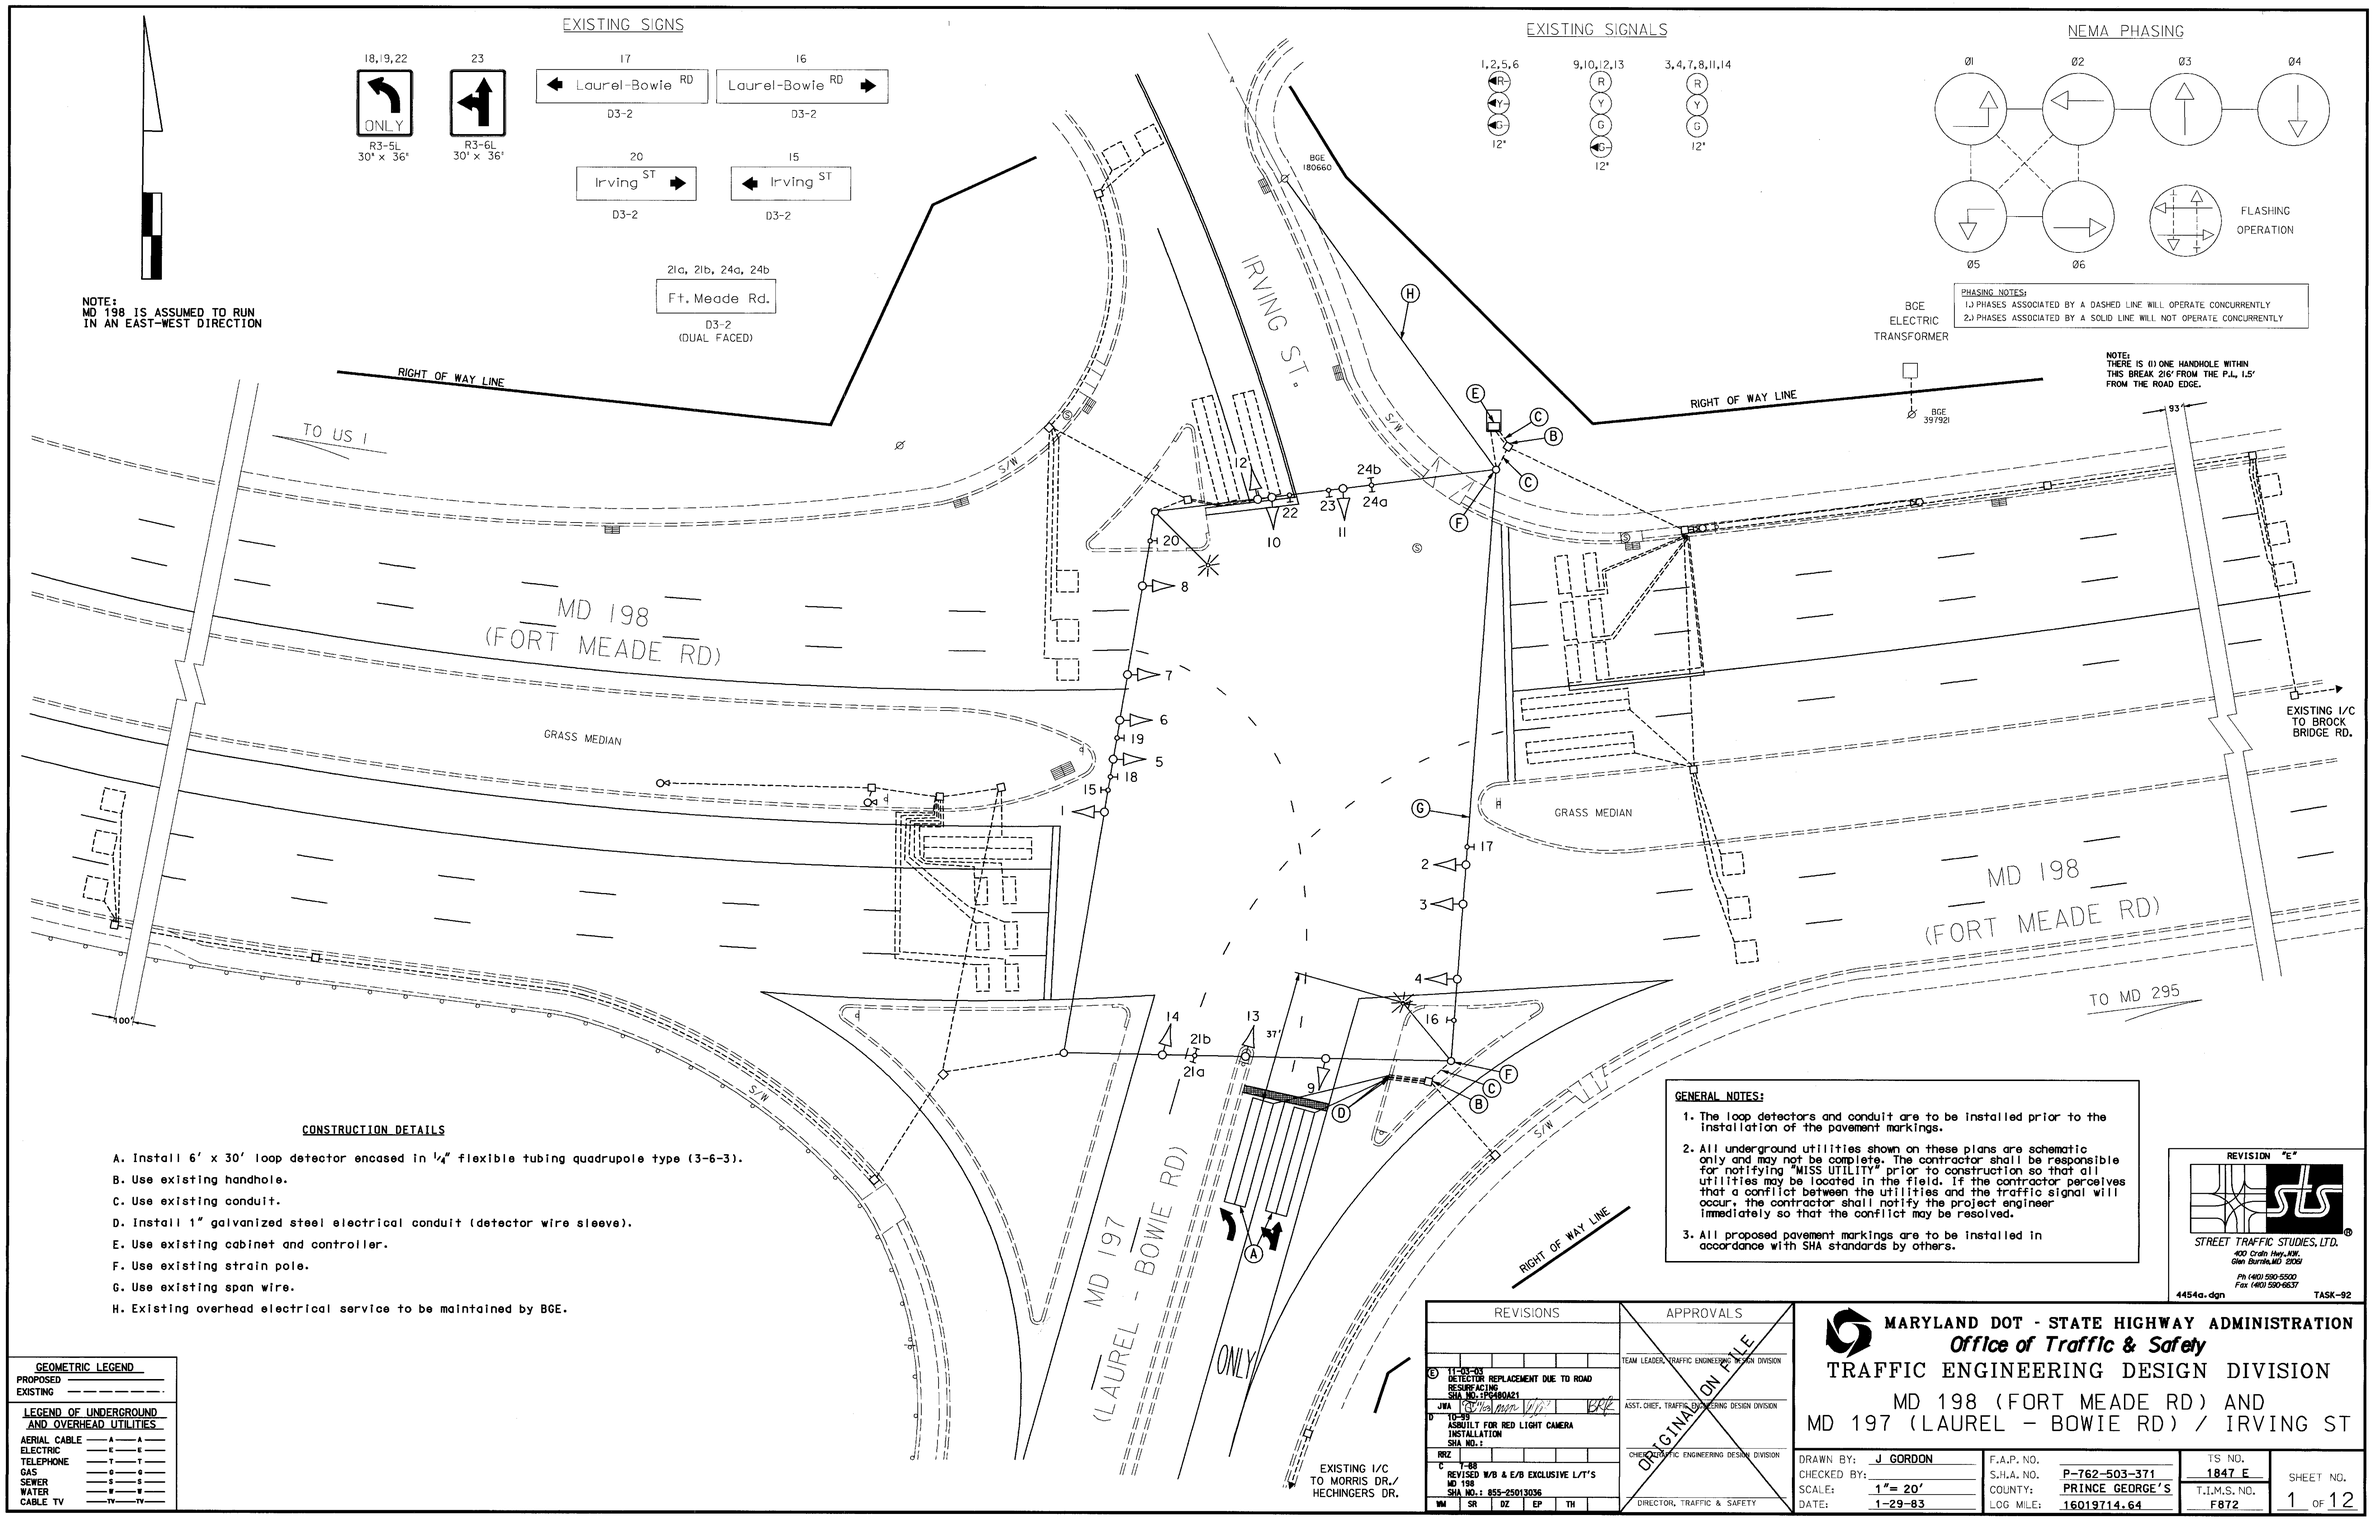

...\4454\4454a\4454a.dgn Nov. 03, 2003 11:47:31