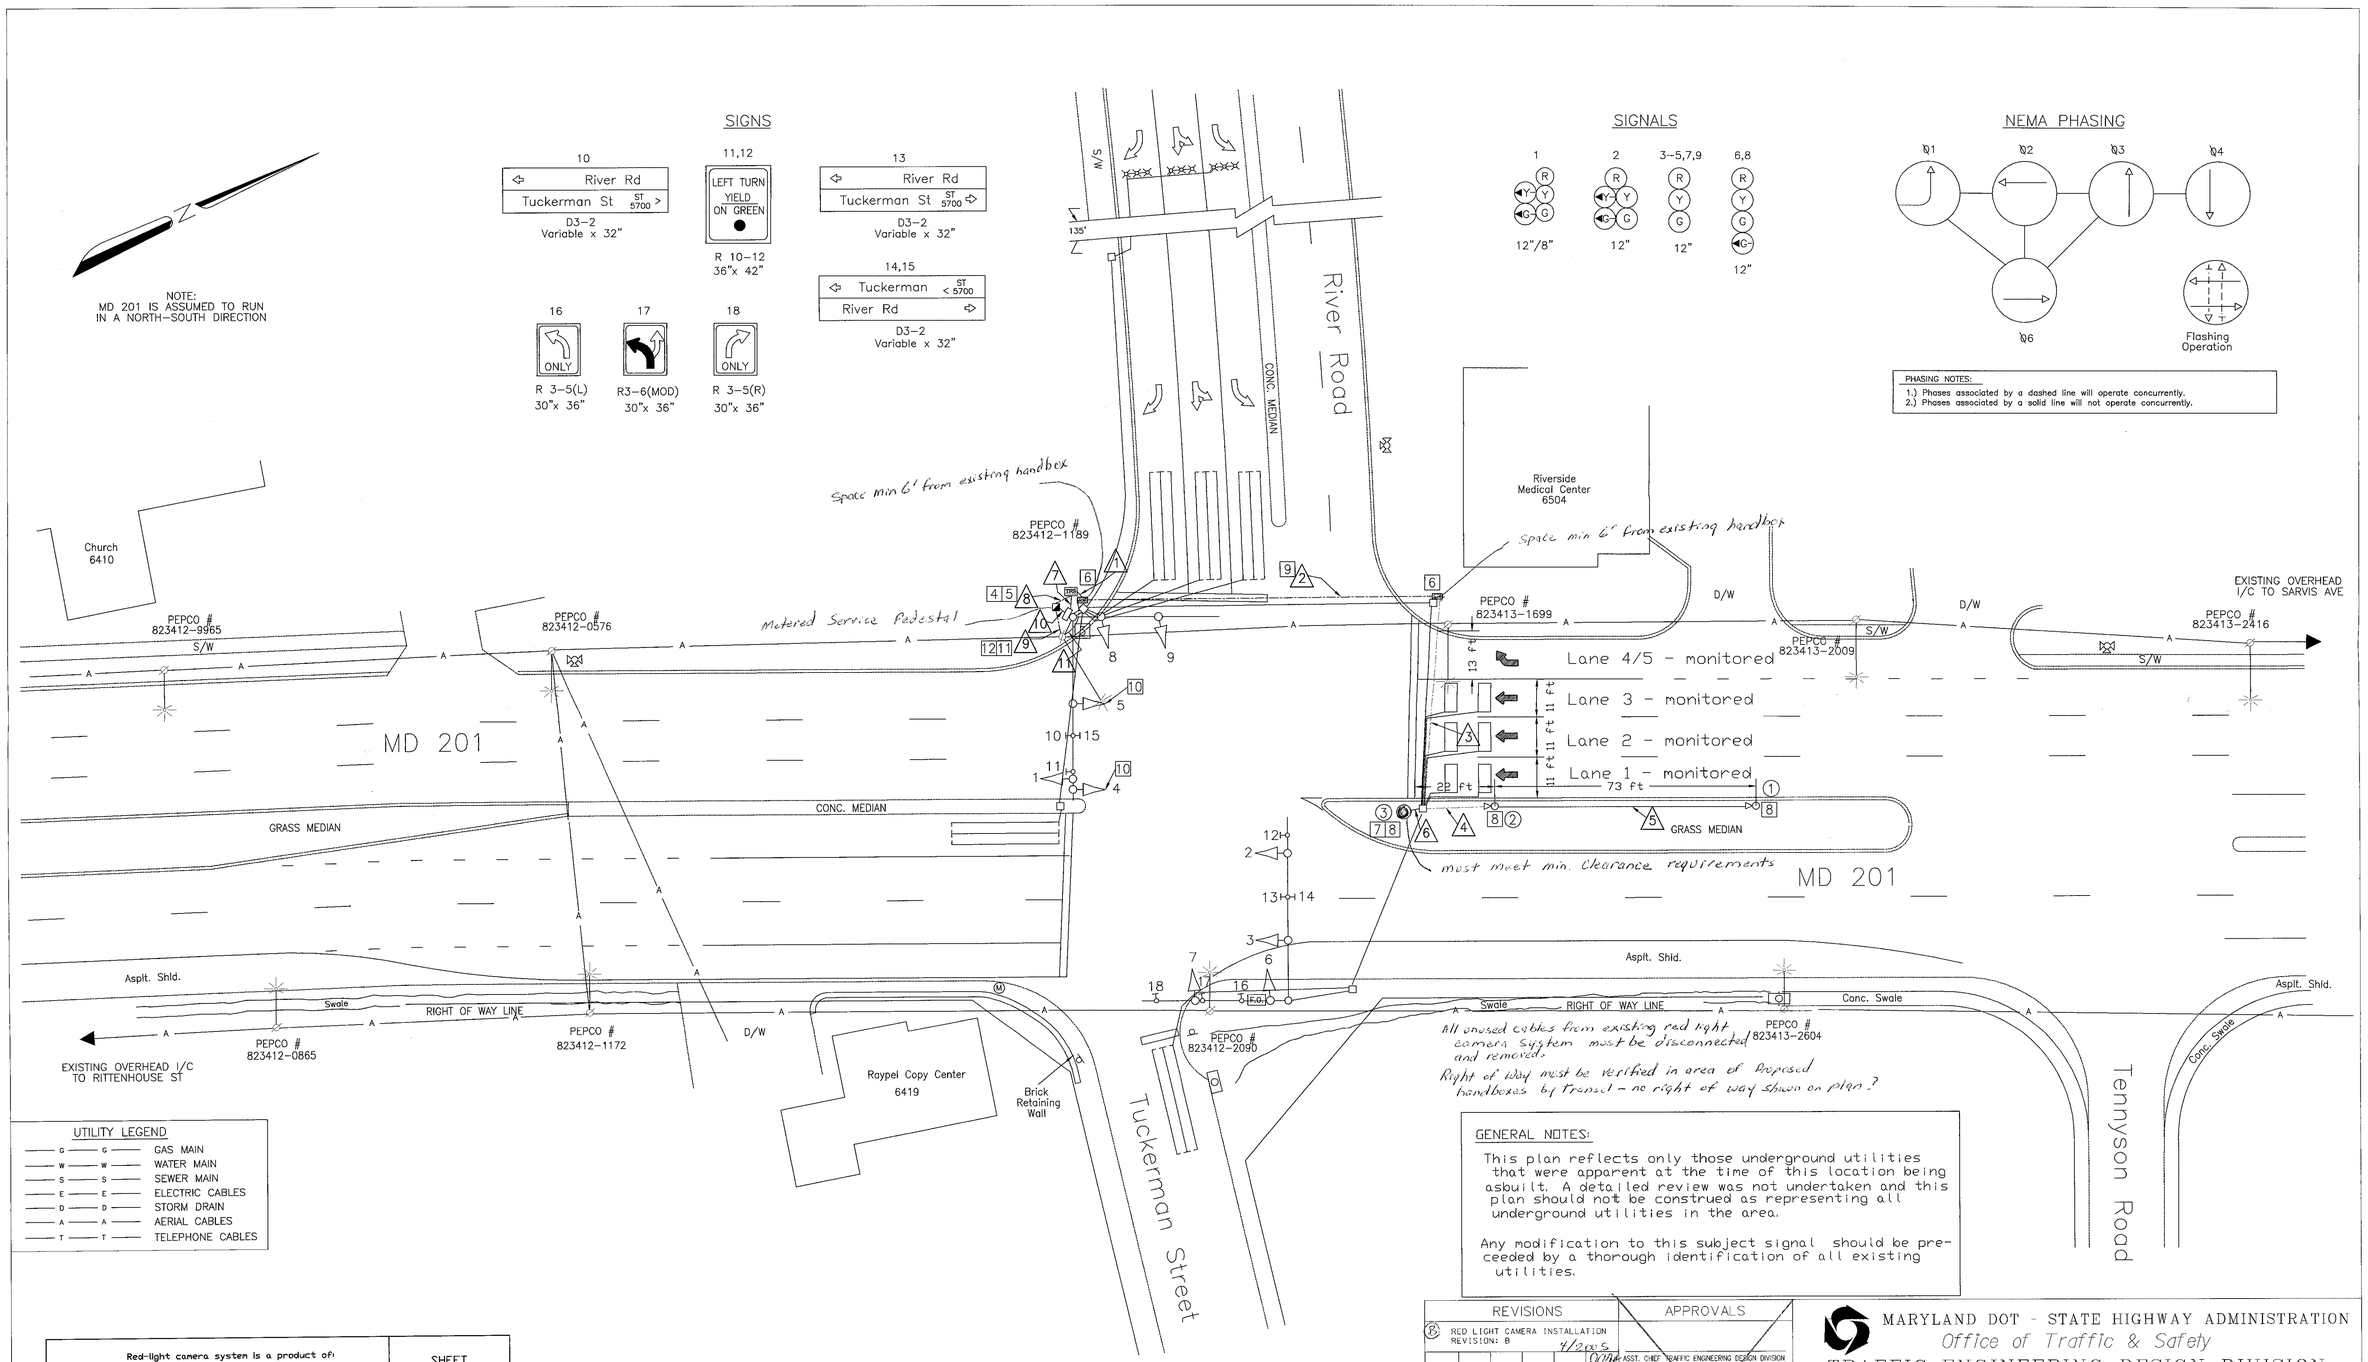
NOTE:
MD 201 IS ASSUMED TO RUN IN A NORTH-SOUTH DIRECTION
SIGNS
10
River Rd
Tuckerman St ST 5700 >
D3-2
Variable x 32"
11,12
LEFT TURN YIELD ON GREEN
R 10-12
36"x 42"
13
River Rd
Tuckerman St ST 5700
D3-2
Variable x 32"
14,15
Tuckerman < ST 5700
River Rd
D3-2
Variable x 32"
16
ONLY
R 3-5(L)
30"x 36"
17
R3-6(MOD)
30"x 36"
18
ONLY
R 3-5(R)
30"x 36"
SIGNALS
1
12"/8"
2
12"
3-5,7,9
12"
6,8
12"
NEMA PHASING
Flashing Operation
PHASING NOTES:
1.) Phases associated by a dashed line will operate concurrently.
2.) Phases associated by a solid line will not operate concurrently.
River Road
CONC. MEDIAN
Riverside Medical Center 6504
Church 6410
Space min 6' from existing handbox
PEPCO # 823412-1189
Metered Service Pedestal
PEPCO # 823412-9965
PEPCO # 823412-0576
PEPCO # 823413-1699
PEPCO # 823413-2009
PEPCO # 823413-2416
EXISTING OVERHEAD I/C TO SARVIS AVE
Lane 4/5 - monitored
Lane 3 - monitored
Lane 2 - monitored
Lane 1 - monitored
22 ft
73 ft
GRASS MEDIAN
must meet min. clearance requirements
MD 201
Asplt. Shld.
Swale
RIGHT OF WAY LINE
Conc. Swale
PEPCO # 823412-0865
PEPCO # 823412-1172
PEPCO # 823412-2090
PEPCO # 823413-2604
EXISTING OVERHEAD I/C TO RITTENHOUSE ST
Raypel Copy Center 6419
Brick Retaining Wall
Tuckerman Street
Tennyson Road
All unused cables from existing red light camera system must be disconnected and removed.
Right of Way must be verified in area of proposed handboxes by Transol - no right of way shown on plan?
UTILITY LEGEND
GAS MAIN
WATER MAIN
SEWER MAIN
ELECTRIC CABLES
STORM DRAIN
AERIAL CABLES
TELEPHONE CABLES
GENERAL NOTES:
This plan reflects only those underground utilities that were apparent at the time of this location being asbuilt. A detailed review was not undertaken and this plan should not be construed as representing all underground utilities in the area.
Any modification to this subject signal should be preceeded by a thorough identification of all existing utilities.
REVISIONS
B RED LIGHT CAMERA INSTALLATION REVISION: B 4/2005
A Asbuilt for red light camera installation 7/4/2000
APPROVALS
ASST. CHIEF, TRAFFIC ENGINEERING DESIGN DIVISION
ASST. DISTRICT ENGINEER, TRAFFIC
CHIEF, TRAFFIC ENGINEERING DESIGN DIVISION
DIRECTOR, TRAFFIC & SAFETY
Original on File
MARYLAND DOT - STATE HIGHWAY ADMINISTRATION
Office of Traffic & Safety
TRAFFIC ENGINEERING DESIGN DIVISION
MD 201 at River Rd/Tuckerman St
DRAWN BY: J. Spencer
CHECKED BY: L. Chambers
SCALE: 1" = 20'
DATE: February 25, 2005
F.A.P. NO.
S.H.A. NO. BW-565-802-312
COUNTY: PRINCE GEORGE'S
LOG MILE: 16020104.38
TS NO. 3324B
T.I.M.S. NO. H037
SHEET NO. 1 OF 3
Red-light camera system is a product of:
Transol USA, inc.
1815 W. 205th Street
Suite 106
Torrance, CA 90501
SHEET 1 OF 3 SHEETS
DRAWING NO. V2