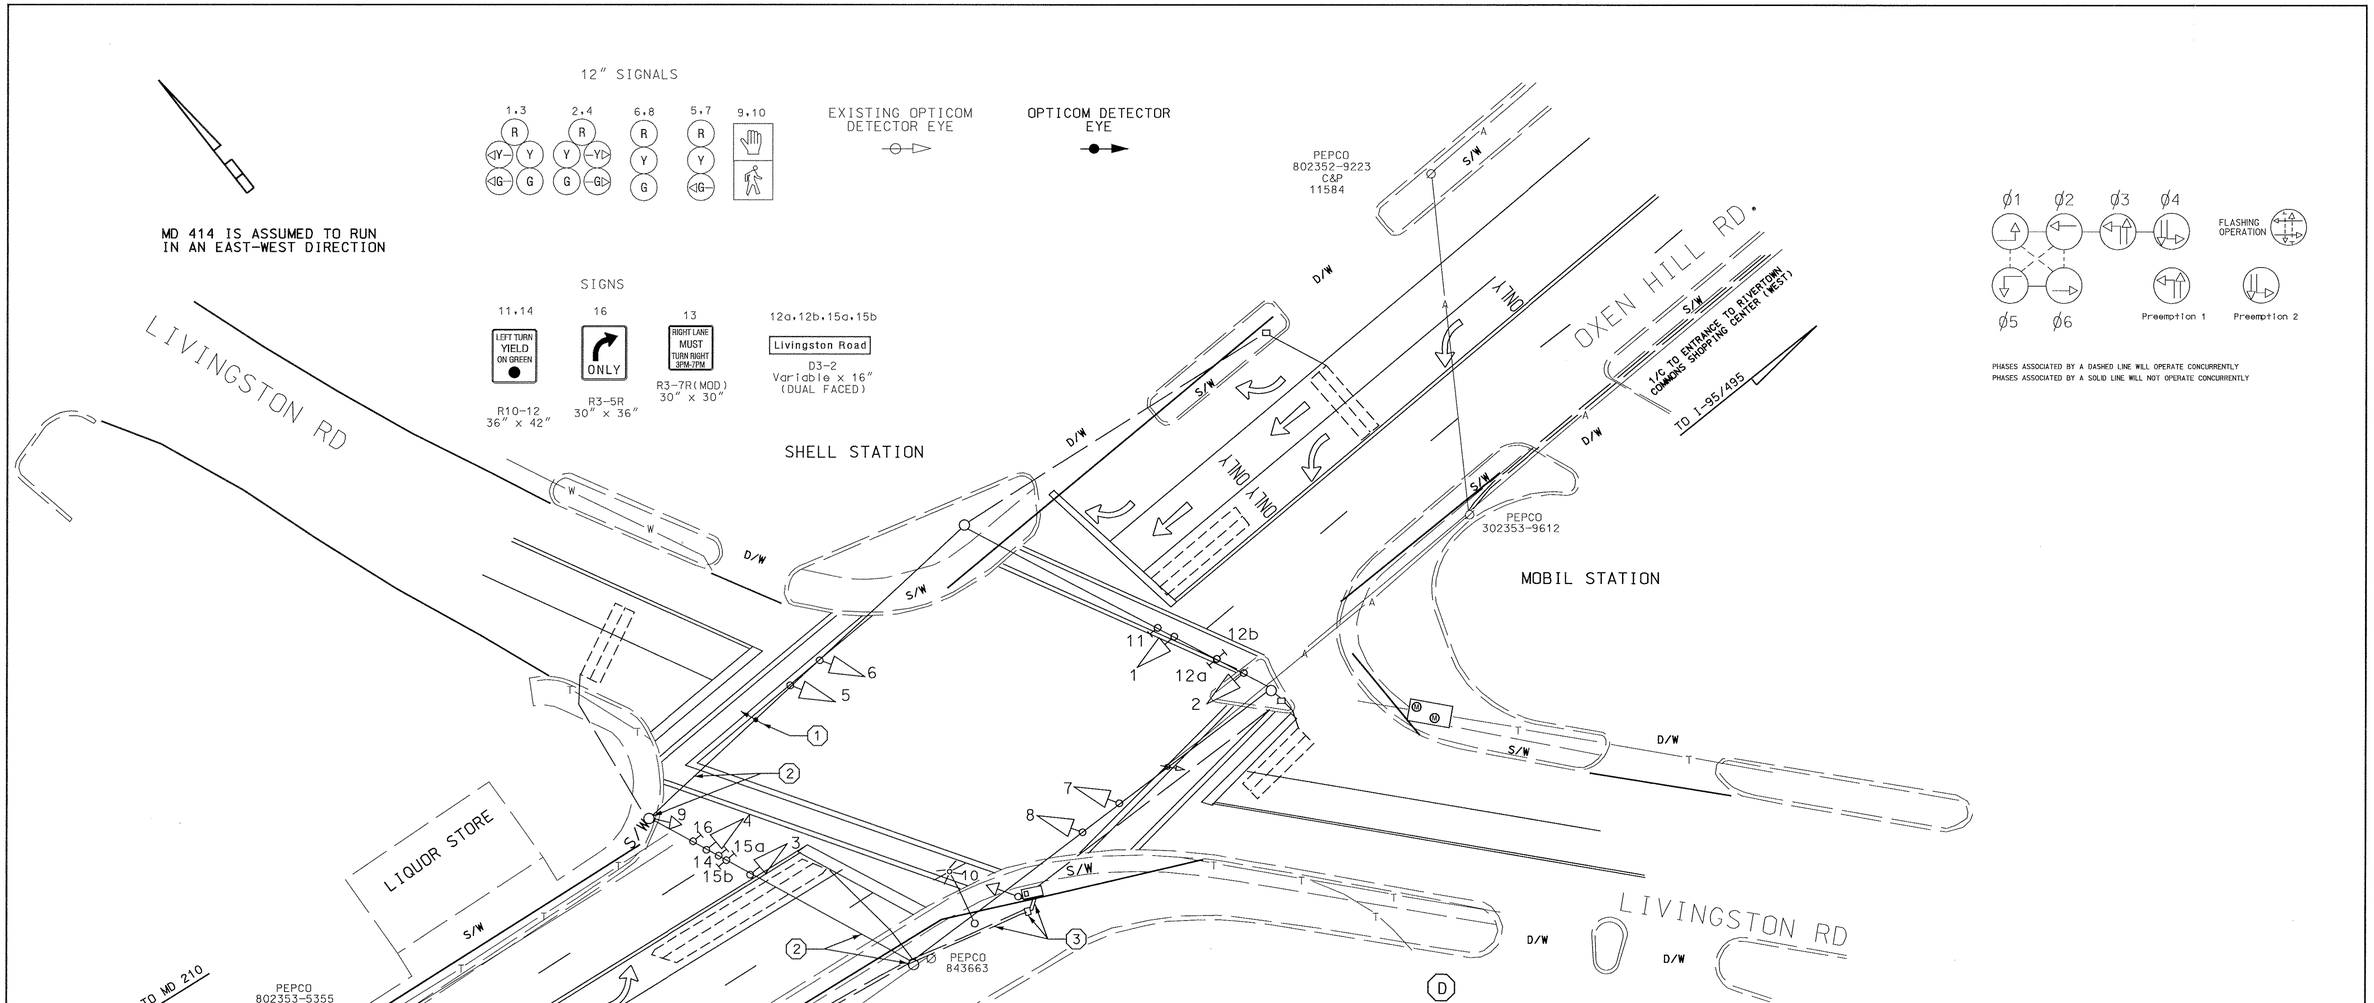


B. EQUIPMENT TO BE SUPPLIED AND/OR INSTALLED BY THE CONTRACTOR

| ITEM NO. | QUANTITY | DESCRIPTION |
|---|---|---|
| 8012 | 1 EACH | F&I 3M OPTICOM #721 DETECTOR EYE |
| 8037 | 200 L.F | F&I 4 - CONDUCTOR OPTICOM DETECTOR CABLE |

CONSTRUCTION DETAILS

1. INSTALL OPTICOM DETECTOR EYE ON EXISTING SPAN WIRE.
2. USE EXISTING SPAN WIRE AND STEEL POLE
3. USE EXISTING HANDHOLE AND CONDUIT.

UTILITY LEGEND

| | |
|---|---|
| —G—G— | GAS MAIN |
| —W—W— | WATER MAIN |
| —S—S— | SEWER MAIN |
| —E—E— | ELECTRIC CABLES |
| —A—A— | AERIAL CABLES |
| —T—T— | TELEPHONE CABLES |

CENTURY ENGINEERING, INC.
CONSULTING ENGINEERS - PLANNERS
32 WEST ROAD
TOWSON, MARYLAND 21204

| REVISIONS | |
|---|---|
| D | 2/00 INSTALL OPTICOM DETECTOR EYE SB LIVINGSTON ROAD |
| C | CEI |
| C | 3/93 INSTALL OPTICOM PRE-EMPTION NB LIVINGSTON ROAD |
| B | 1/92 ASBUILT |
| A | 7/80 ASBUILT |

APPROVALS
ORIGINAL
ASST. TRAFFIC ENGINEERING DESIGN DIVISION
ON
ASST. DISTRICT ENGINEER, TRAFFIC
FILE
CHIEF, TRAFFIC ENGINEERING DESIGN DIVISION
DIRECTOR, TRAFFIC & SAFETY

MARYLAND DOT - STATE HIGHWAY ADMINISTRATION
*Office of Traffic & Safety*
TRAFFIC ENGINEERING DESIGN DIVISION

MD 414 AT LIVINGSTON ROAD
PG308A571B57

| | | | | | |
|---|---|---|---|---|---|
| RE-DRAWN BY: | SPP | F.A.P. NO. | AC-STPG-000S(683)E | TS NO. | SHEET NO. |
| CHECKED BY: | TMH/ OJ | S.H.A. NO. | XX1005185 | 993 D | |
| SCALE: | 1"= 20' | COUNTY: | PRINCE GEORGE'S | T.I.M.S. NO. | |
| DATE: | 2/21/00 | LOG MILE: | 16041400.48 | D565 | 23 OF 24 |

o:\ertrondsig\97006931\md414111v.dgn
20 MAR 2000