F.H.WA. REGION NO.	STATE	FED. AID PROJ. NO.	SHEET NO.	TOTAL SHEETS
3	MD.			

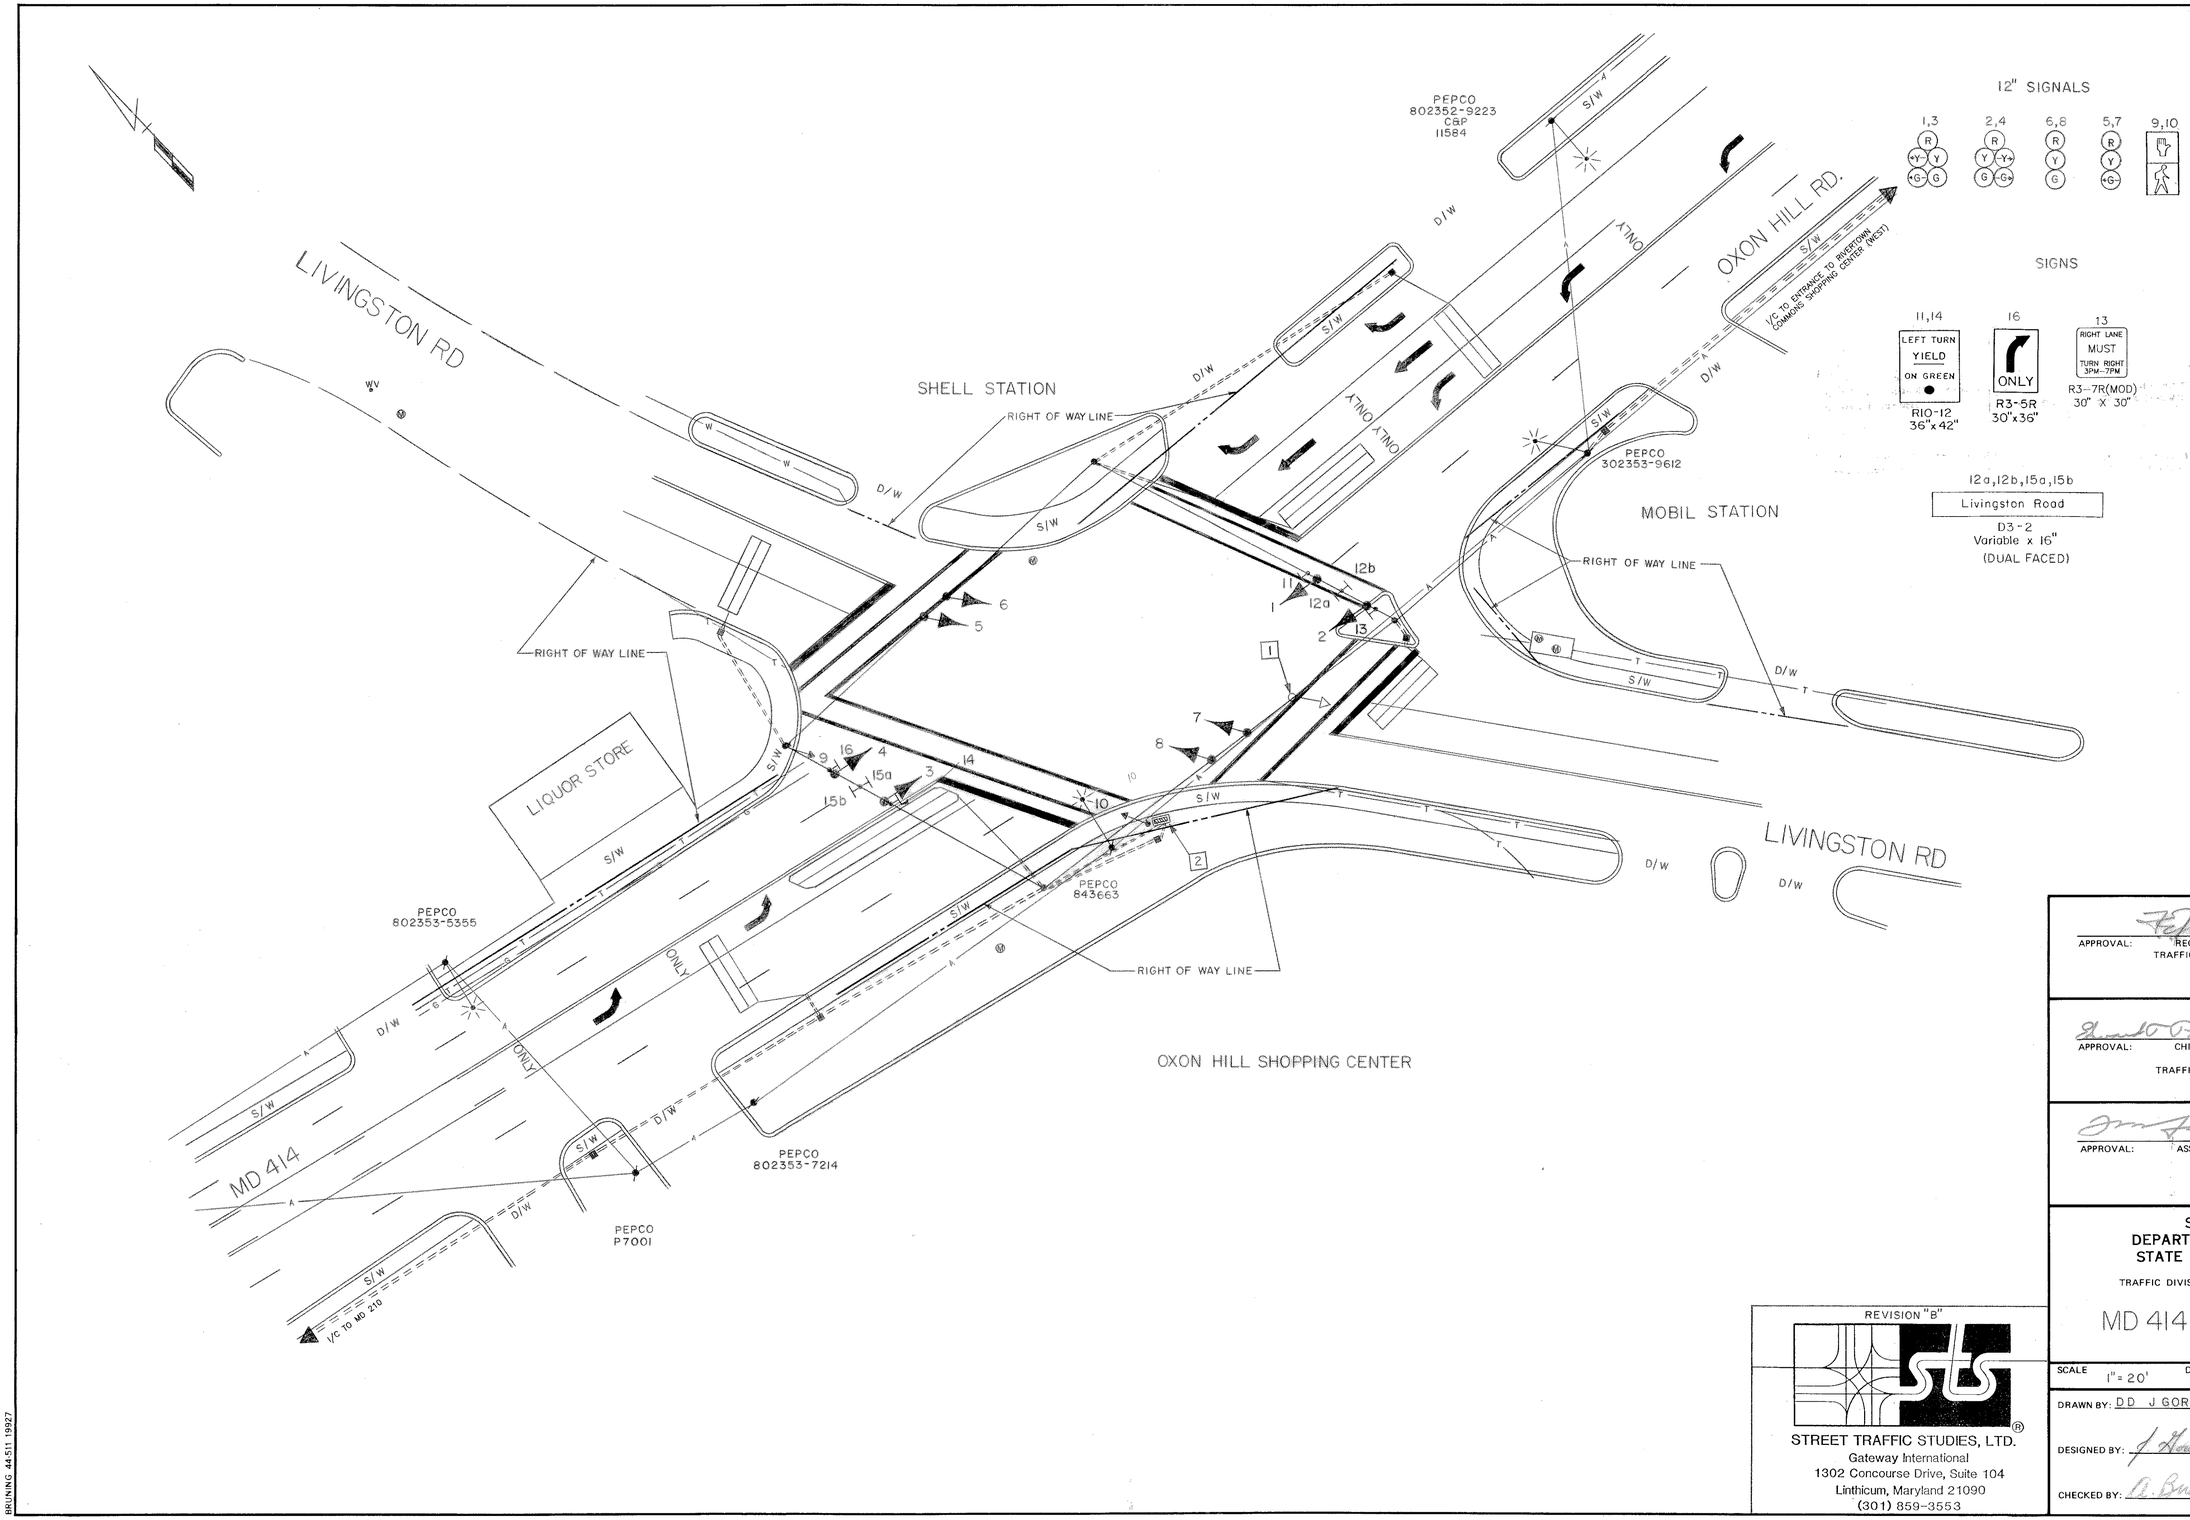

APPROVAL: REGIONAL TRAFFIC ENGINEER

APPROVAL: CHIEF-BUREAU OF TRAFFIC ENGINEERING

APPROVAL: ASS'T. CHIEF ENGINEER TRAFFIC 1/28/76

C 3/93 INSTALL OPTICOM PRE-EMPTION N/B

MAR

B 1-17-92 ASBUILD

RRZ

A 7-1-80 OLD CONTRACT NO. P-473X-000-385 ASBUILT

JSB

REVISIONS

STATE OF MARYLAND
DEPARTMENT OF TRANSPORTATION
STATE HIGHWAY ADMINISTRATION

TRAFFIC DIVISION — BUREAU OF TRAFFIC ENGINEERING

MD 414 & LIVINGSTON RD

REVISION "B"

STREET TRAFFIC STUDIES, LTD.
Gateway International
1302 Concourse Drive, Suite 104
Linthicum, Maryland 21090
(301) 859-3553

SCALE 1" = 20' DATE 8-13-75 CONTRACT NO.

DRAWN BY: DD J GORDON COUNTY: PRINCE GEORGE

DESIGNED BY: J. Gordon SIGNAL NO.:

CHECKED BY: A. Budniakuk

DRAWING NO. TS-9930

BRUNING 44-511 19927