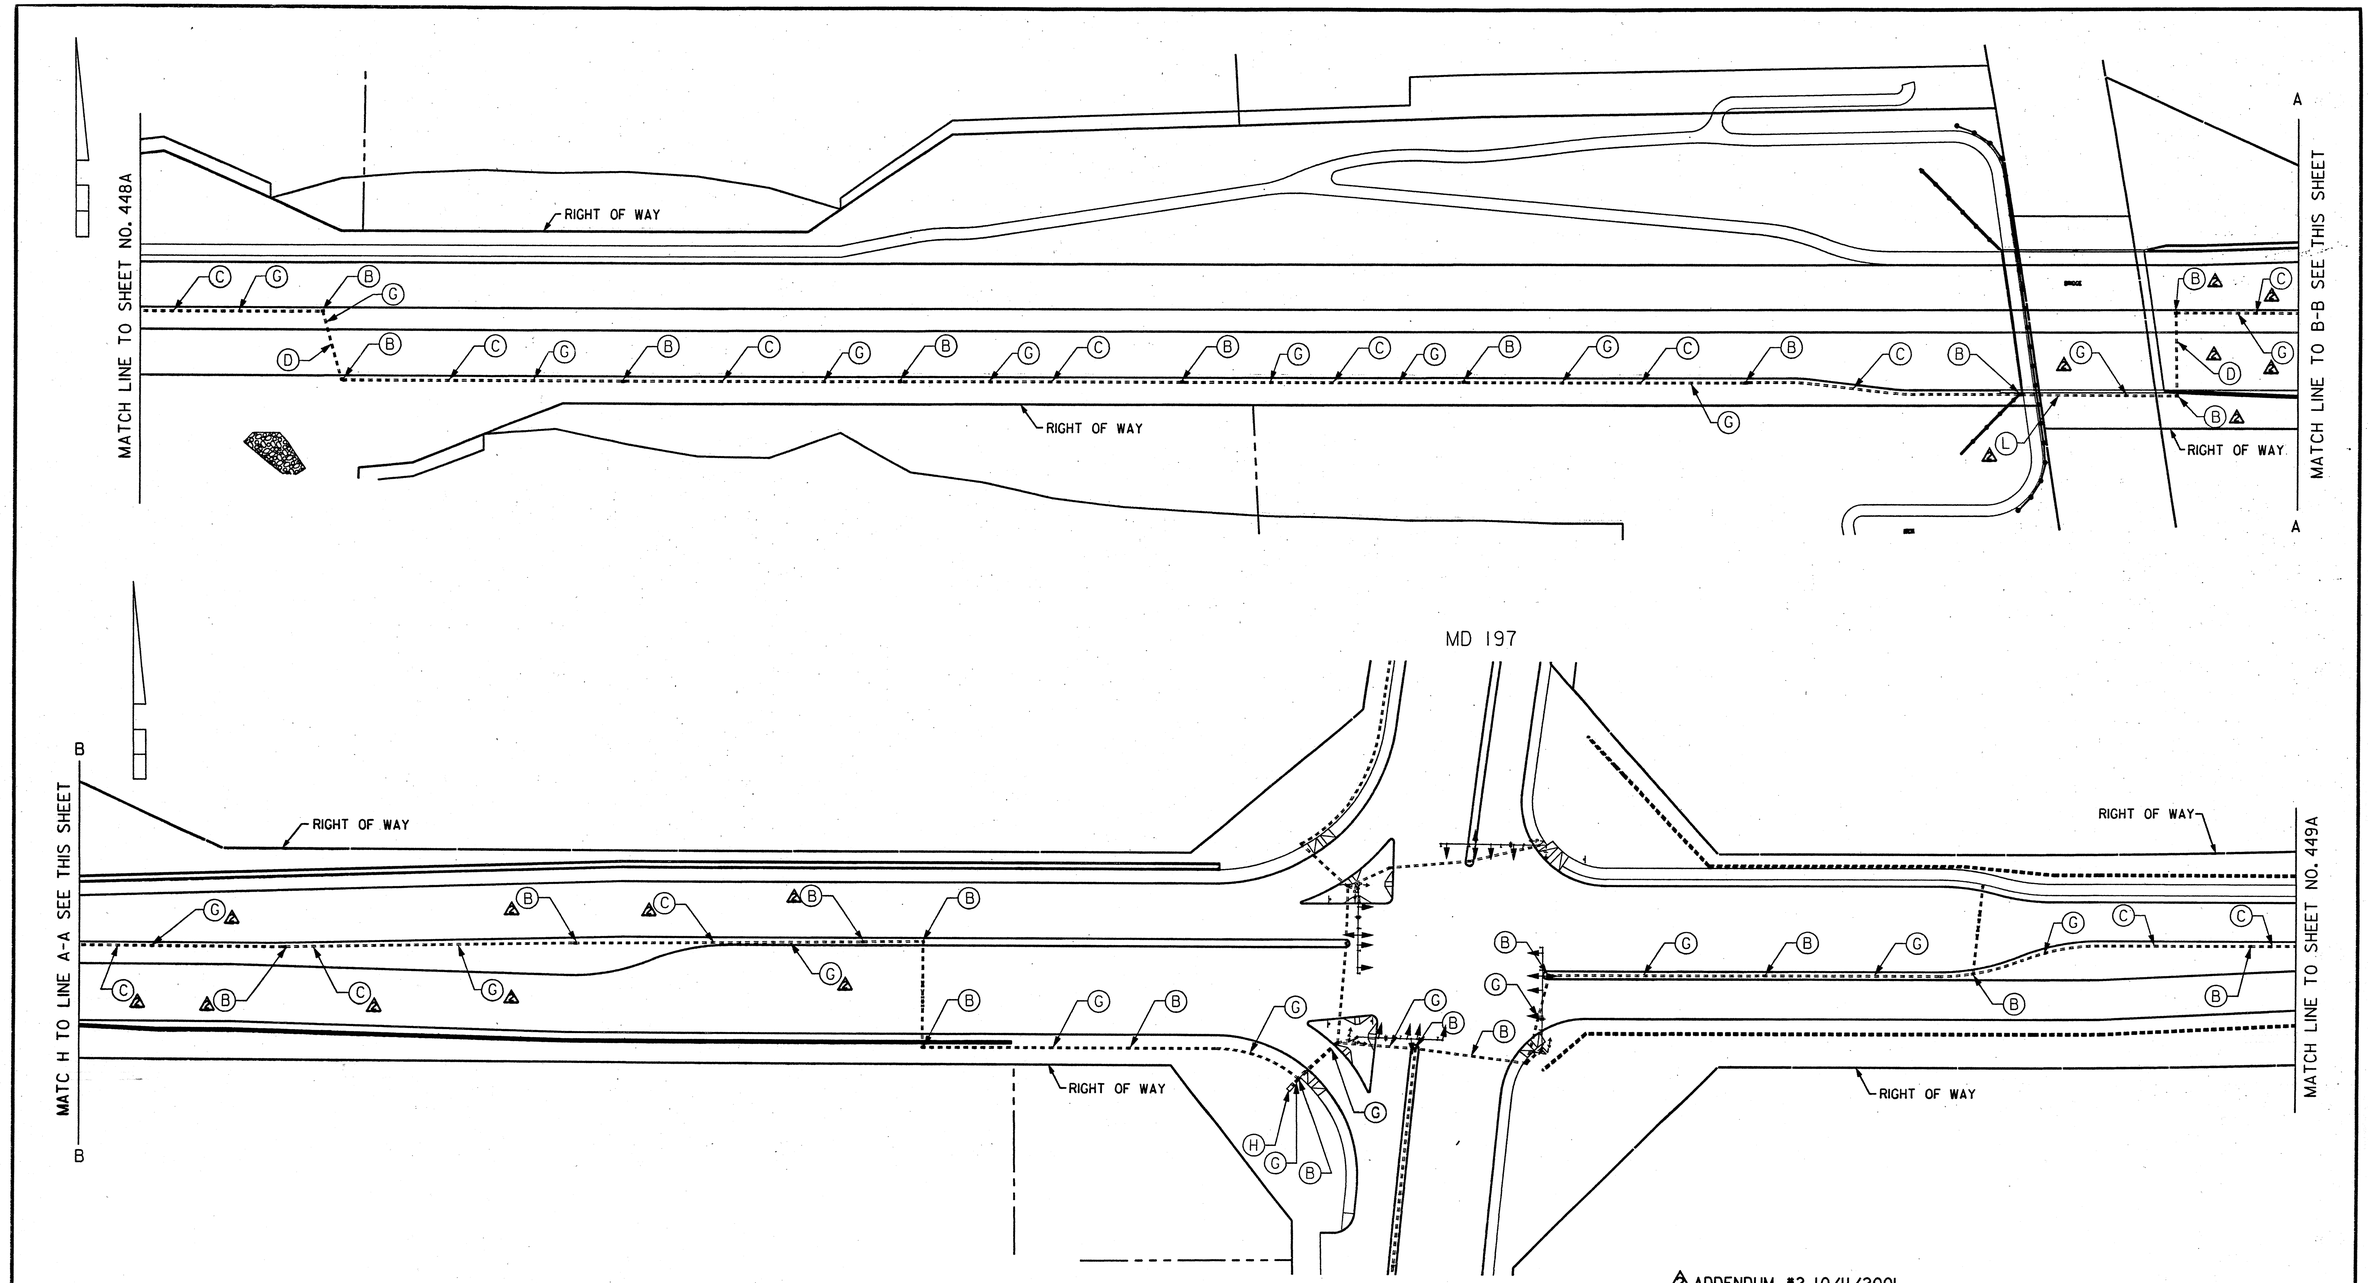

2 ADDENDUM #2 10/11/2001

REVISIONS

MARYLAND DOT - STATE HIGHWAY ADMINISTRATION
Office of Traffic & Safety
TRAFFIC ENGINEERING DESIGN DIVISION

INTERCONNECT SHEET OF MD 450
FROM MD 193 TO SUPERIOR LANE

DRAWN BY:	MB	F.A.P. NO.	SEE TITLE SHEET	PLAN SHEET NO.:	SHEET NO.
CHK. BY:	STB	S.H.A. NO.	PG9005571	TS1821-1C5	449 OF 545
SCALE:	1"=50'	COUNTY	PRINCE GEORGE'S		

t:\MD450E\d538gc05.dgn
10/30/01 mb
T:\plotsto\pentables\default-xerox.tbl