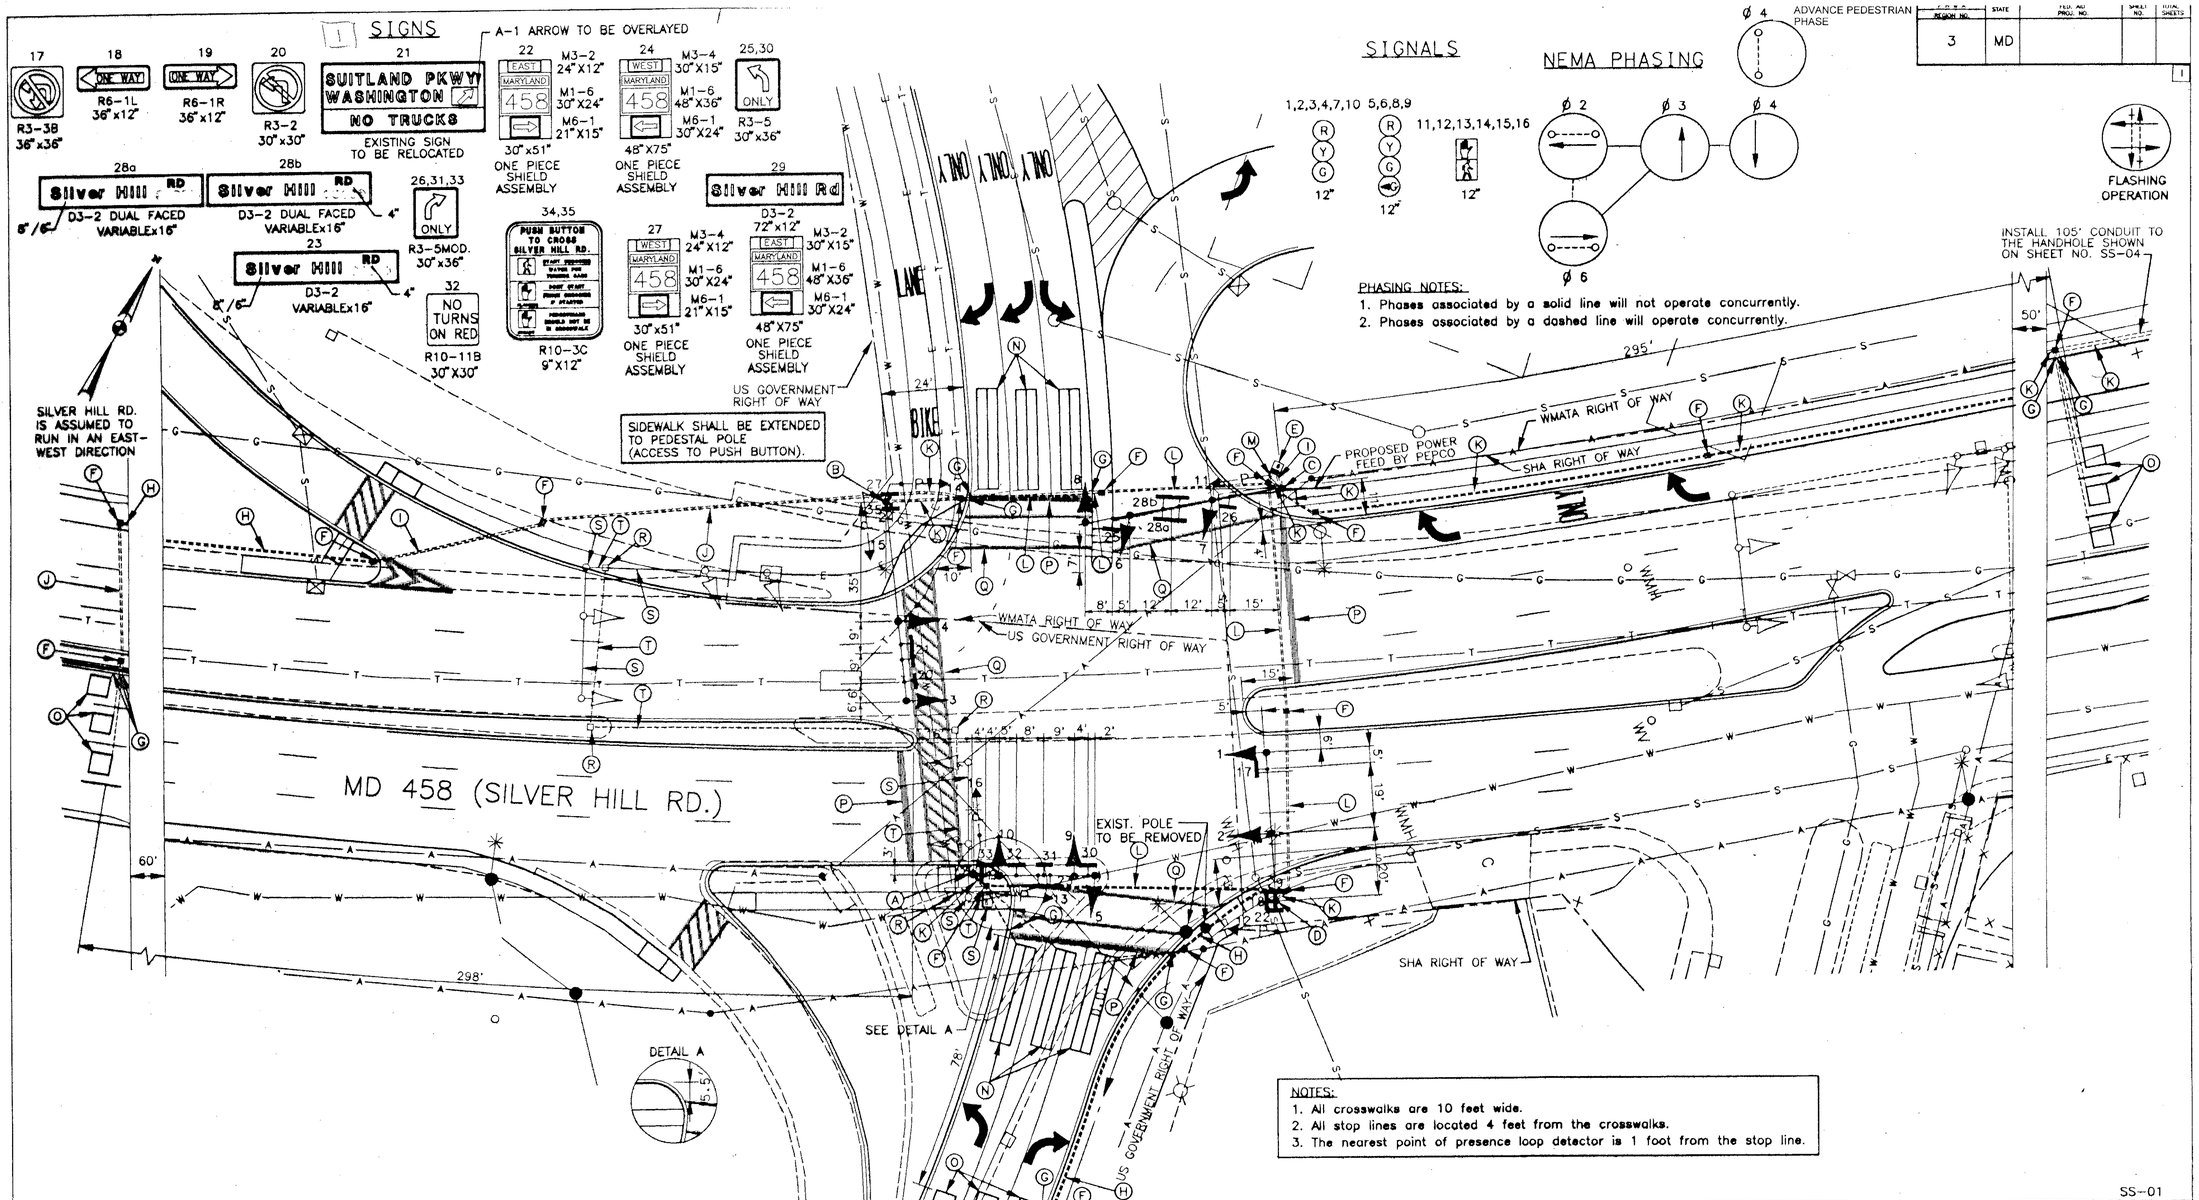

FORM NO.	STATE	PROJ. NO.	SHEET NO.	TOTAL SHEETS
3	MD			

UTILITIES LEGEND

- A — AERIAL CABLES
- G — GAS MAIN
- E — ELECTRIC CABLES (UNDERGROUND)
- T — TELEPHONE CABLES
- W — WATER MAIN
- S — SEWER MAIN
- SD — STORM DRAIN

ROADWAY LEGEND

- EXISTING
- PROPOSED

RUMMEL, KLEPPER & KAHL
CONSULTING ENGINEERS
81 MOSHER STREET
BALTIMORE, MD 21217
TEL. (410) 728-2900

REVISIONS:	APPROVALS:
A. REVISED 9/95 FOR METRO STATION CONSTRUCTION	ORIGINAL
3/12/99 [1] APPROVED T.S. PLANS PER PCO 67	CHIEF SIGNAL DESIGN SECTION ON ASST. DISTRICT ENGINEER TRAFFIC
B CHANGE PHASE 4 PEDESTRIAN PHASE TO AN ADVANCED PED PHASE 8/2001	CHIEF TRAFFIC ENGINEERING DESIGN DIVISION FILE DIRECTOR OFFICE OF TRAFFIC & SAFETY

MDOT – STATE HIGHWAY ADMINISTRATION
Office of Traffic & Safety
TRAFFIC ENGINEERING DESIGN DIVISION
LOG MILE #16045800.90

DRAWN BY: ZAJ
DES. BY: ZAJ
CHK. BY:

MD 458 (SILVER HILL ROAD)
@ SUITLAND PARKWAY
SIGNAL PLAN
COUNTY: PRINCE GEORGE'S

DATE: SEPTEMBER, 1995 W.M.A.T.A. NO. 1F0091
SCALE: 1"=20' S.H.A. NO.

TS NO.: 995B
SHEET NO. M936-902

09/06/95 11:19:01