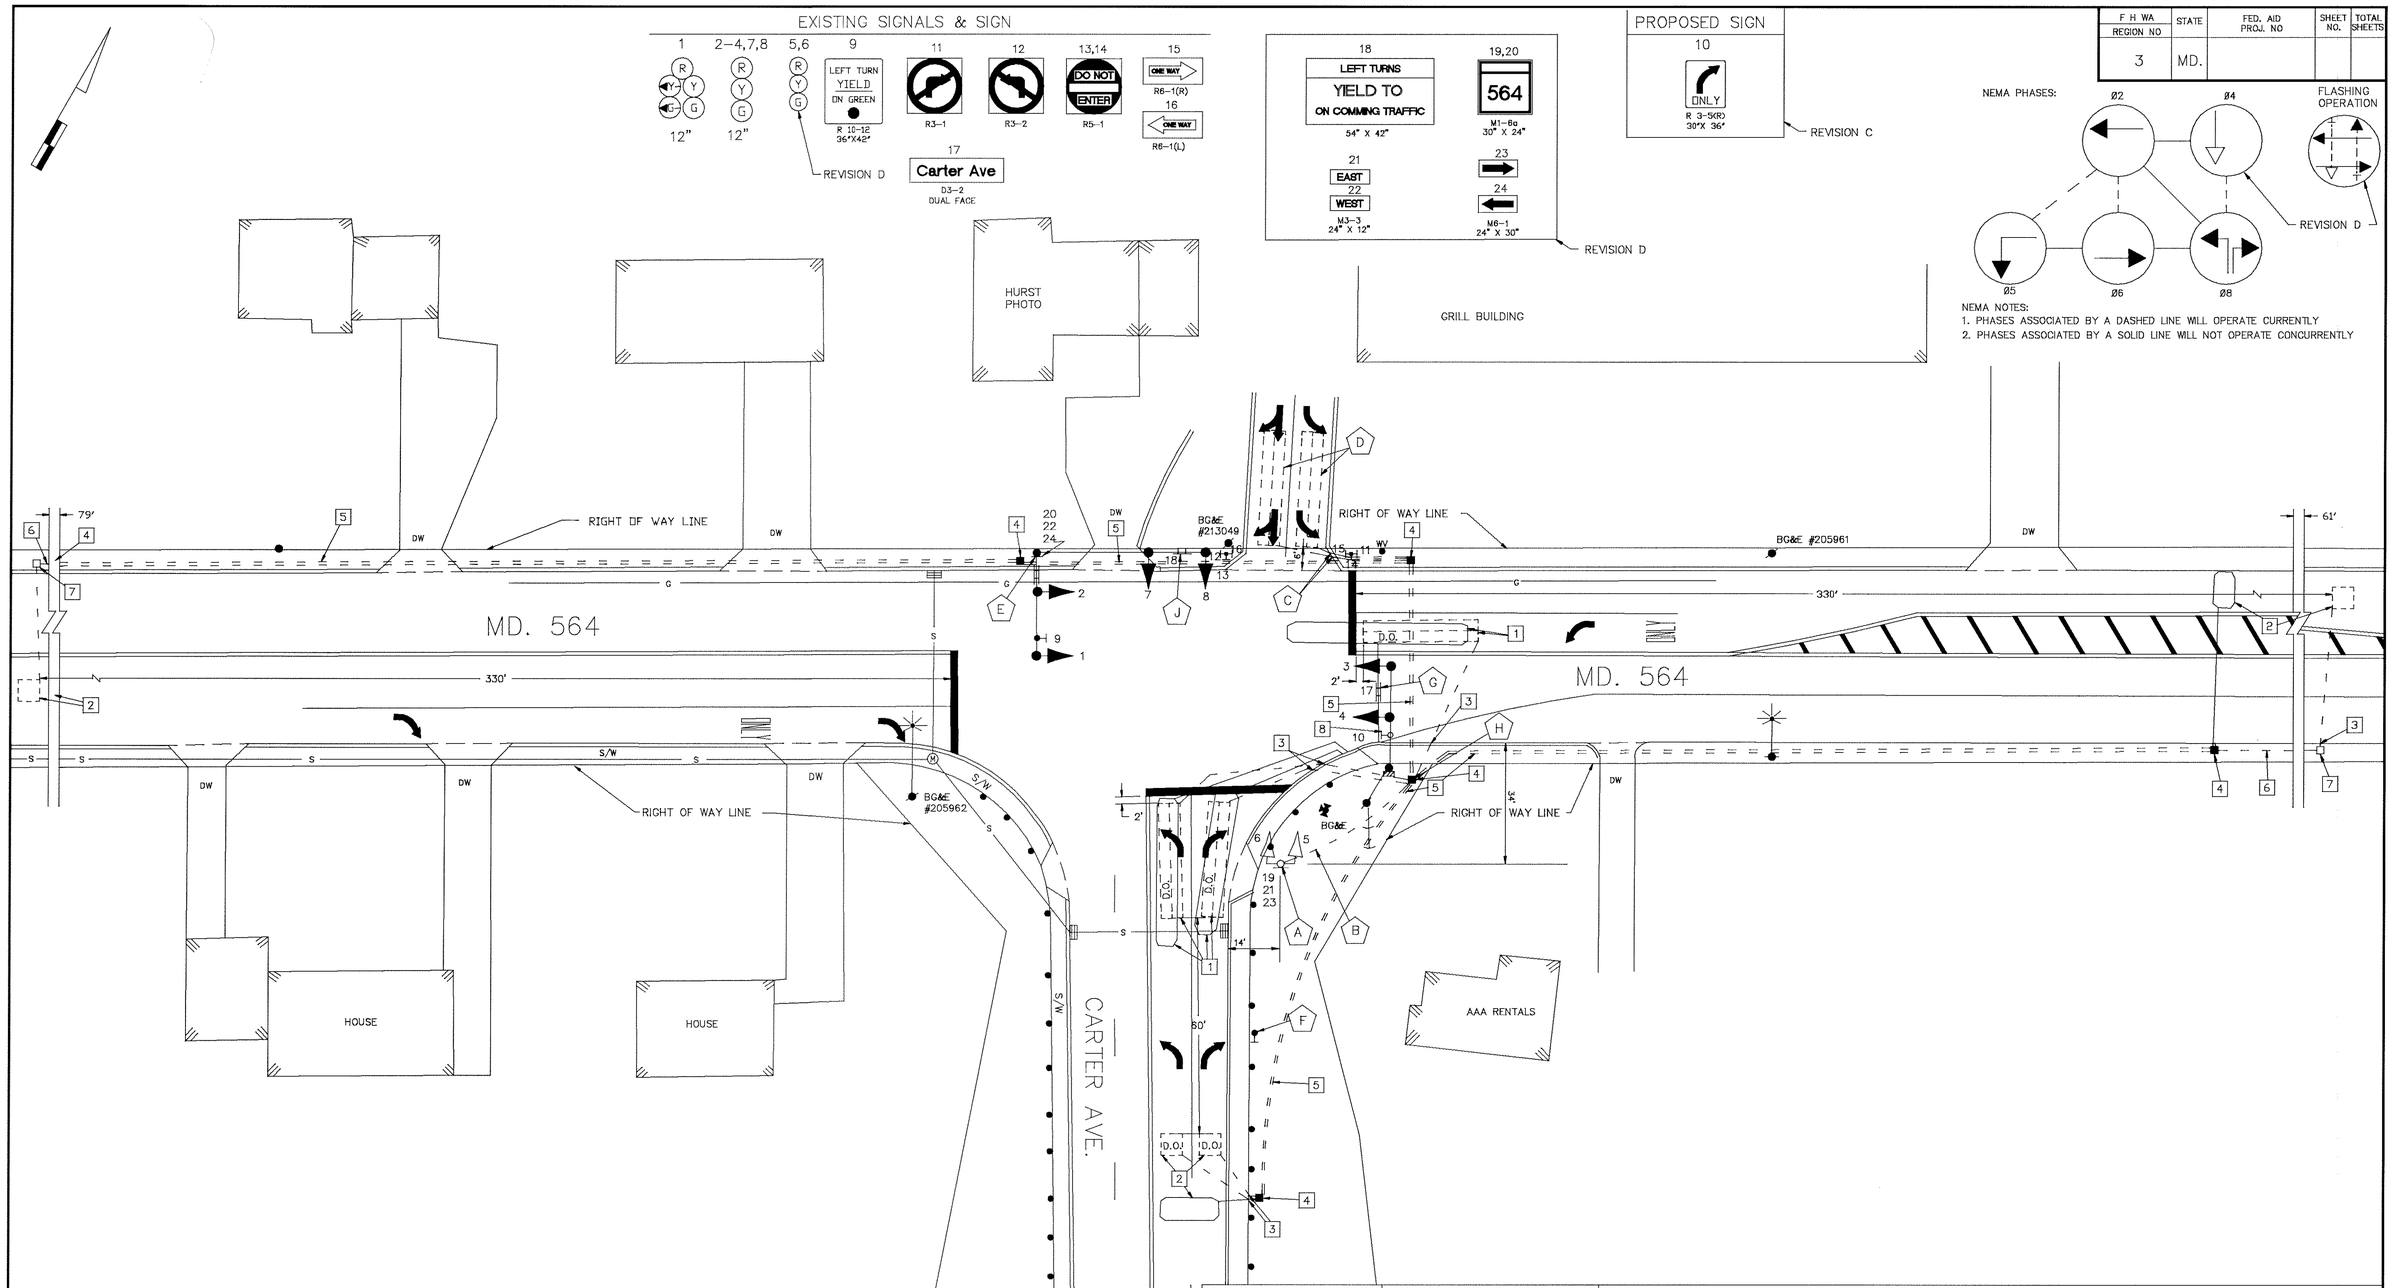

REVISIONS	APPROVALS
(D) 5/94 INSTALL PED. MOUNTED SIGNAL FOR GRILL BLDG D/W. SHA # 855-25057004	CHIEF, SIGNAL DESIGN SECTION
(C) 07/93 – REBUILT LOOP DET. DUE TO RESURFACING SHA # P-102-201-377	ASST. DISTRICT ENGINEER, TRAFFIC
B. 04/93 AS BUILT	CHIEF, TRAFFIC ENGINEERING DESIGN DIVISION
(A) 4/14/82 – REVISED POLE & HANDBOX DUE TO UTILITIES – MAST IN NORTH CORNER	DIRECTOR, OFFICE OF TRAFFIC & SAFETY
SR / ETP	

NOTE: THIS IS A REVISION TO P-629-501-385 DATED 11/07/79 ORIGINAL PLAN ON FILE

MDOT – STATE HIGHWAY ADMINISTRATION
Office of Traffic & Safety
TRAFFIC ENGINEERING DESIGN DIVISION

DRAWN BY: STEVE RENZI
DES. BY: STEVE RENZI
CHK. BY:

MD. 564 & CARTER AVE.

SIGNAL # 16056400.96
COUNTY: PRINCE GEORGE'S

DATE: 11/07/79
SCALE: 1" = 20'
F.A.P. NO.
S.H.A. NO. P-629-501-385
TS/STD. NO. 1587 D
SHEET NO. 1 OF 1

16056400.96