F.H.W.A. REGION NO.	STATE	FED. AID PROJ. NO.	SHEET NO.	TOTAL SHEETS
3	MD.		1	1

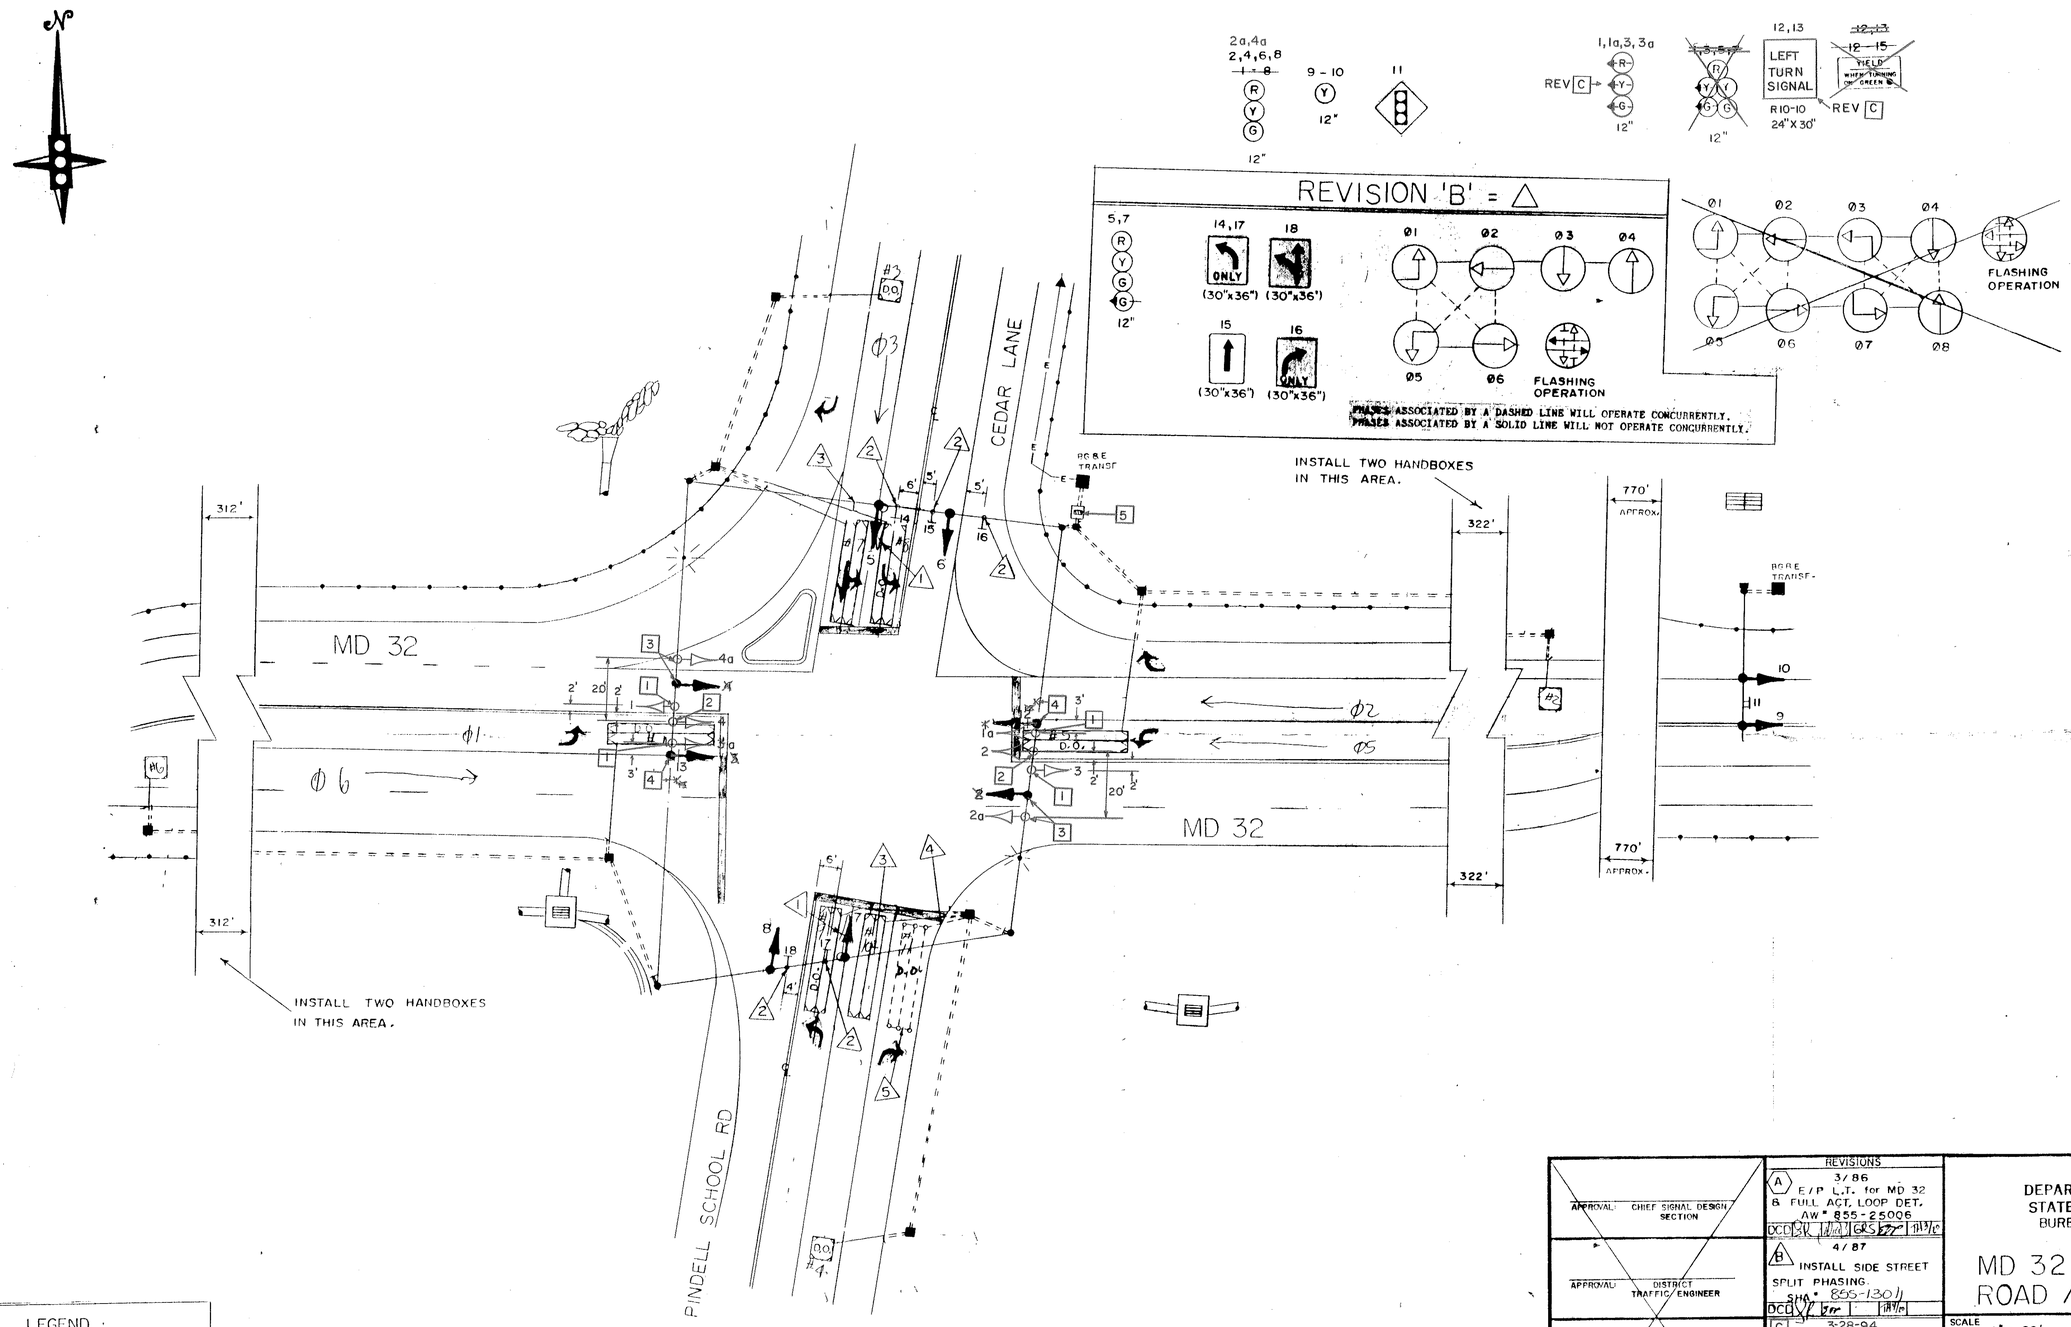

LEGEND
OF UNDERGROUND UTILITIES

—G—G—	GAS MAIN
—W—W—	WATER MAIN
—S—S—	SEWER MAIN
—E—E—	ELECTRIC CABLES
—T—T—	TELEPHONE CABLES
—C—C—	CABLE TELEVISION
—A—A—	AERIAL CABLES

APPROVAL: CHIEF SIGNAL DESIGN SECTION

APPROVAL: DISTRICT TRAFFIC ENGINEER

APPROVAL: CHIEF - BUREAU OF TRAFFIC ENGINEERING

APPROVAL: DEPUTY CHIEF ENGINEER OFFICE OF TRAFFIC

REVISIONS

A 3/86
E/P L.T. for MD 32 & FULL ACT. LOOP DET.
AW # 855-25006
DCD SV JJ/AJ GRS 3/17/86

B 4/87
INSTALL SIDE STREET SPLIT PHASING.
SHA # 855-13011
DCD SV JJ/AJ

C 3-28-94
CHANGE E/P L.T.S TO EXCLUSIVE
D.J.D

STATE OF MARYLAND
DEPARTMENT OF TRANSPORTATION
STATE HIGHWAY ADMINISTRATION
BUREAU OF TRAFFIC ENGINEERING
OFFICE OF TRAFFIC

MD 32 & PINDELL SCHOOL ROAD / CEDAR LANE

SCALE 1" = 20' DATE 9/85 CONTRACT NO. 855 - 26000

DRAWN BY: D DISTANCE COUNTY: HOWARD

DESIGNED BY: Donald Distance SIGNAL NO.: 13158, 13159

CHECKED BY: 3/14/86

DRAWING NO. TS-2152 C

1300320747