F H WA REGION NO	STATE	FED. AID PROJ. NO	SHEET NO.	TOTAL SHEETS
3	MD.			

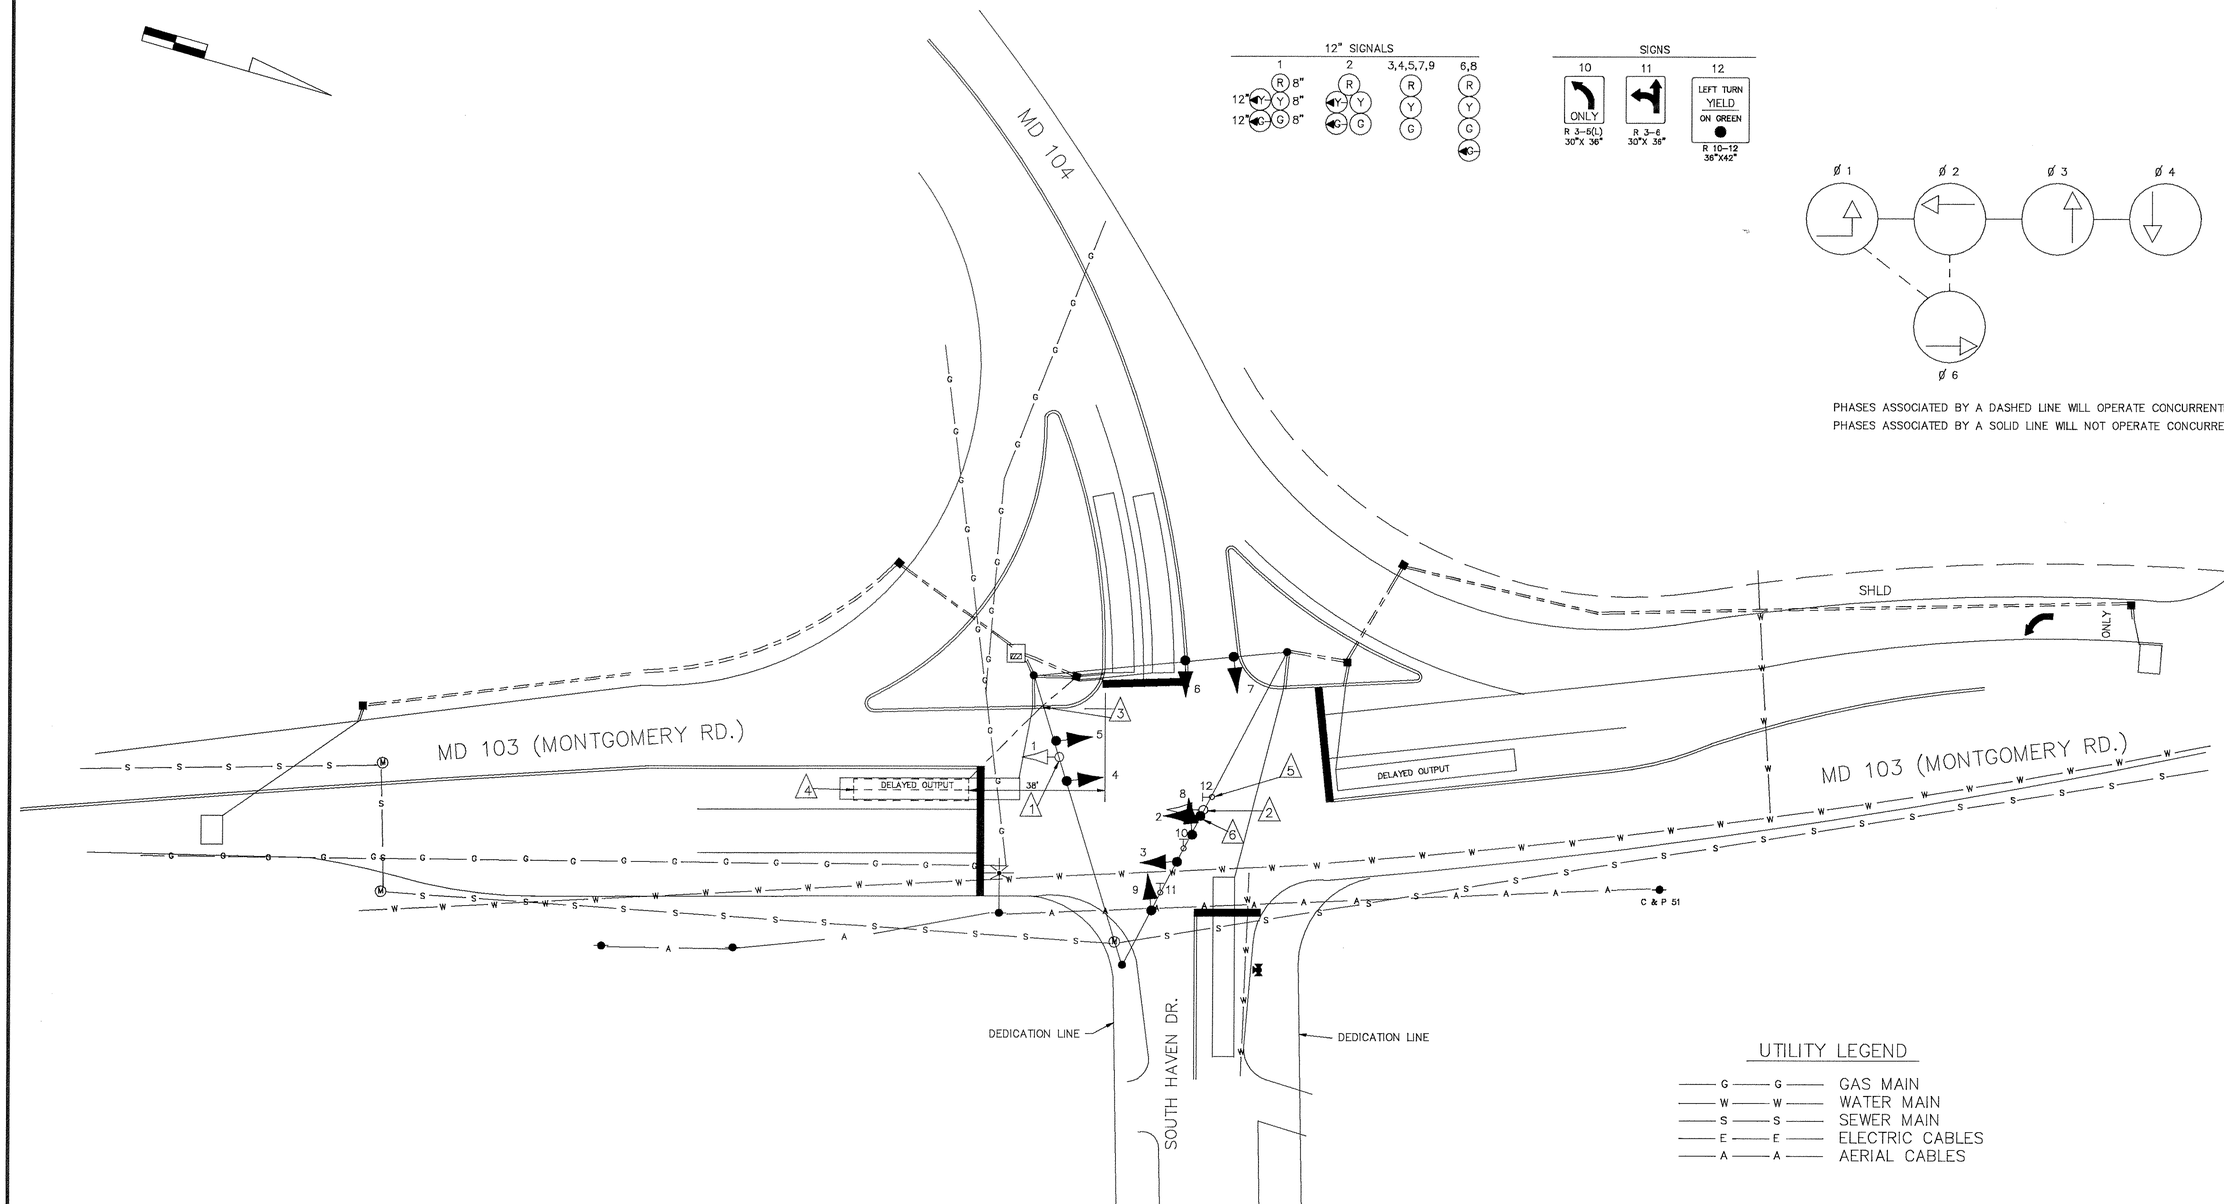

REVISIONS	APPROVALS
A 1-22-79 ASBUILT TEMPORARY SIGNAL HO-532-501-785 JG	CHIEF, SIGNAL DESIGN SECTION
B 5-31-79 REVISED TO INCLUDE ULTIMATE SIGNAL DESIGN JG	ASST. DISTRICT ENGINEER, TRAFFIC
C 2-20-90 INSTALL 4 SECTION SIGNAL HEADS SIDE STREETS AND SPLIT PHASING DLA DJD	CHIEF, TRAFFIC ENGINEERING DIVISION
9/90 INSTALL W/B E/P LEFT TURN PHASE	DEPUTY CHIEF ENGINEER, OFFICE OF TRAFFIC

NOTE: THIS IS A REVISION TO S.H.A. CONTRACT NO. HO-532-501-785 5-31-79 THE ORIGINAL IS ON FILE

MARYLAND DEPARTMENT OF TRANSPORTATION
STATE HIGHWAY ADMINISTRATION – OFFICE OF TRAFFIC
TRAFFIC ENGINEERING DIVISION

DRAWN BY BRUCE THOMPSON
DES. BY:
CHK. BY:

MD 103 at MD 104/SOUTH HAVEN DR.

COUNTY: HOWARD

DATE: REDRAWN 9-8-90
SCALE: 1"=20'

F.A.P. NO.
S.H.A. NO. HO-532-501-785

TS/FILE NO. 1520 D

SHEET NO. ____ OF ____

13010304.26