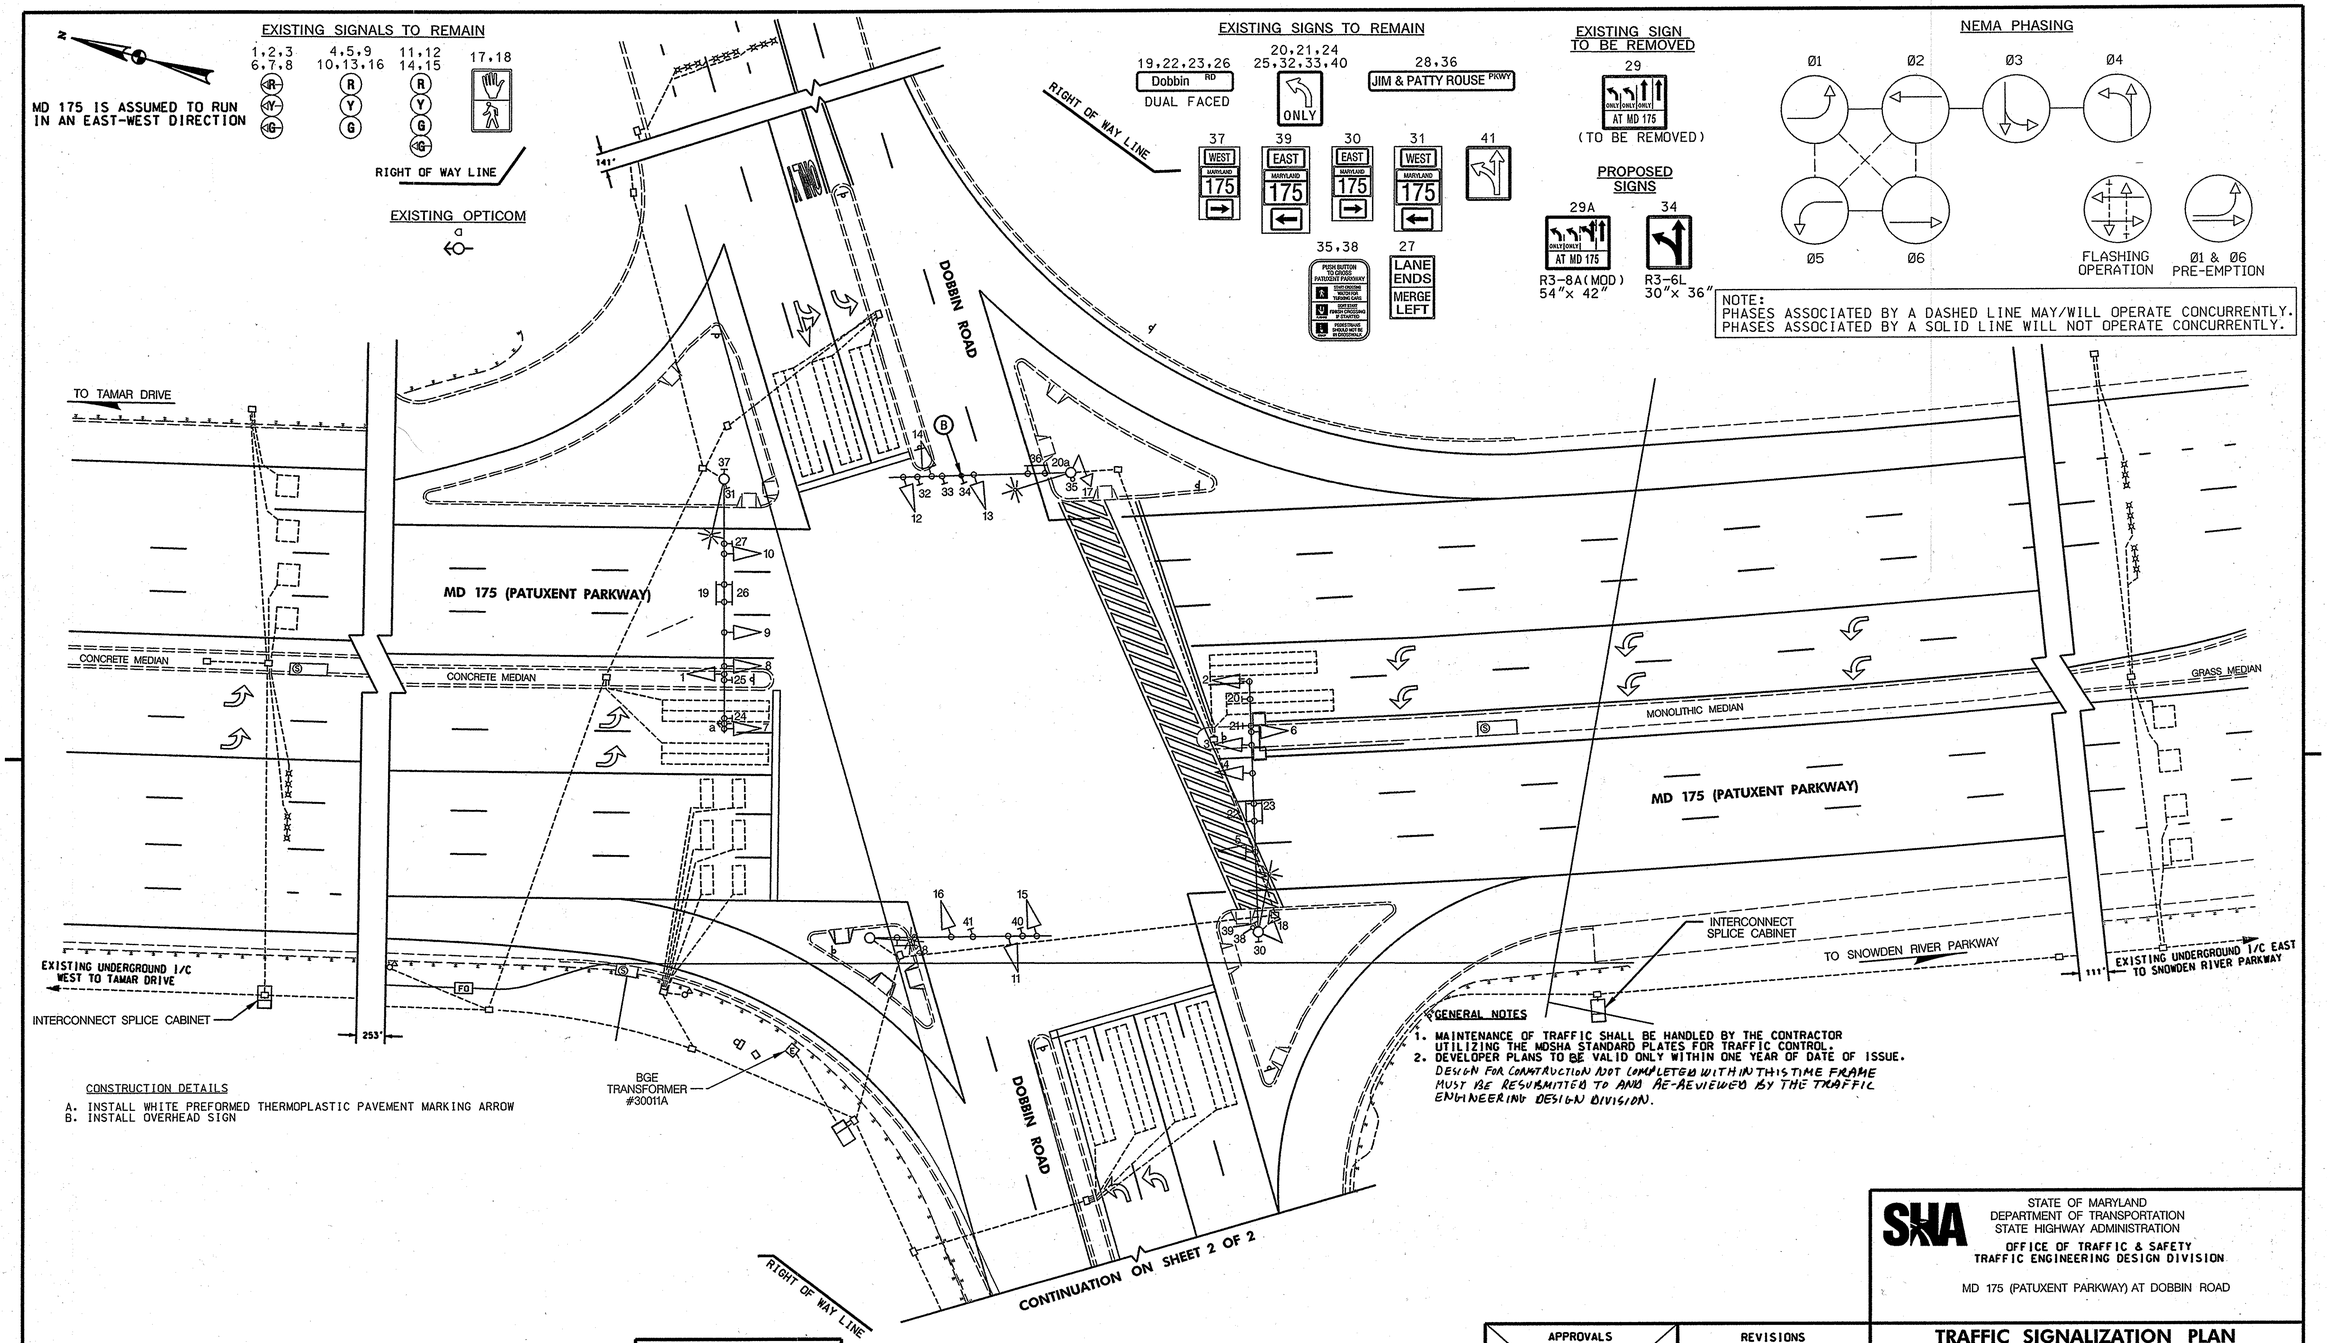

CONSTRUCTION DETAILS

A. INSTALL WHITE PREFORMED THERMOPLASTIC PAVEMENT MARKING ARROW
B. INSTALL OVERHEAD SIGN

GENERAL NOTES

1. MAINTENANCE OF TRAFFIC SHALL BE HANDLED BY THE CONTRACTOR UTILIZING THE MOSHA STANDARD PLATES FOR TRAFFIC CONTROL.
2. DEVELOPER PLANS TO BE VALID ONLY WITHIN ONE YEAR OF DATE OF ISSUE. DESIGN FOR CONSTRUCTION NOT COMPLETED WITHIN THIS TIME FRAME MUST BE RESUBMITTED TO AND RE-REVIEWED BY THE TRAFFIC ENGINEERING DESIGN DIVISION.

GEOMETRIC LEGEND

PROPOSED
EXISTING

UTILITY LEGEND

E	ELECTRIC CABLES	SD	STORM DRAIN
A	AERIAL CABLES	G	GAS MAIN
T	TELEPHONE CABLES	W	WATER MAIN
F	FIBER-OPTIC	S	SEWER MAIN

WELLS & ASSOCIATES, LLC.
TRANSPORTATION, TRAFFIC, AND PARKING CONSULTANTS
5 West Street S.W., Suite 300, Leesburg, Virginia 20176
Phone: 703/443-1442 Facsimile: 703/443-1228
1420 Spring Hill Road, Suite 600, McLean, Virginia 22102
Phone: 703/917-6620 Facsimile: 703/917-0739

BY: $USERNAME$

APPROVALS

TEAM LEADER
ASST. DIV. CHIEF
DIVISION CHIEF
OFFICE DIRECTOR

ORIGINAL ON FILE

REVISIONS

B	MODIFY LANE USE TO INCORPORATE THRU/LEFT ON EASTBOUND DOBBIN RD SHA No.1	5/2007	
JP			
G	12-16-02 ASBUILT FOR RED LIGHT CAMERA INSTALLATION SHA No.1		
RRZ			
F	1-3-01 ASBUILT SHA No.BW995M82		
FJH			

PLOTTED: $DATETIME$
FILE: $FILE$

STATE OF MARYLAND
DEPARTMENT OF TRANSPORTATION
STATE HIGHWAY ADMINISTRATION
OFFICE OF TRAFFIC & SAFETY
TRAFFIC ENGINEERING DESIGN DIVISION

MD 175 (PATUXENT PARKWAY) AT DOBBIN ROAD

TRAFFIC SIGNALIZATION PLAN

SCALE 1" = 20' DATE 3/16/1996 CONTRACT NO. HO-400-501-785

DESIGNED BY
DRAWN BY J.G./D.ZAFIRIS
CHECKED BY
F.A.P. NO.

COUNTY HOWARD
LOGMILE 13017504.18
T.I.M.S. NO. 1267
TOD NO.

DRAWING NO. TS-1396H OF SHEET NO. 1 OF 2

Sheet 1_REV.dgn 05/08/2007 7:27:29 AM