

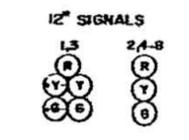


**NOTE:**  
 THE METER FOR SIGNAL SERVICE AND THE DOUBLE DISCONNECT SWITCH FOR SIGNALS AND STREET LIGHTING WILL BE ATTACHED TO CABINET

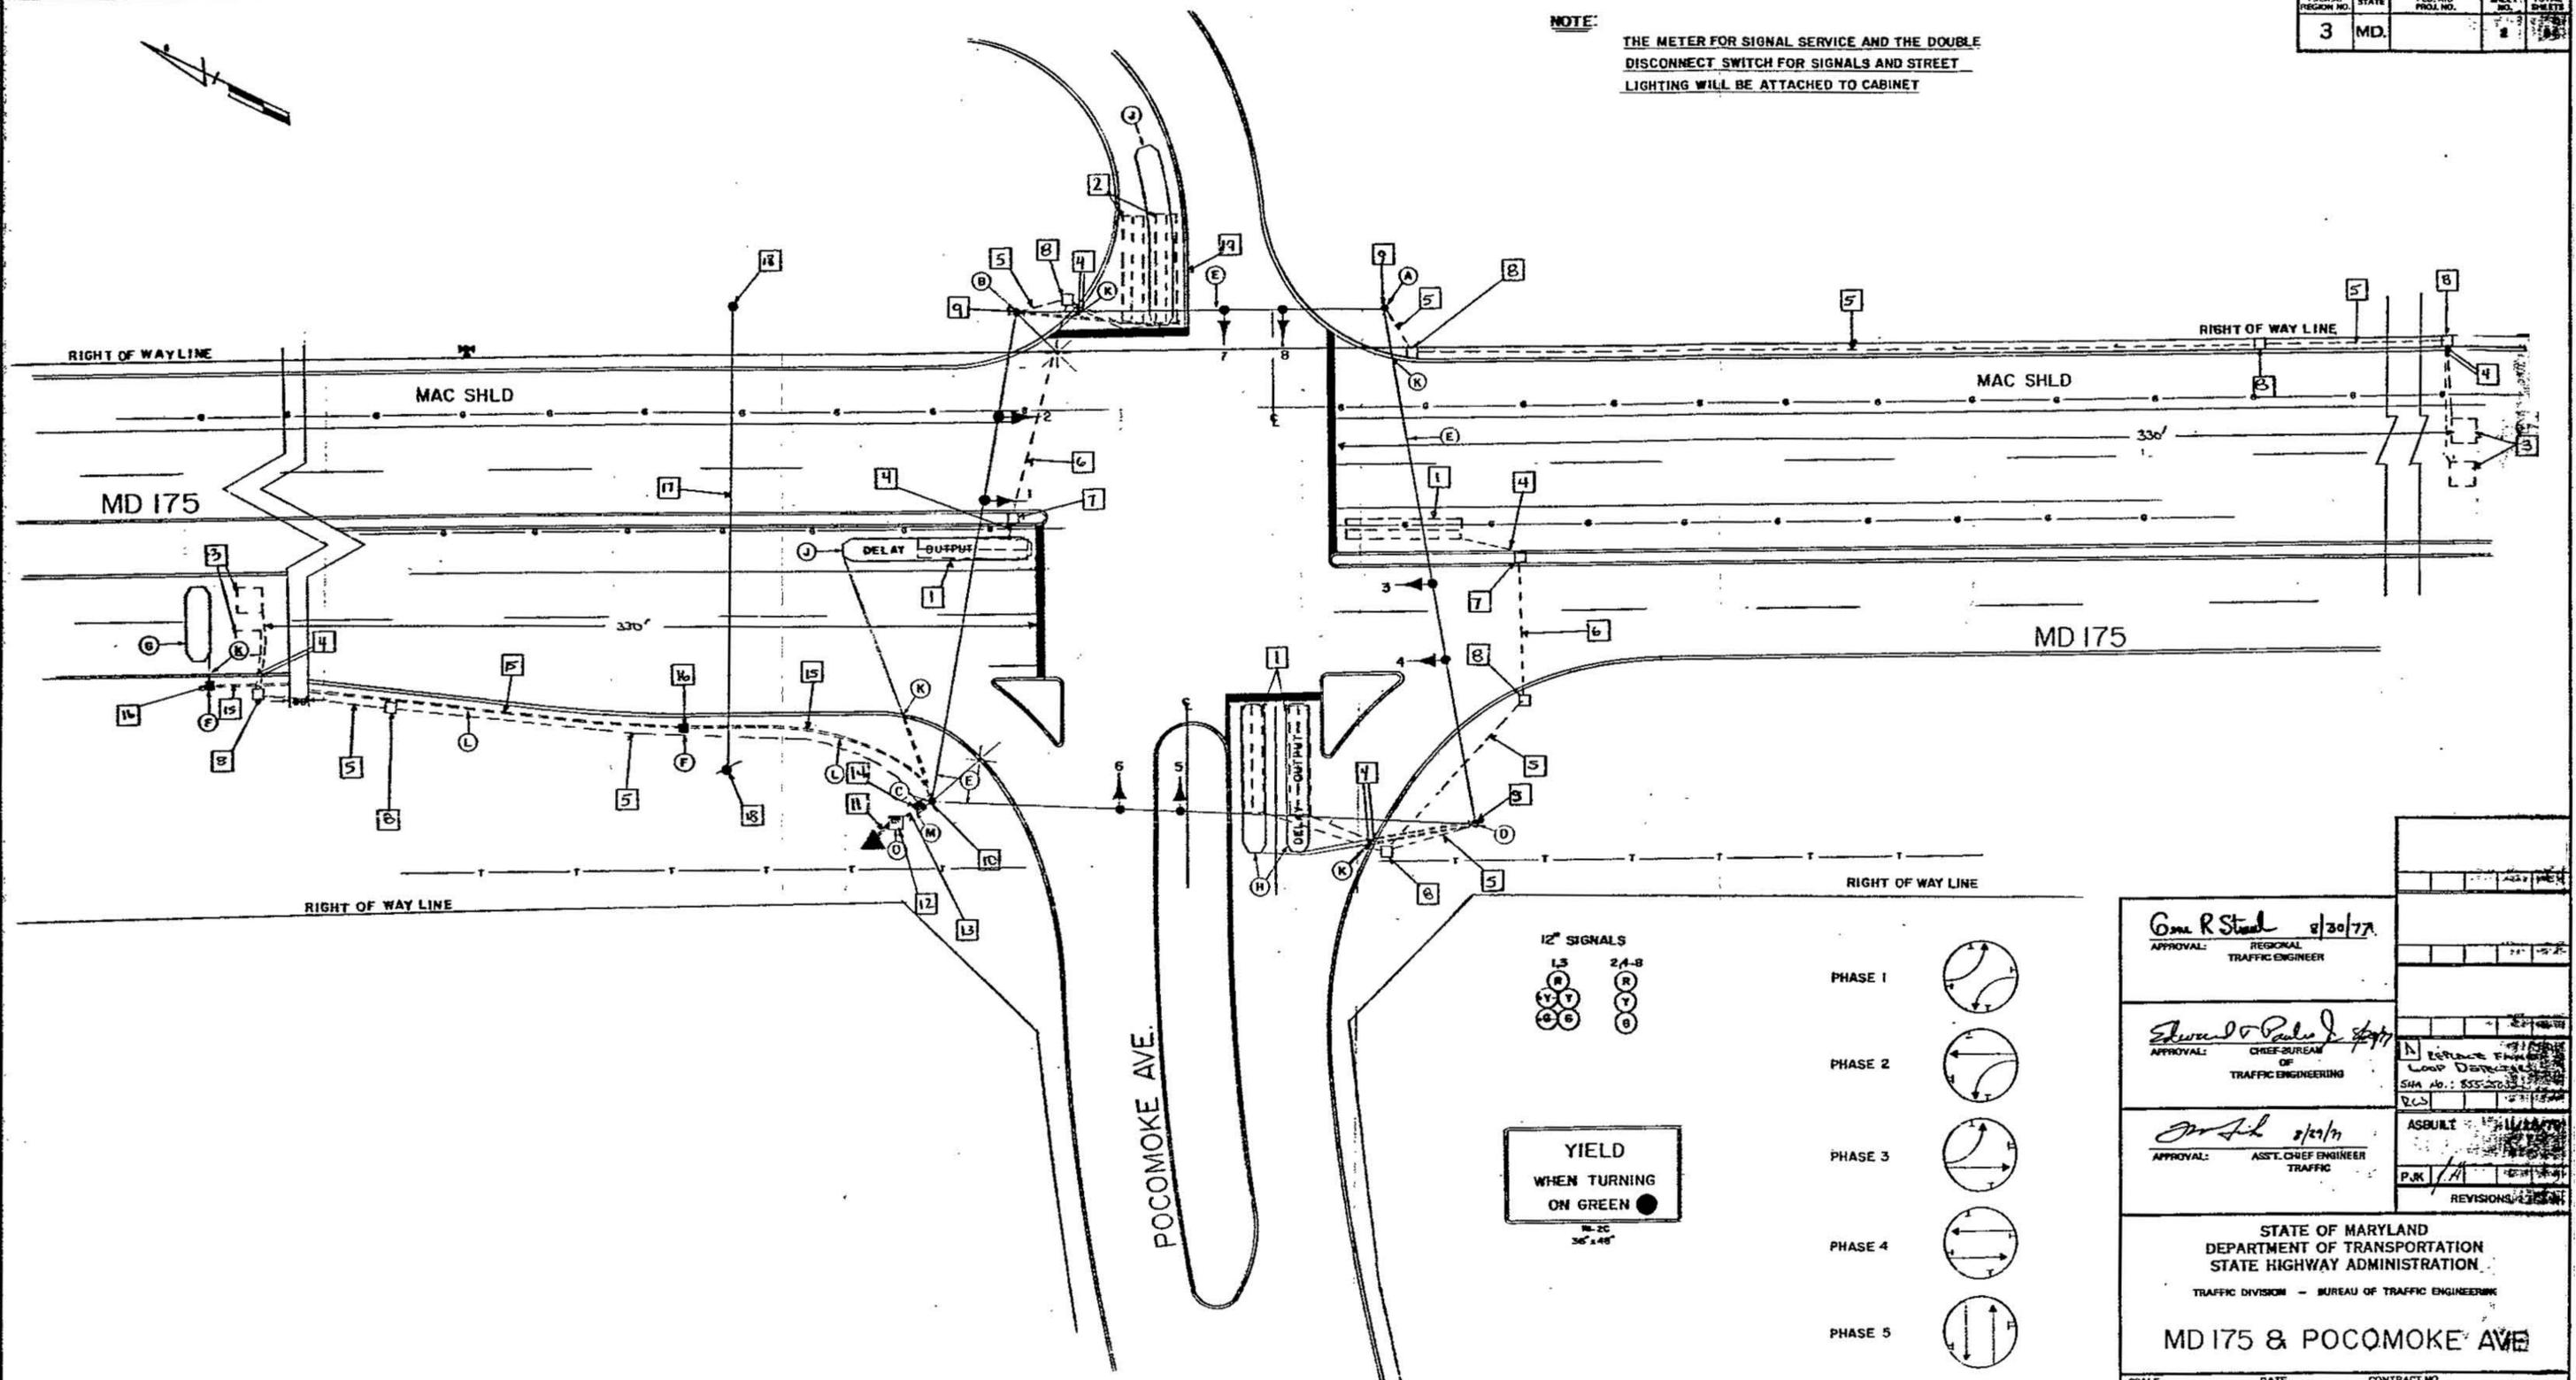

**YIELD**  
 WHEN TURNING  
 ON GREEN ●

18-2C  
 36" x 48"

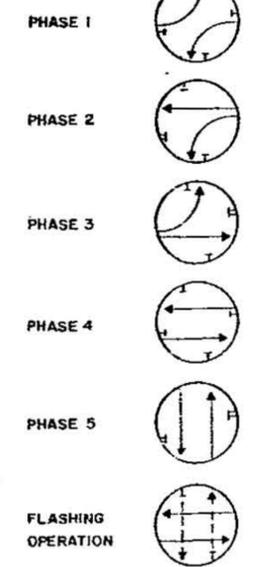

*G. R. Stued* 8/30/77  
 APPROVAL: REGIONAL TRAFFIC ENGINEER

*Edward J. Paul*  
 APPROVAL: CHIEF-BUREAU OF TRAFFIC ENGINEERING

*J. Gordon* 8/29/77  
 APPROVAL: ASST. CHIEF ENGINEER TRAFFIC

STATE OF MARYLAND  
 DEPARTMENT OF TRANSPORTATION  
 STATE HIGHWAY ADMINISTRATION  
 TRAFFIC DIVISION - BUREAU OF TRAFFIC ENGINEERING

MD 175 & POCOMOKE AVE

SCALE: 1" = 20' DATE: 2-22-77 CONTRACT NO.

DRAWN BY: J GORDON COUNTY: HOWARD

DESIGNED BY: *J. Gordon* SIGNAL NO.

CHECKED BY: *William A. Landon* DRAWING NO. 12-51

**TS-1500A**

13017501125