F.H.W.A. REGION NO.	STATE	FED. AID PROJ. NO.	SHEET NO.	TOTAL SHEETS
3	MD.			

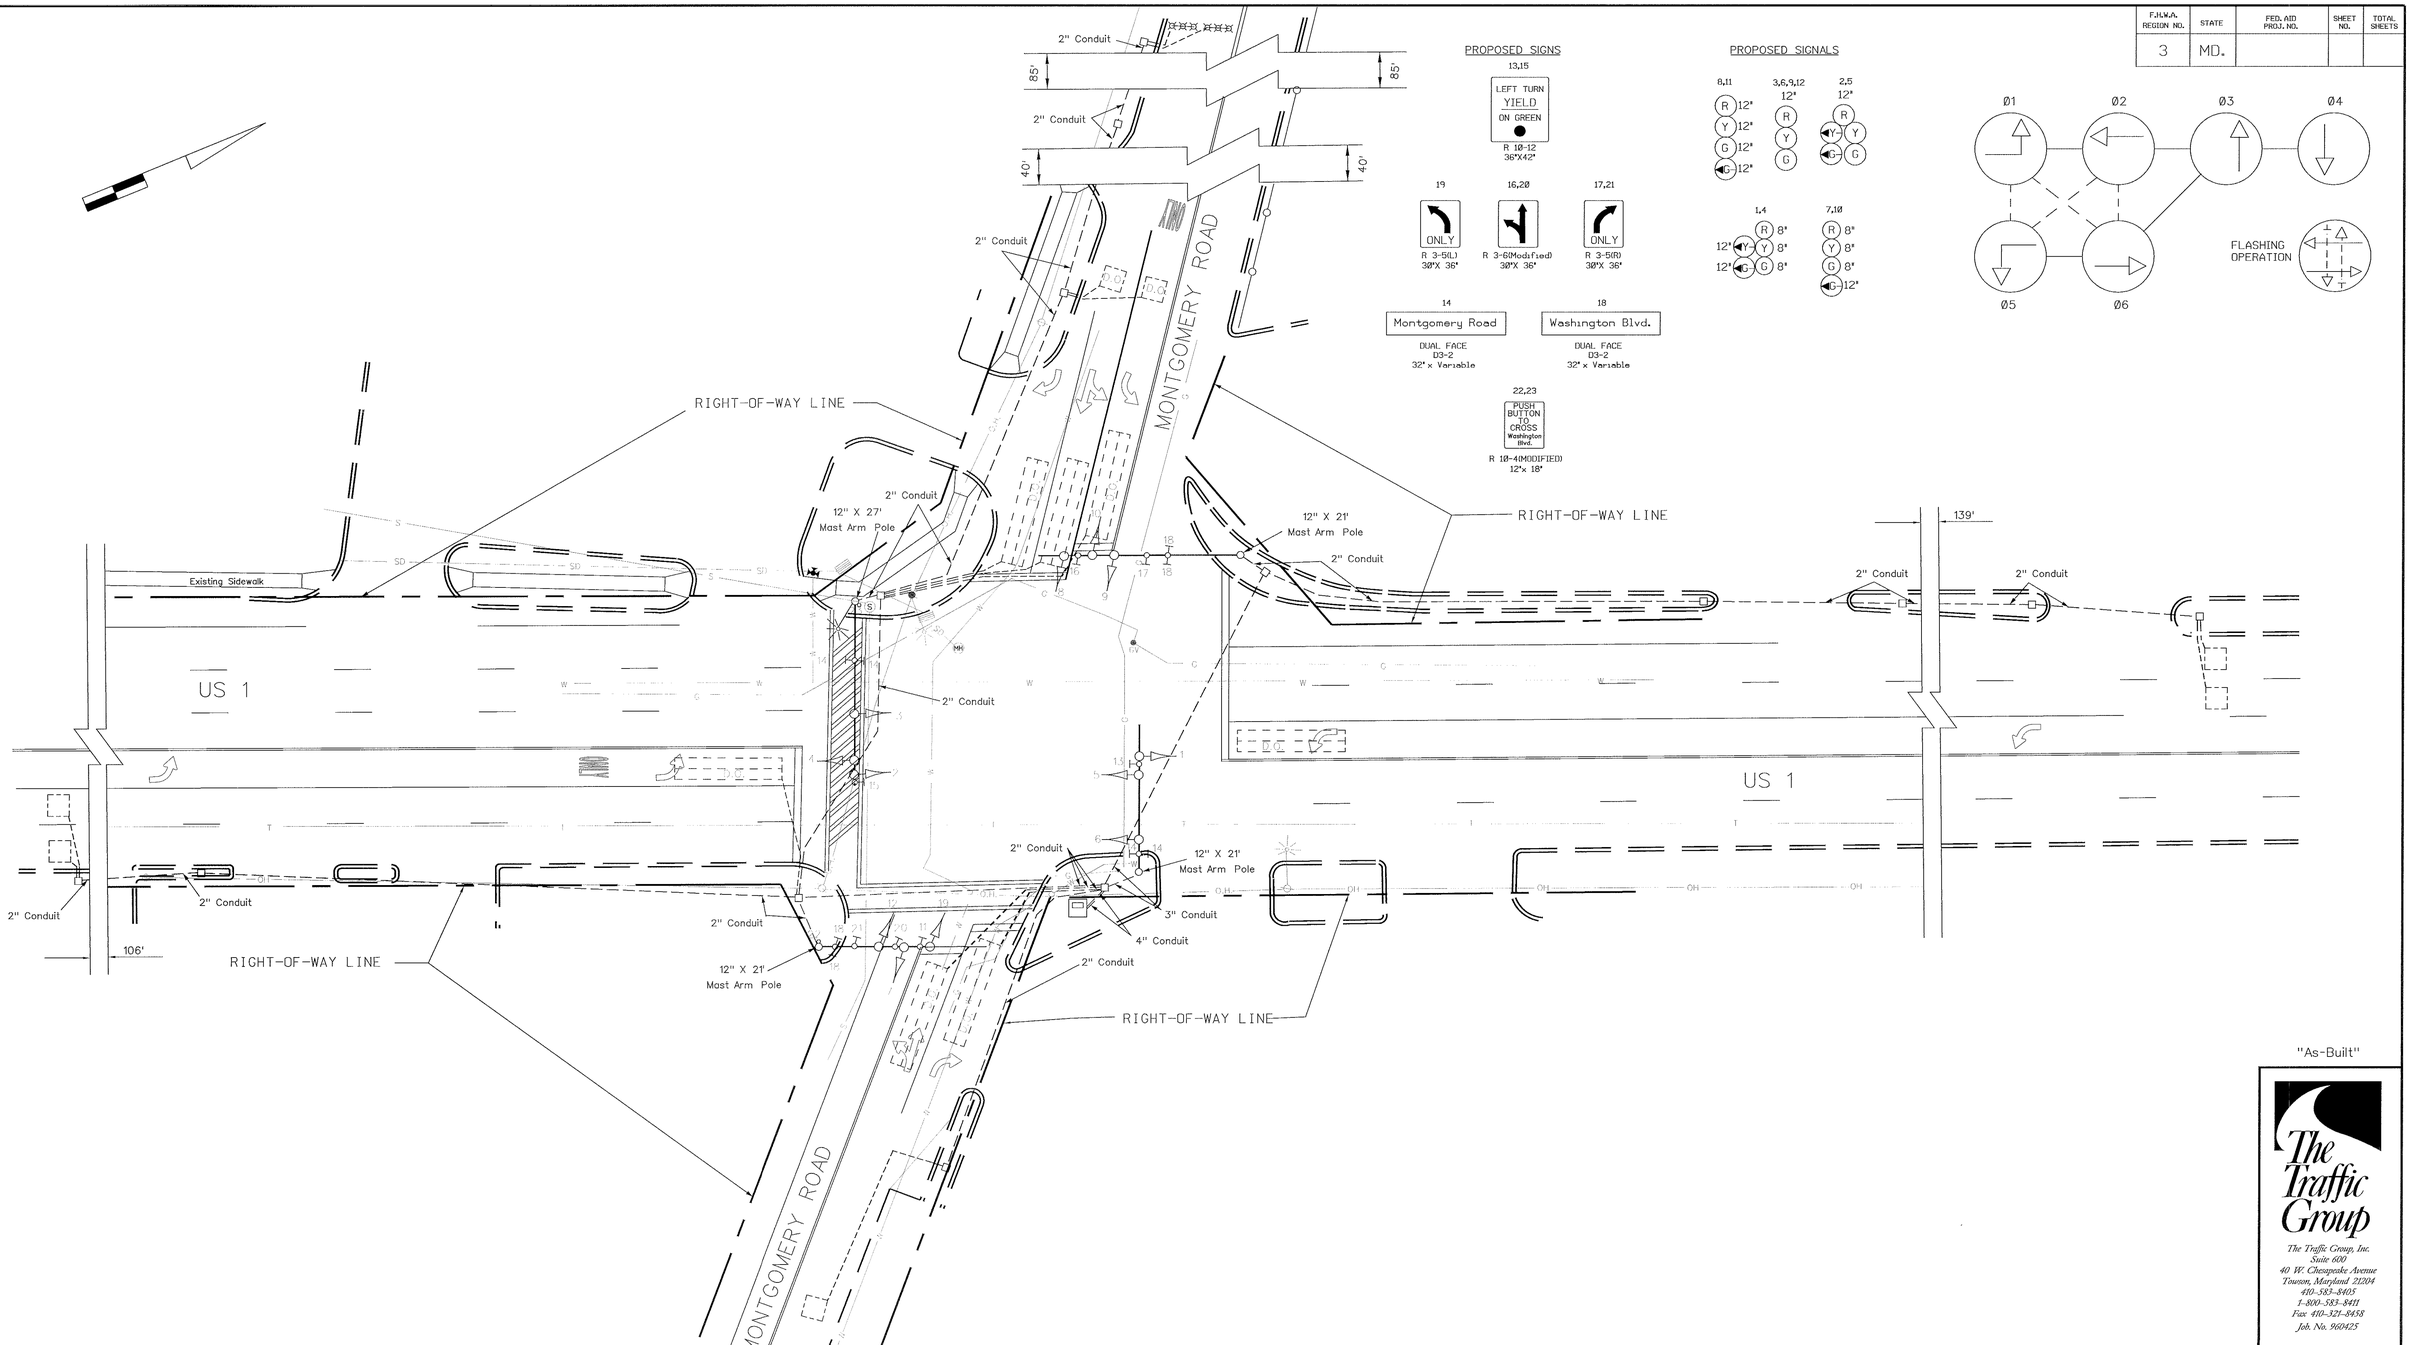

"As-Built"

The Traffic Group

The Traffic Group, Inc.
Suite 600
40 W. Chesapeake Avenue
Towson, Maryland 21204
410-583-8405
1-800-583-8411
Fax 410-321-8458
Job. No. 960425

UNDERGROUND UTILITIES

ELECTRIC	E
TELEPHONE	T
GAS	G
SEWER	S
WATER	W
CABLE TV	TV

TRAFFIC CONCEPTS, INC.
405 Headquarters Drive
Suite 7
Millersville, MD 21108
(410) 987-0427

REVISIONS

(F) Date: May 16, 1996
As-Built
SHA NO. AW-794-501-785
FJH

(E) Install new signal equipment due to geometric improvements
Date: May, 1994
SHA NO. AW 456- -785

APPROVALS

CHIEF, SIGNAL DESIGN SECTION
ORIGINAL
ASST. DISTRICT ENGINEER, TRAFFIC
ON
CHIEF, TRAFFIC ENGINEERING DESIGN DIVISION
FILE
DIRECTOR, OFFICE OF TRAFFIC & SAFETY

MARYLAND DEPARTMENT OF TRANSPORTATION
STATE HIGHWAY ADMINISTRATION - OFFICE OF TRAFFIC & SAFETY
TRAFFIC ENGINEERING DESIGN DIVISION

DRAWN BY: T. MANK
DES. BY:
CHK. BY:

TRAFFIC SIGNAL PLAN
US 1 AND MONTGOMERY ROAD

LOG MILE NO. 13000109.59 COUNTY: Howard

DATE:
SCALE: 1"=20'
F.A.P. NO. CMG-STPG-000S(136)
S.H.A. NO. AW 456- -785
TS/FILE NO. 452F-P
SHEET NO. 1 OF 1