F.H.WA. REGION NO.	STATE	FED. AID PROJ. NO.	SHEET NO.	TOTAL SHEETS
3	MD.	H.E.S. 000 S(58)	4	8

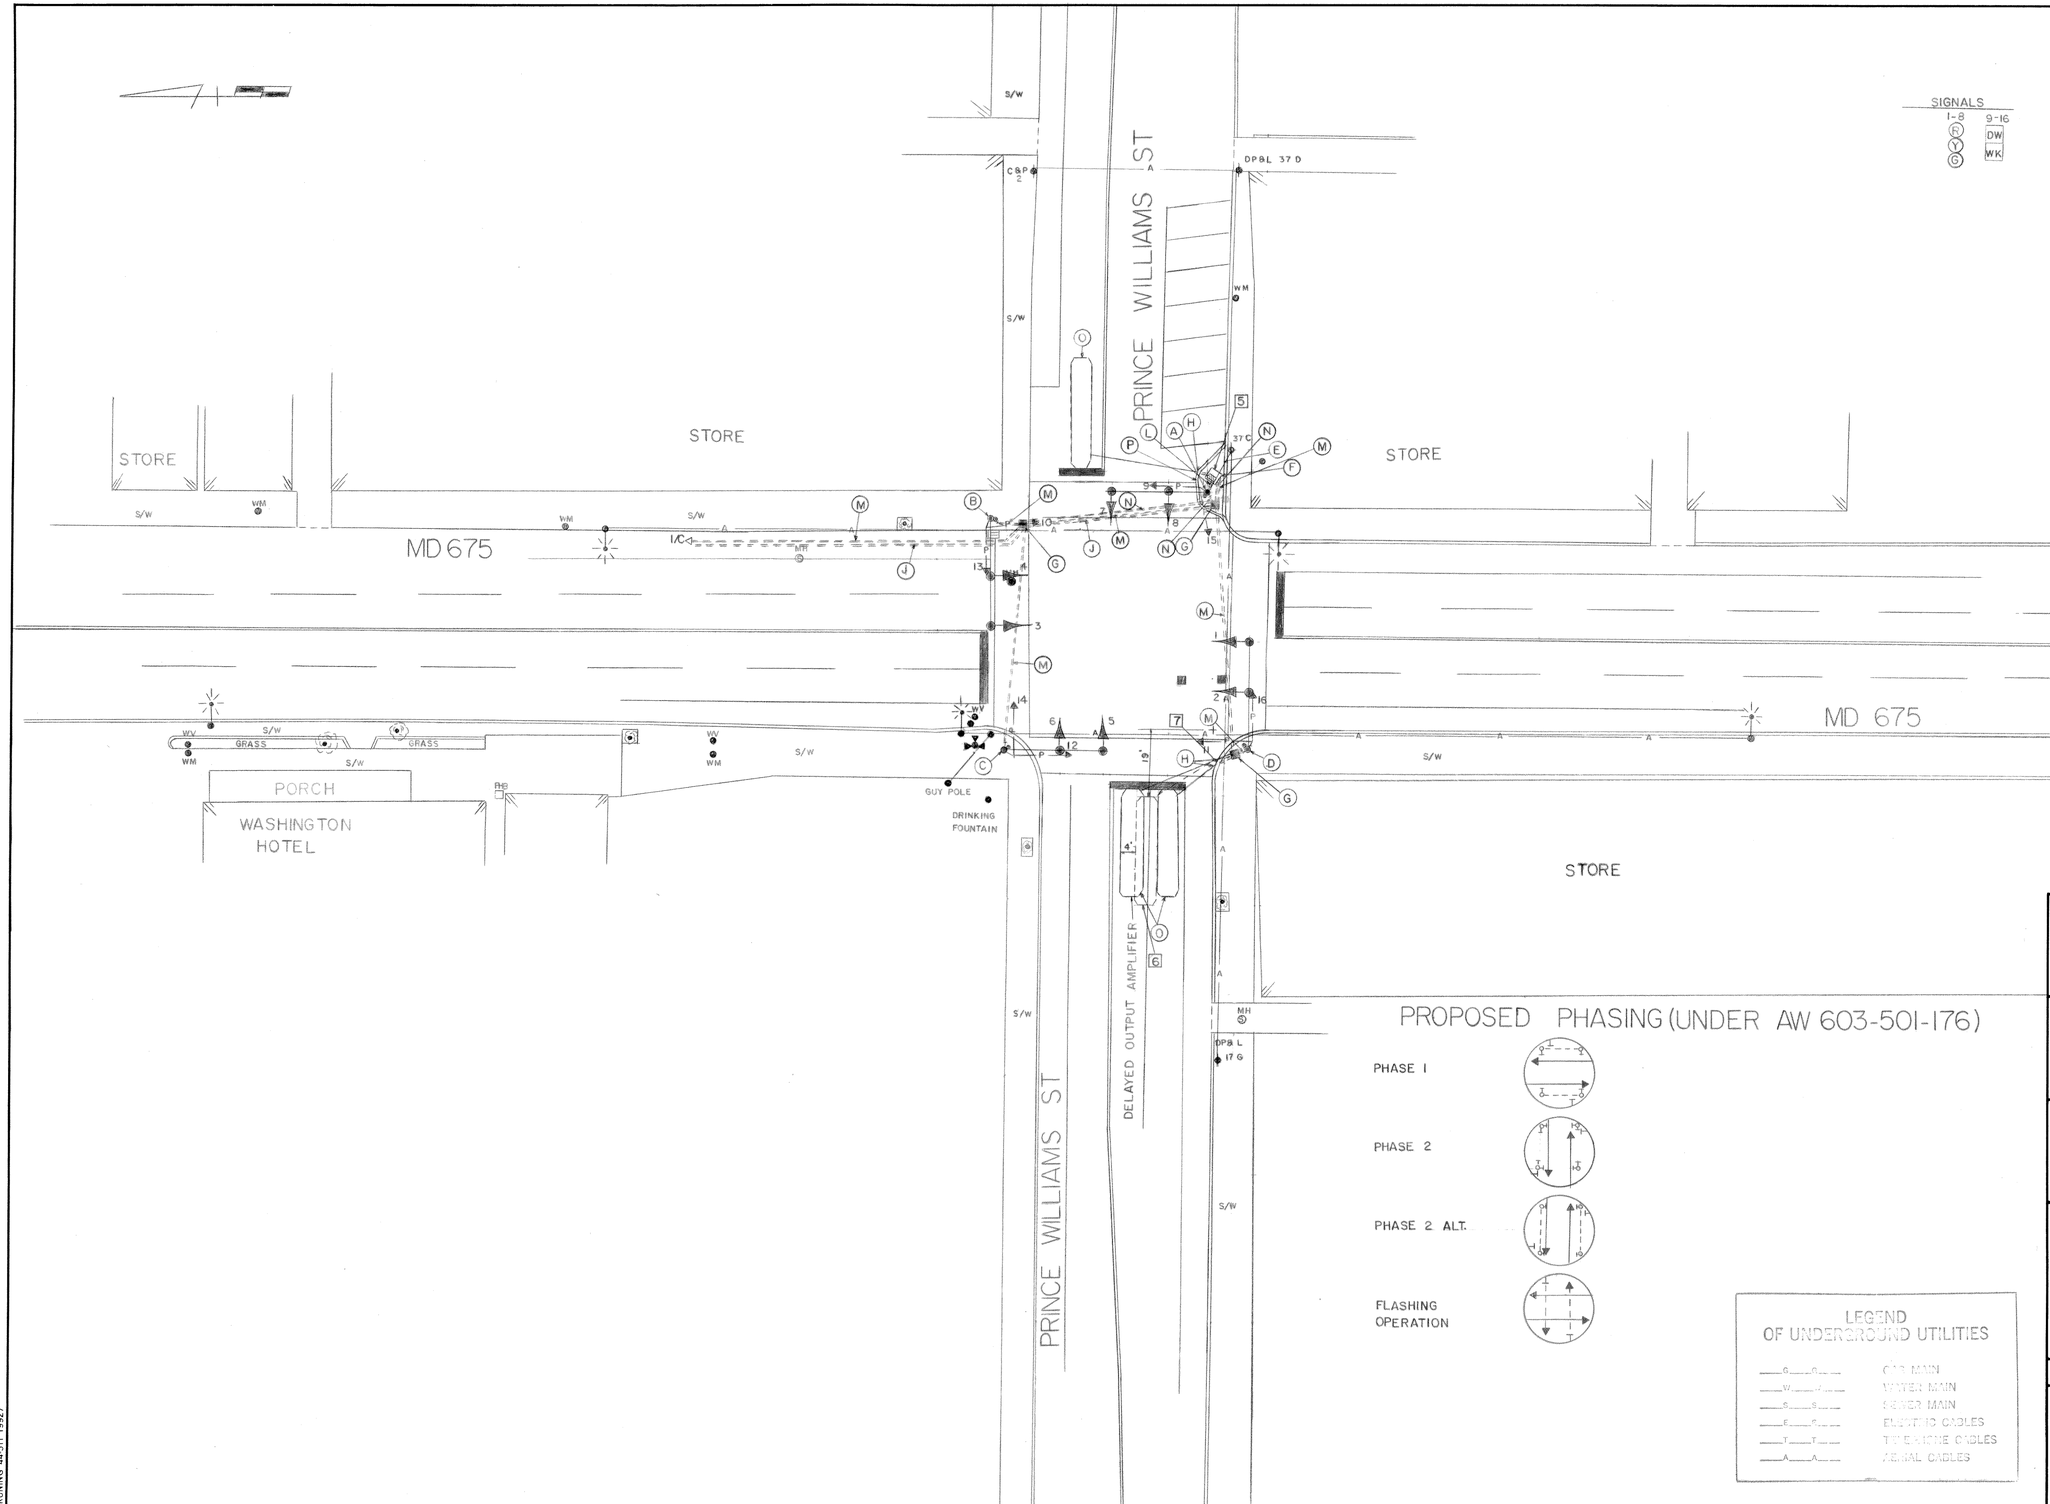

APPROVAL: REGIONAL TRAFFIC ENGINEER 11/1/76

APPROVAL: CHIEF-BUREAU OF TRAFFIC ENGINEERING 11/1/76

APPROVAL: ASS'T. CHIEF ENGINEER TRAFFIC 11/8/76

B 4-9-82 REVISED PEDESTRIAN PHASING, COORDINATION, AND LOOP PLACEMENT. AW 603-501-176

A ASBUILT 3-30-82 S 289-501-185

REVISIONS

STATE OF MARYLAND
DEPARTMENT OF TRANSPORTATION
STATE HIGHWAY ADMINISTRATION

TRAFFIC DIVISION – BUREAU OF TRAFFIC ENGINEERING

MD 675 & PRINCE WILLIAM ST.

SCALE	DATE	CONTRACT NO.
1"=20'	1-9-76	AW 603-501-176

DRAWN BY: B THOMPSON COUNTY: SOMERSET

DESIGNED BY: Bruce Thompson SIGNAL NO.: 19102

CHECKED BY: A. Bridnichuk 11/9/76

DRAWING NO. TS-1393 B

BRUNING 44-511 19927