F.H.W.A. REGION NO.	STATE	FED. AID PROJ. NO.	SHEET NO.	TOTAL SHEETS
3	MD.		3	6

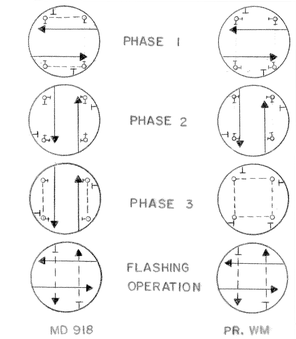

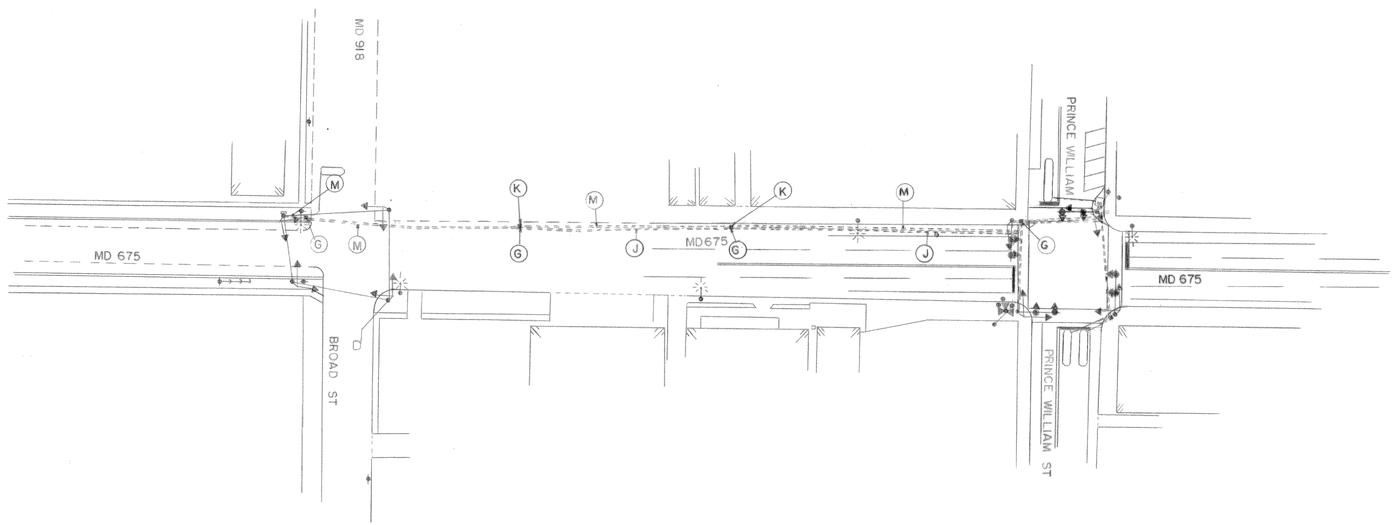

APPROVAL: REGIONAL TRAFFIC ENGINEER — 11/1/76

APPROVAL: CHIEF BUREAU OF TRAFFIC ENGINEERING — 11/1/76

APPROVAL: ASS'T. CHIEF ENGINEER TRAFFIC — 11/5/76

A ASBUILT 3-30-82 S 289-501-185

REVISIONS

STATE OF MARYLAND
DEPARTMENT OF TRANSPORTATION
STATE HIGHWAY ADMINISTRATION

TRAFFIC DIVISION – BUREAU OF TRAFFIC ENGINEERING

MD 675 FROM PRINCE WILLIAM ST TO BROAD ST

SCALE 1"=50' | DATE 6-28-76 | CONTRACT NO.

DRAWN BY: B THOMPSON | COUNTY: SOMERSET

DESIGNED BY: Bruce Thompson | SIGNAL NO.: 19100 19102

CHECKED BY: A. Budniakiuk

DRAWING NO. TS-1393XIA

BRUNING 44511 19927