F H WA REGION NO	STATE	FED. AID PROJ. NO	SHEET NO.	TOTAL SHEETS
3	MD.			

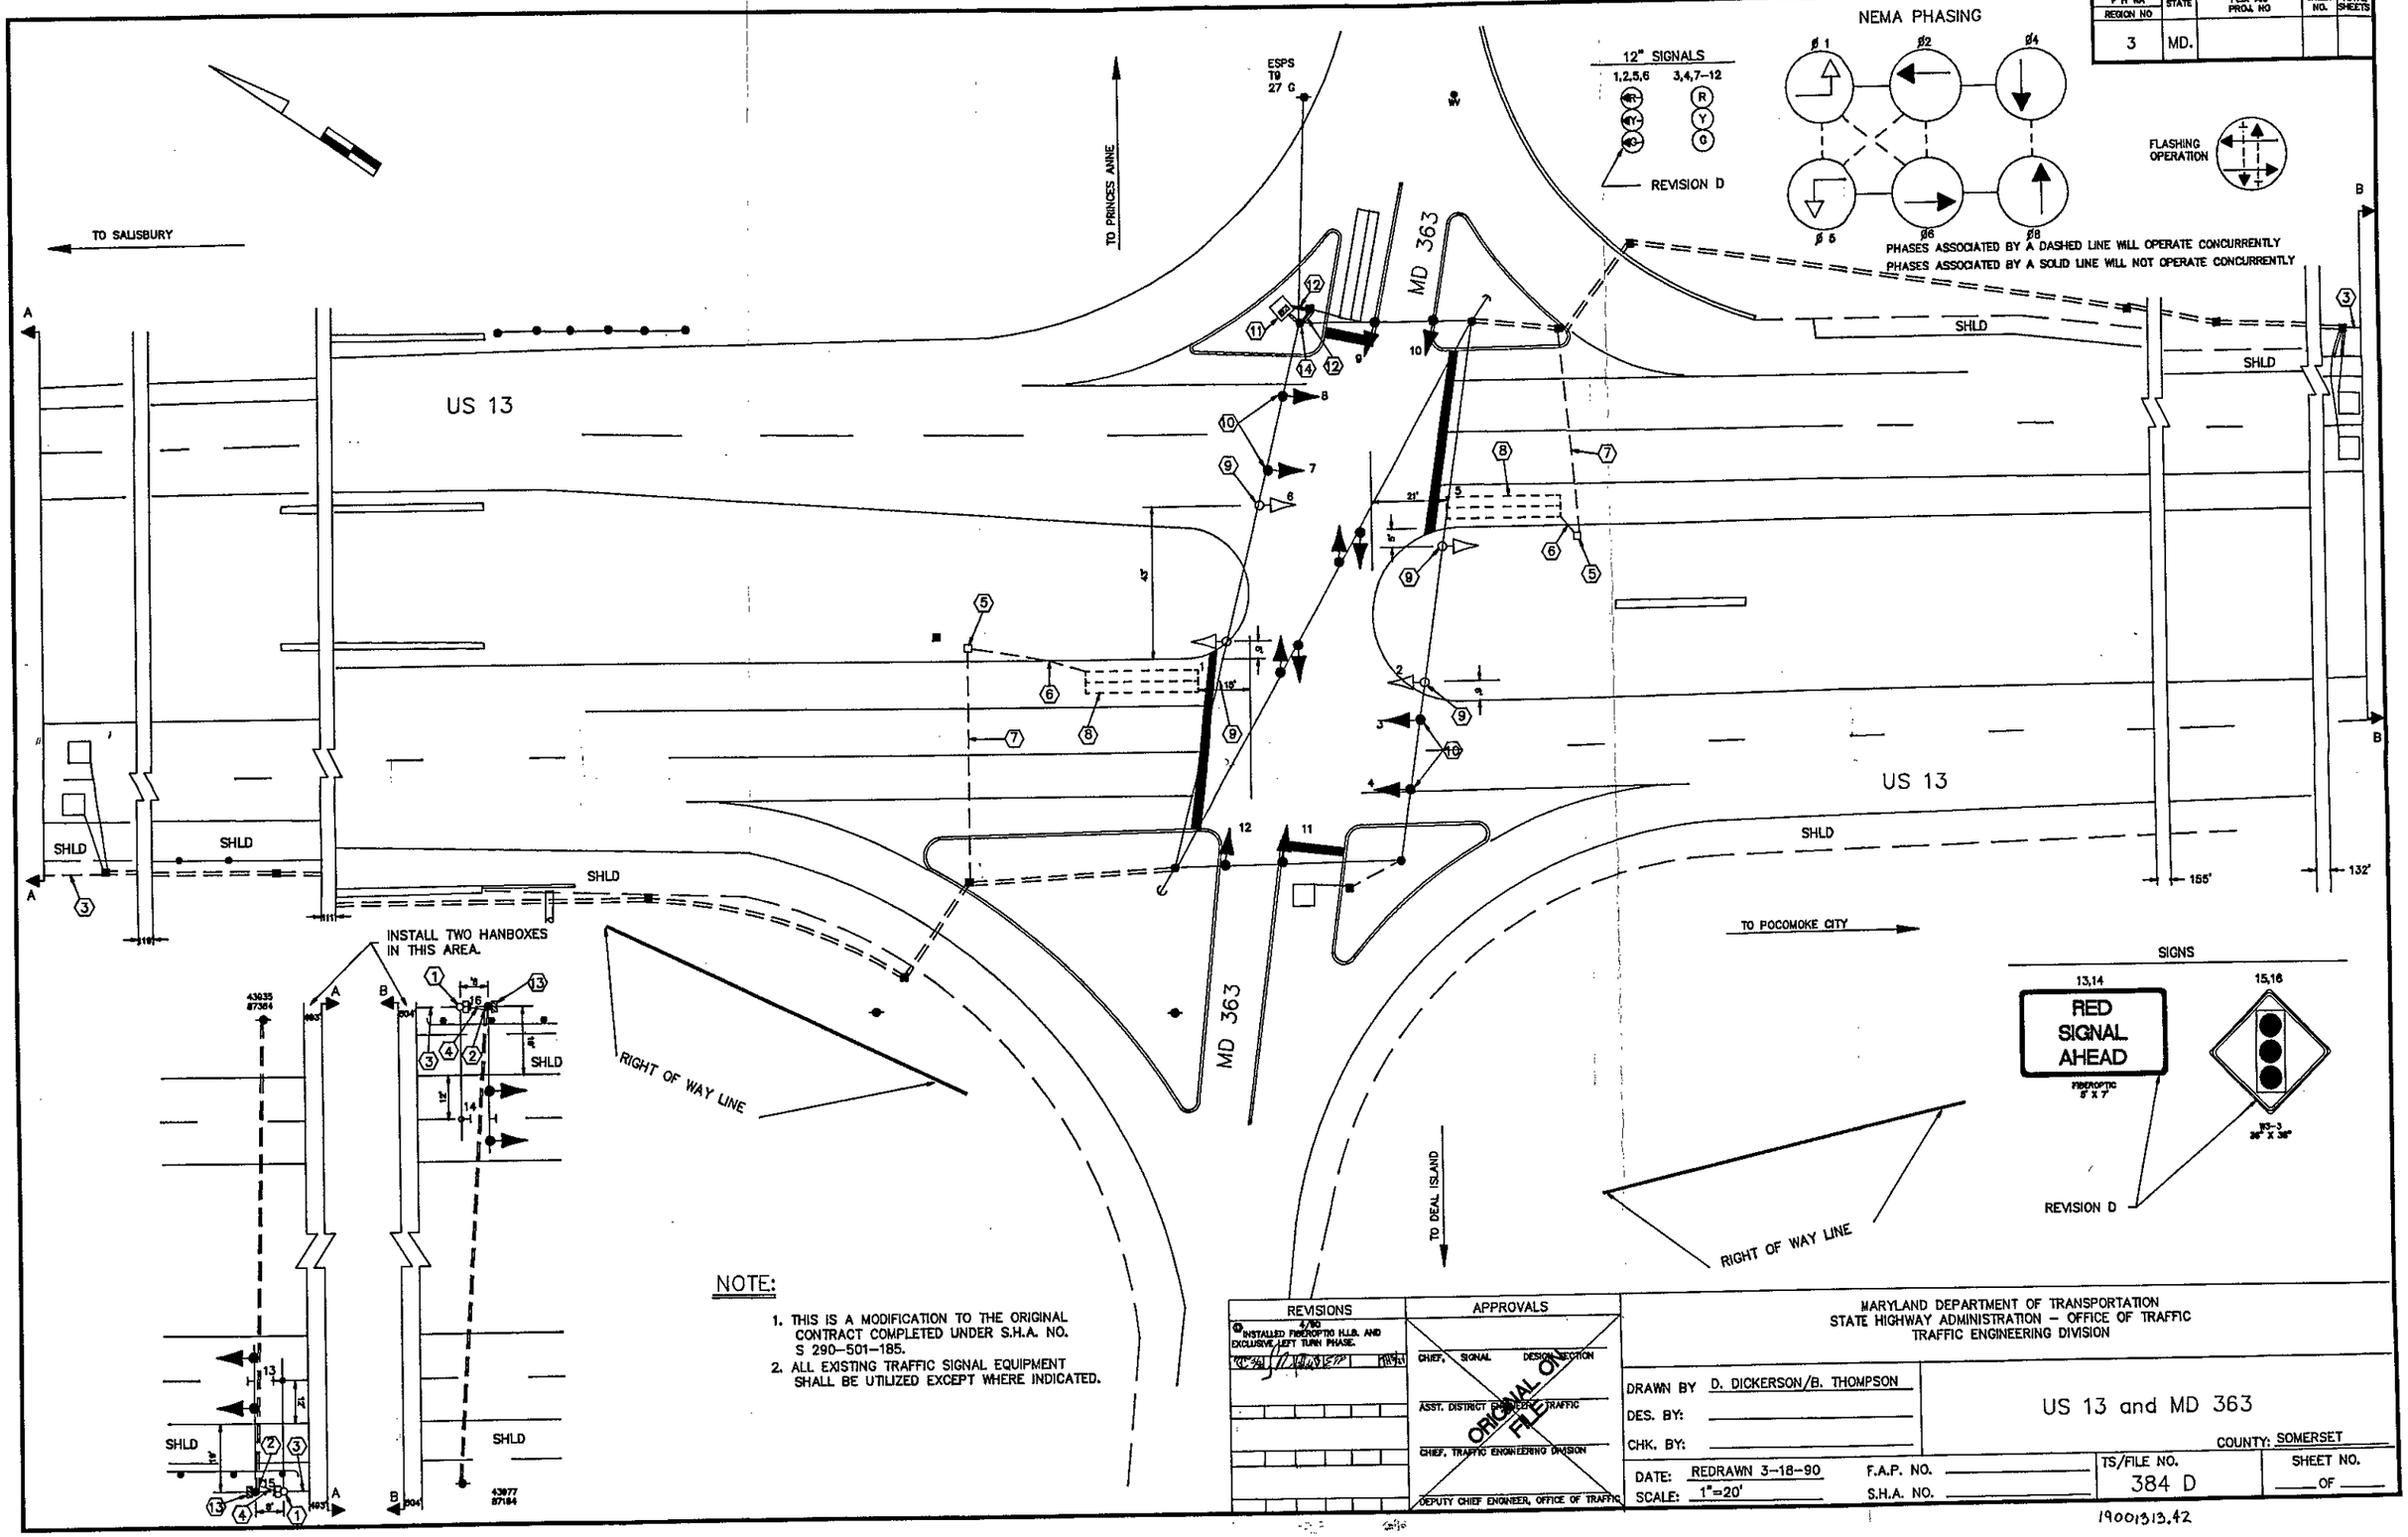

NOTE:

1. THIS IS A MODIFICATION TO THE ORIGINAL CONTRACT COMPLETED UNDER S.H.A. NO. S 290-501-185.
2. ALL EXISTING TRAFFIC SIGNAL EQUIPMENT SHALL BE UTILIZED EXCEPT WHERE INDICATED.

REVISIONS	APPROVALS
4/90 INSTALLED FIBEROPTIC H.L.B. AND EXCLUSIVE LEFT TURN PHASE.	CHIEF, SIGNAL DESIGN SECTION
	ASST. DISTRICT ENGINEER, TRAFFIC
	CHIEF, TRAFFIC ENGINEERING DIVISION
	DEPUTY CHIEF ENGINEER, OFFICE OF TRAFFIC

ORIGINAL ON FILE

MARYLAND DEPARTMENT OF TRANSPORTATION
STATE HIGHWAY ADMINISTRATION – OFFICE OF TRAFFIC
TRAFFIC ENGINEERING DIVISION

DRAWN BY D. DICKERSON/B. THOMPSON
DES. BY:
CHK. BY:
DATE: REDRAWN 3-18-90
SCALE: 1"=20'
F.A.P. NO.
S.H.A. NO.

US 13 and MD 363

COUNTY: SOMERSET

TS/FILE NO. 384 D

SHEET NO. ___ OF ___

19001313.42