F.H.W.A. REGION NO.	STATE	FED. AID PROJ. NO.	SHEET NO.	TOTAL SHEETS
3	MD.	TQF-RF-129-1(2)	4	7

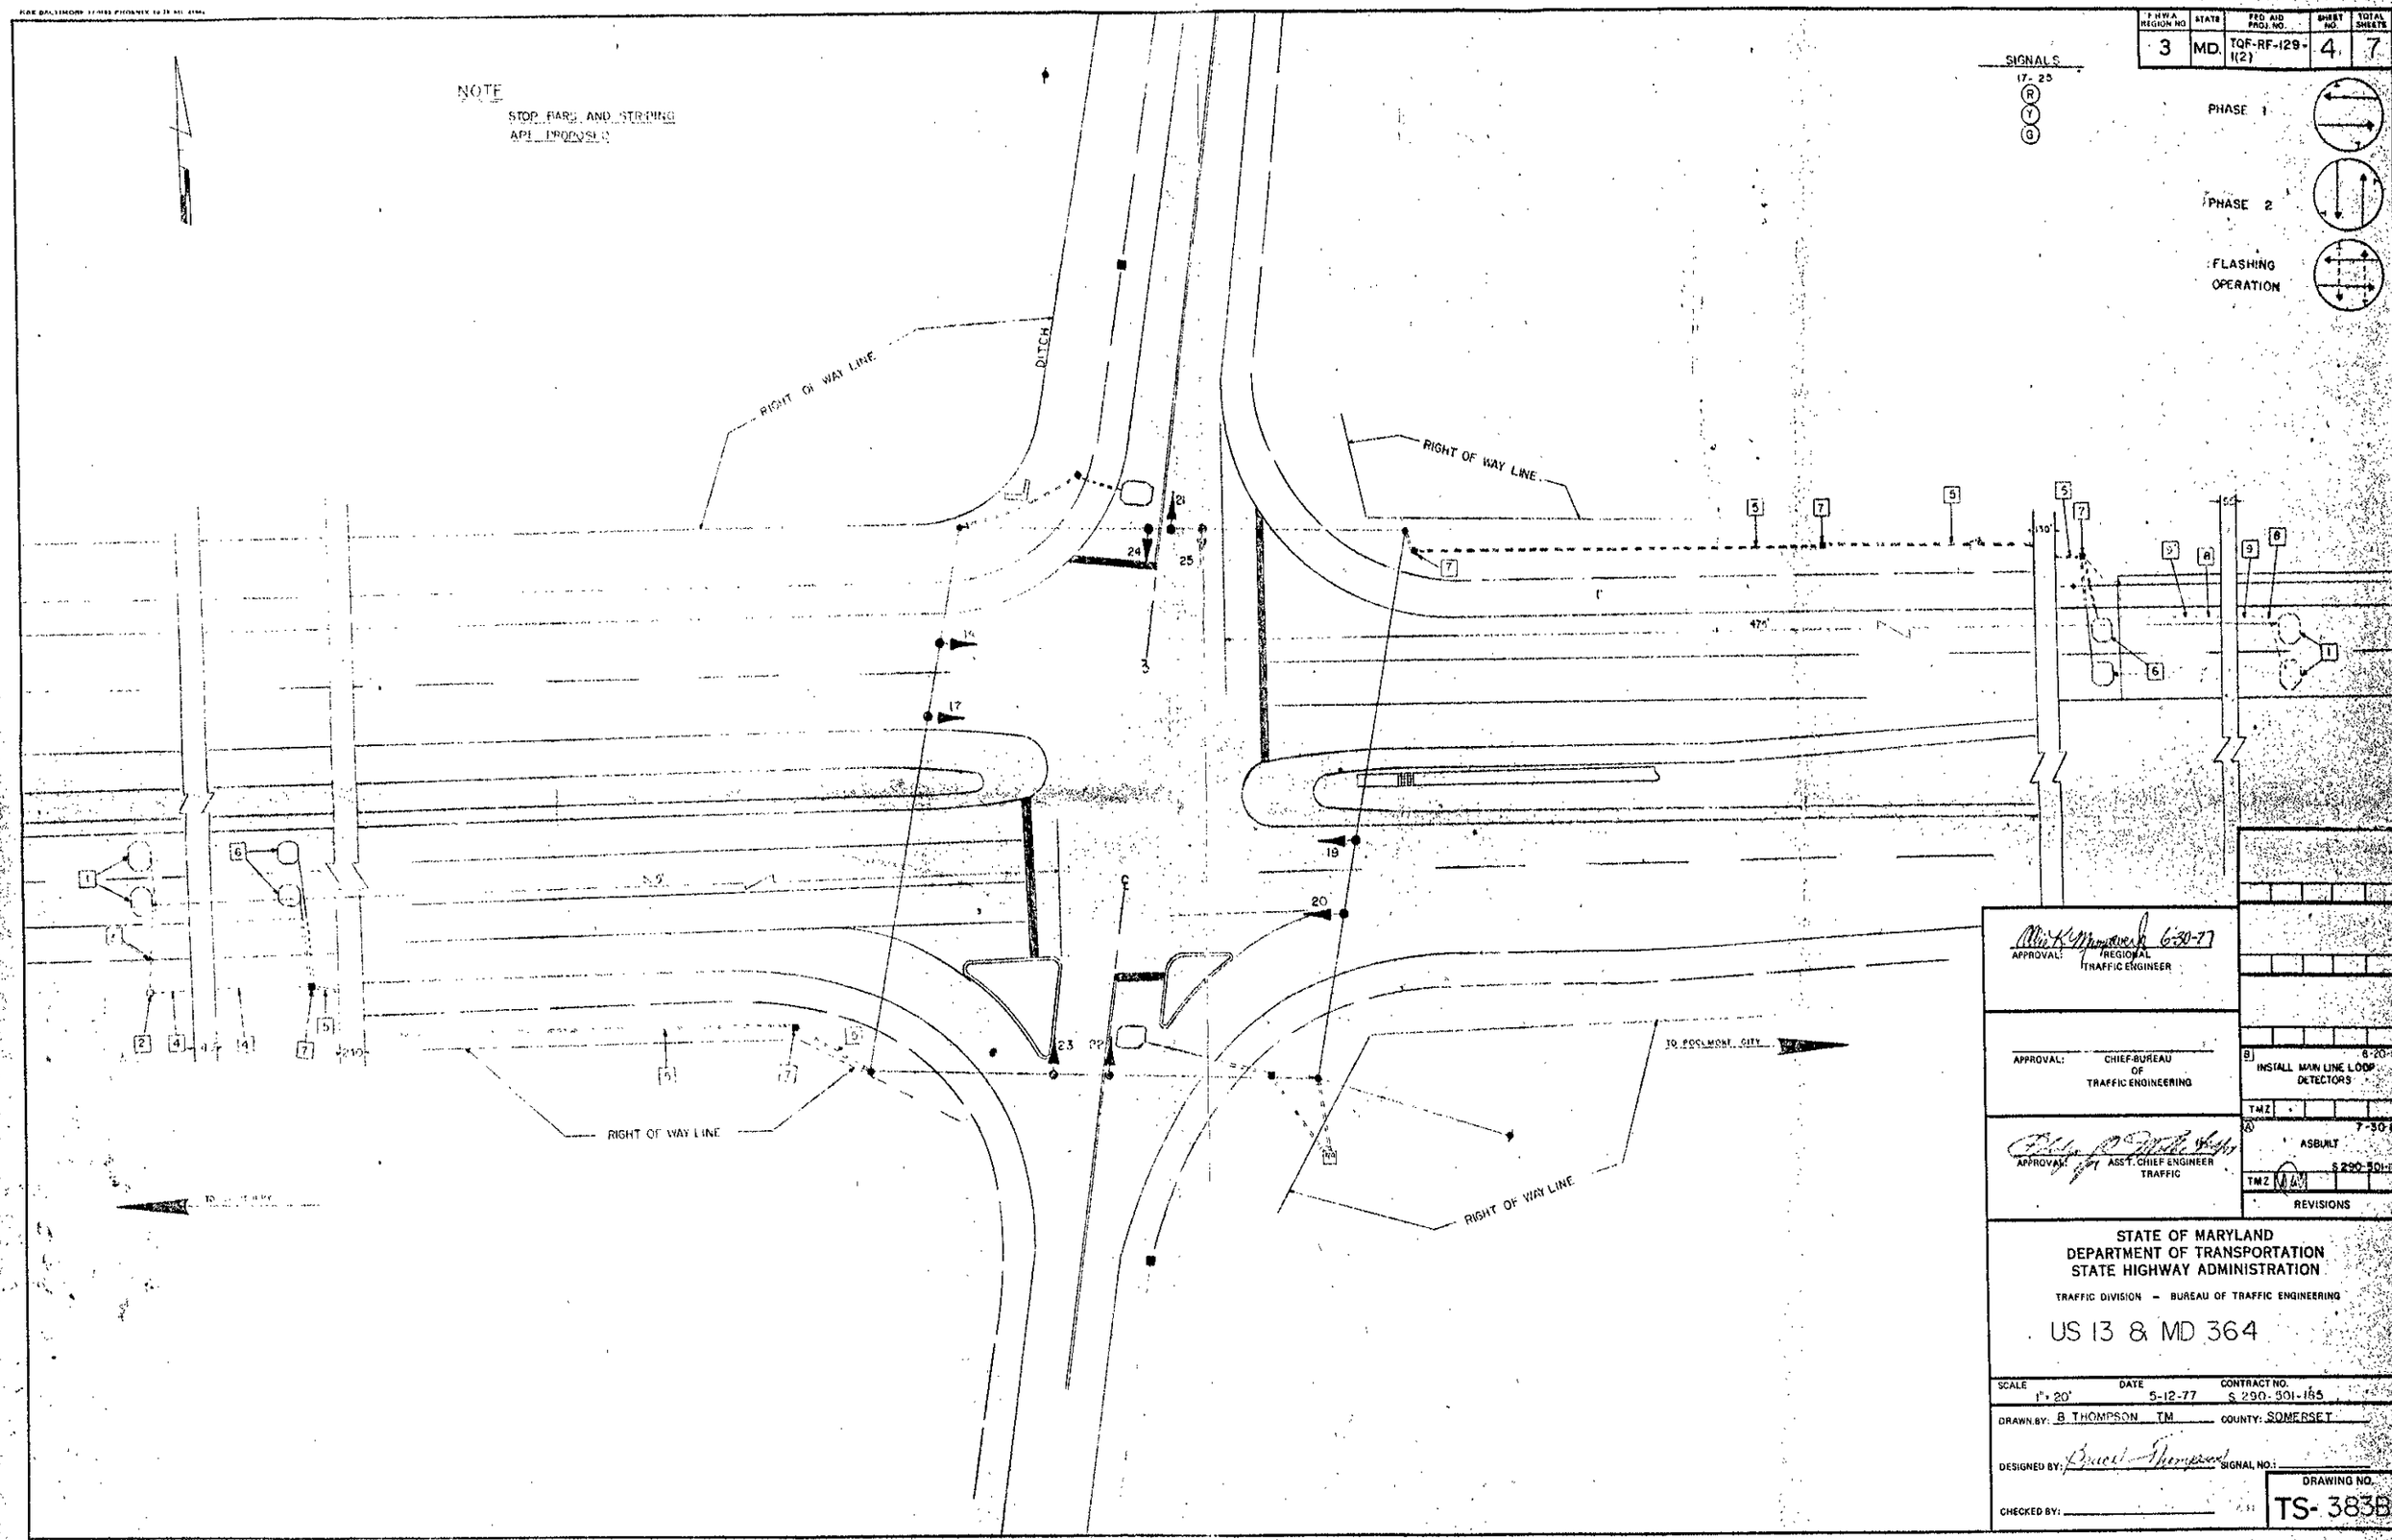

APPROVAL: REGIONAL TRAFFIC ENGINEER 6-30-77

APPROVAL: CHIEF-BUREAU OF TRAFFIC ENGINEERING

APPROVAL: ASS'T. CHIEF ENGINEER TRAFFIC

B 6-20-81 INSTALL MAIN LINE LOOP DETECTORS

TMZ

A 7-30-81 ASBUILT S 290-501-185

TMZ

REVISIONS

STATE OF MARYLAND
DEPARTMENT OF TRANSPORTATION
STATE HIGHWAY ADMINISTRATION

TRAFFIC DIVISION – BUREAU OF TRAFFIC ENGINEERING

US 13 & MD 364

SCALE 1" = 20' DATE 5-12-77 CONTRACT NO. S 290-501-185

DRAWN BY: B THOMPSON TM COUNTY: SOMERSET

DESIGNED BY: Bruce Thompson SIGNAL NO.:

CHECKED BY:

DRAWING NO. TS-383B