F.H.W.A. REGION NO.	STATE	FED. AID PROJ. NO.	SHEET NO.	TOTAL SHEETS
3	MD.	TQF-RF-129-1(2)	4	7

NOTE

STOP BARS AND STRIPING ARE PROPOSED

SIGNALS

17-25

R
Y
G

PHASE 1

PHASE 2

FLASHING OPERATION

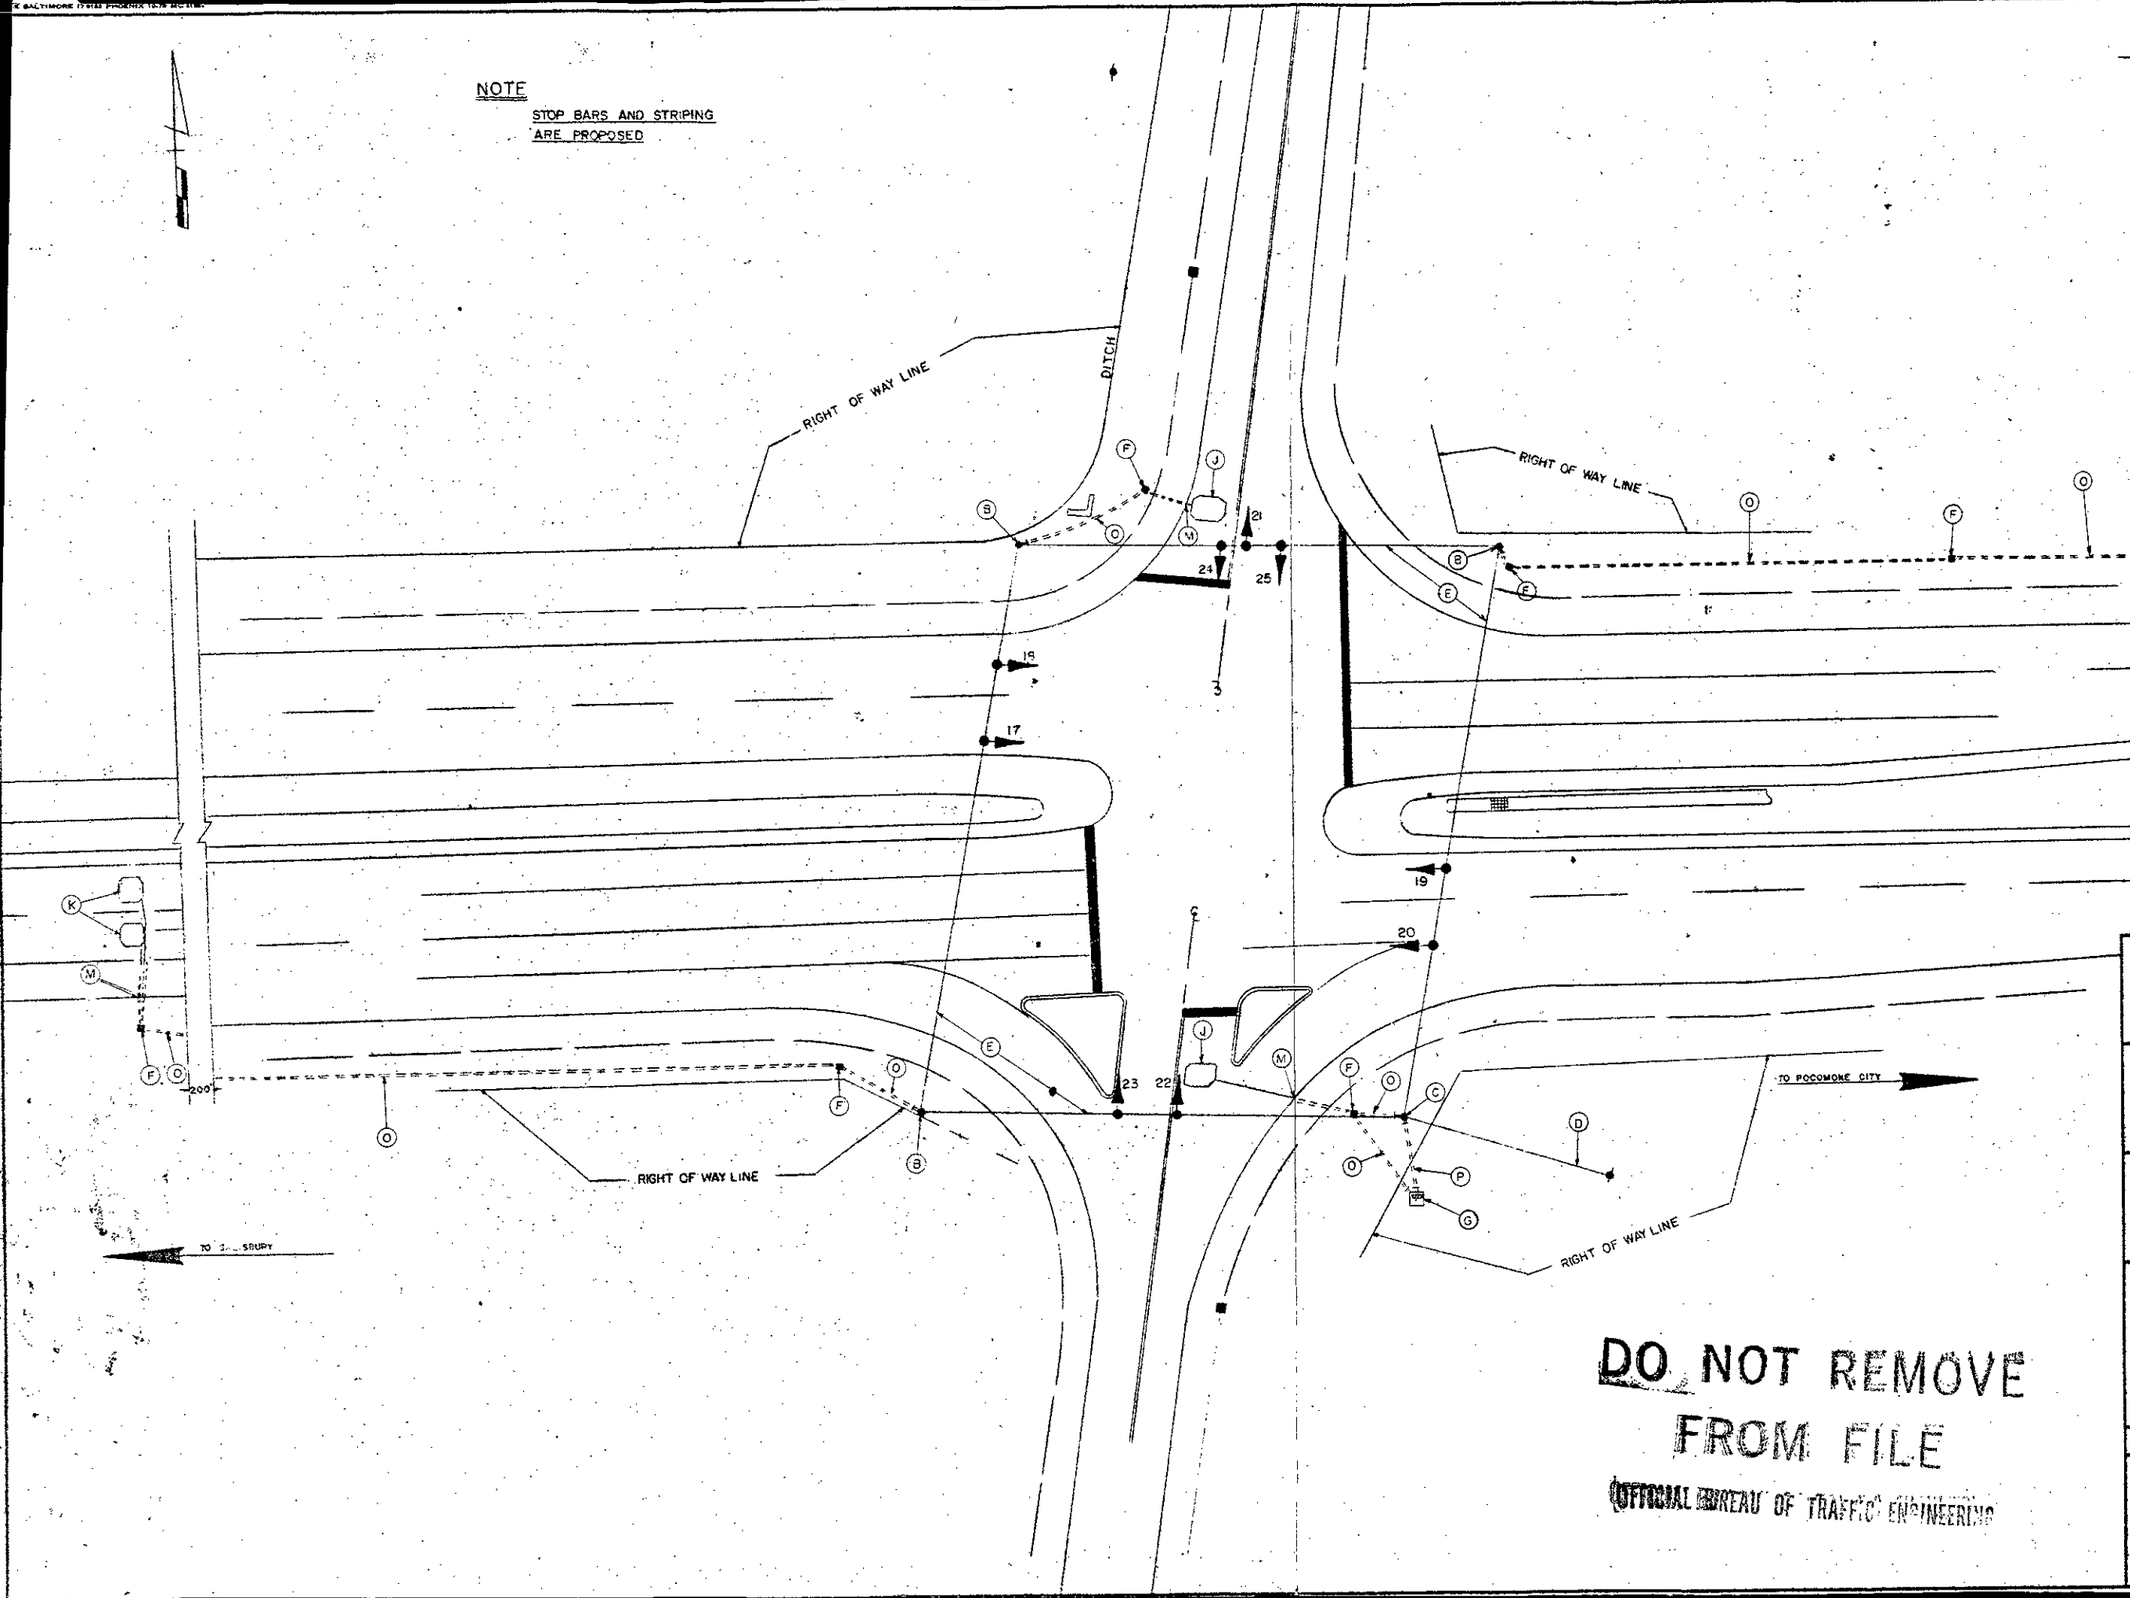

DO NOT REMOVE FROM FILE

OFFICIAL BUREAU OF TRAFFIC ENGINEERING

APPROVAL: 6-30-77 REGIONAL TRAFFIC ENGINEER

APPROVAL: CHIEF BUREAU OF TRAFFIC ENGINEERING

APPROVAL: ASS'T. CHIEF ENGINEER TRAFFIC

7-30-8 ASBUILT

S 290-501-18

TMZ

REVISIONS

STATE OF MARYLAND
DEPARTMENT OF TRANSPORTATION
STATE HIGHWAY ADMINISTRATION

TRAFFIC DIVISION – BUREAU OF TRAFFIC ENGINEERING

US 13 & MD 364

SCALE	DATE	CONTRACT NO.
1" = 20'	5-12-77	S 290-501-185

DRAWN BY: B THOMPSON TM COUNTY: SOMERSET

DESIGNED BY: Bruce Thompson SIGNAL NO.:

CHECKED BY:

DRAWING NO. TS-383