F H WA REGION NO	STATE	FED. AID PROJ. NO	SHEET NO.	TOTAL SHEETS
3	MD.			

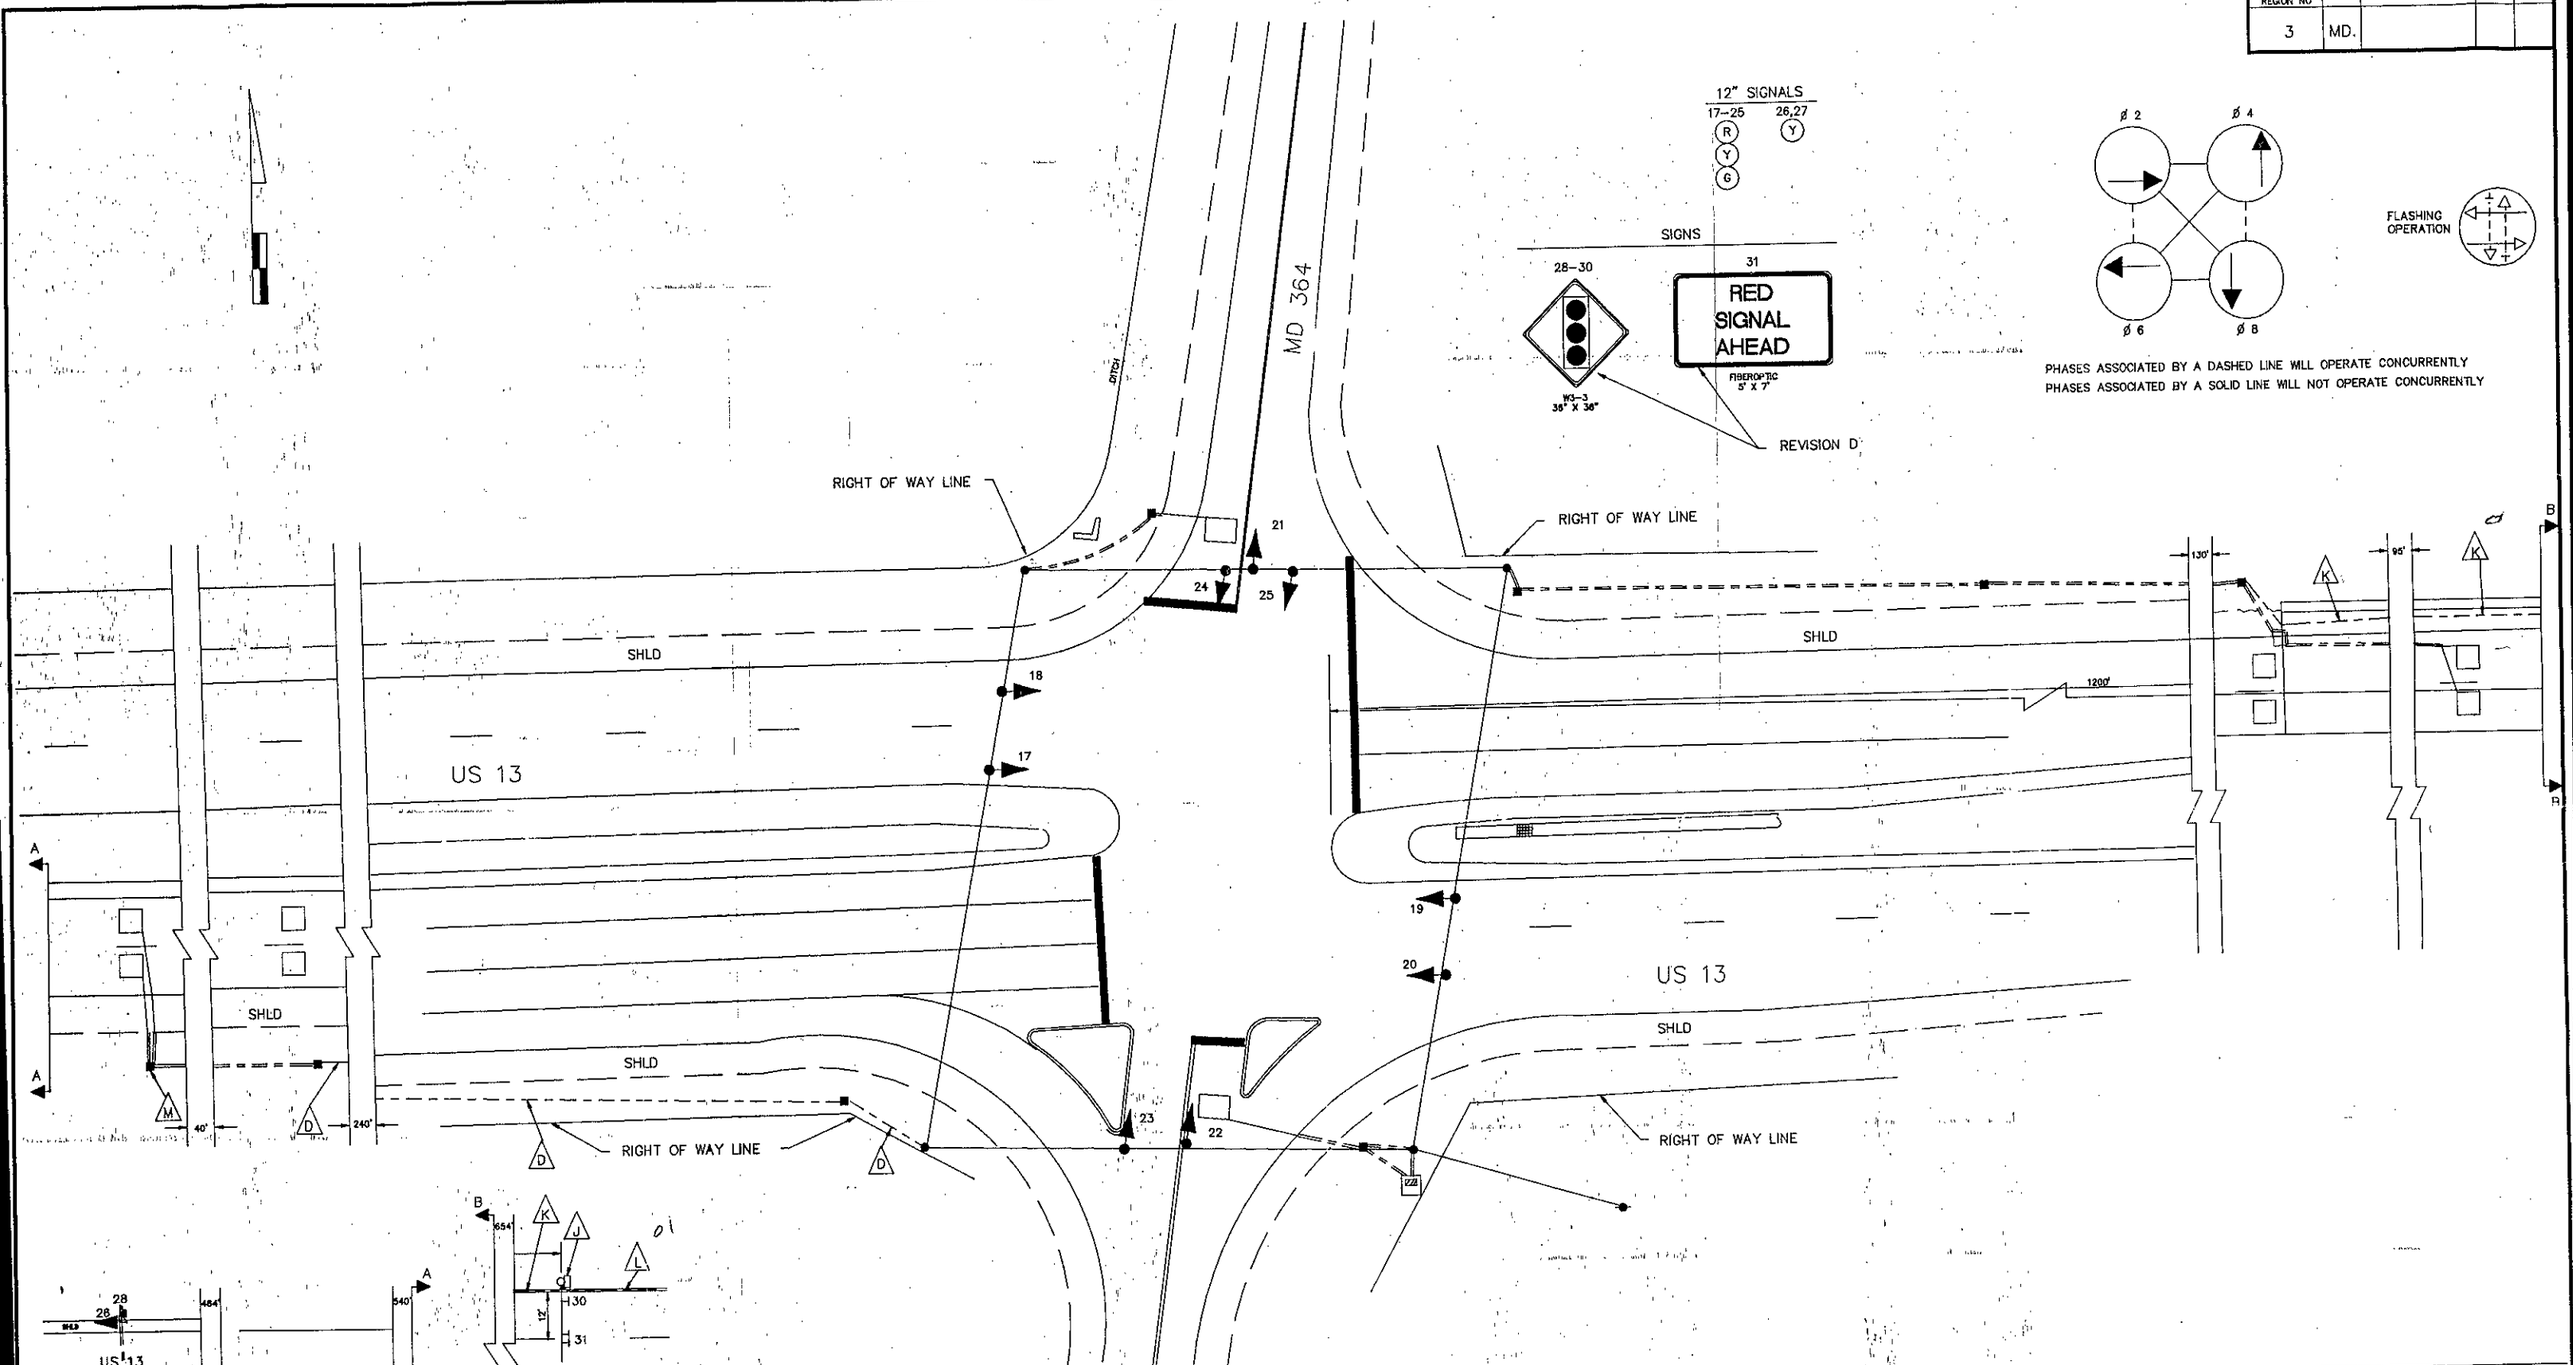

REVISIONS	APPROVALS
2/91 REBUILD EXISTING N/B H.I.B INSTALL S/B CONDUIT. 855-25029026	CHIEF, SIGNAL DESIGN SECTION ASST. DISTRICT ENGINEER, TRAFFIC STATE TRAFFIC ENGINEERING DIVISION DEPUTY CHIEF ENGINEER, OFFICE OF TRAFFIC

THIS IS A REVISION TO SHA CONTRACT NO. 309-501-185 THE ORIGINAL IS ON FILE

MARYLAND DEPARTMENT OF TRANSPORTATION
STATE HIGHWAY ADMINISTRATION – OFFICE OF TRAFFIC
TRAFFIC ENGINEERING DIVISION

DRAWN BY BRUCE THOMPSON
DES. BY: BRUCE THOMPSON
CHK. BY: ALFRED BUDNICHUK

US 13 and MD 364

14001300.26

COUNTY: SOMERSET

DATE: 5-12-77 REDRAWN 11-24-90
SCALE: 1"=20'

F.A.P. NO.
S.H.A. NO. S 290-501-185

TS/FILE NO. 383 D

SHEET NO. ___ OF ___