F.H.W.A. REGION NO.	STATE	FED. AID PROJ. NO.	SHEET NO.	TOTAL SHEETS
3	MD.			

	1	2	3	4	5	6	7	8
PHASE A	G	G	G	G	R	R	R	R
A YELLOW	Y	Y	Y	Y	R	R	R	R
PHASE B	R	R	R	R	G	G	G	G
B YELLOW	R	R	R	R	Y	Y	Y	Y
ALL RED	R	R	R	R	R	R	R	R
FLASHING OPERATION	FL/Y	FL/Y	FL/Y	FL/Y	FL/R	FL/R	FL/R	FL/R

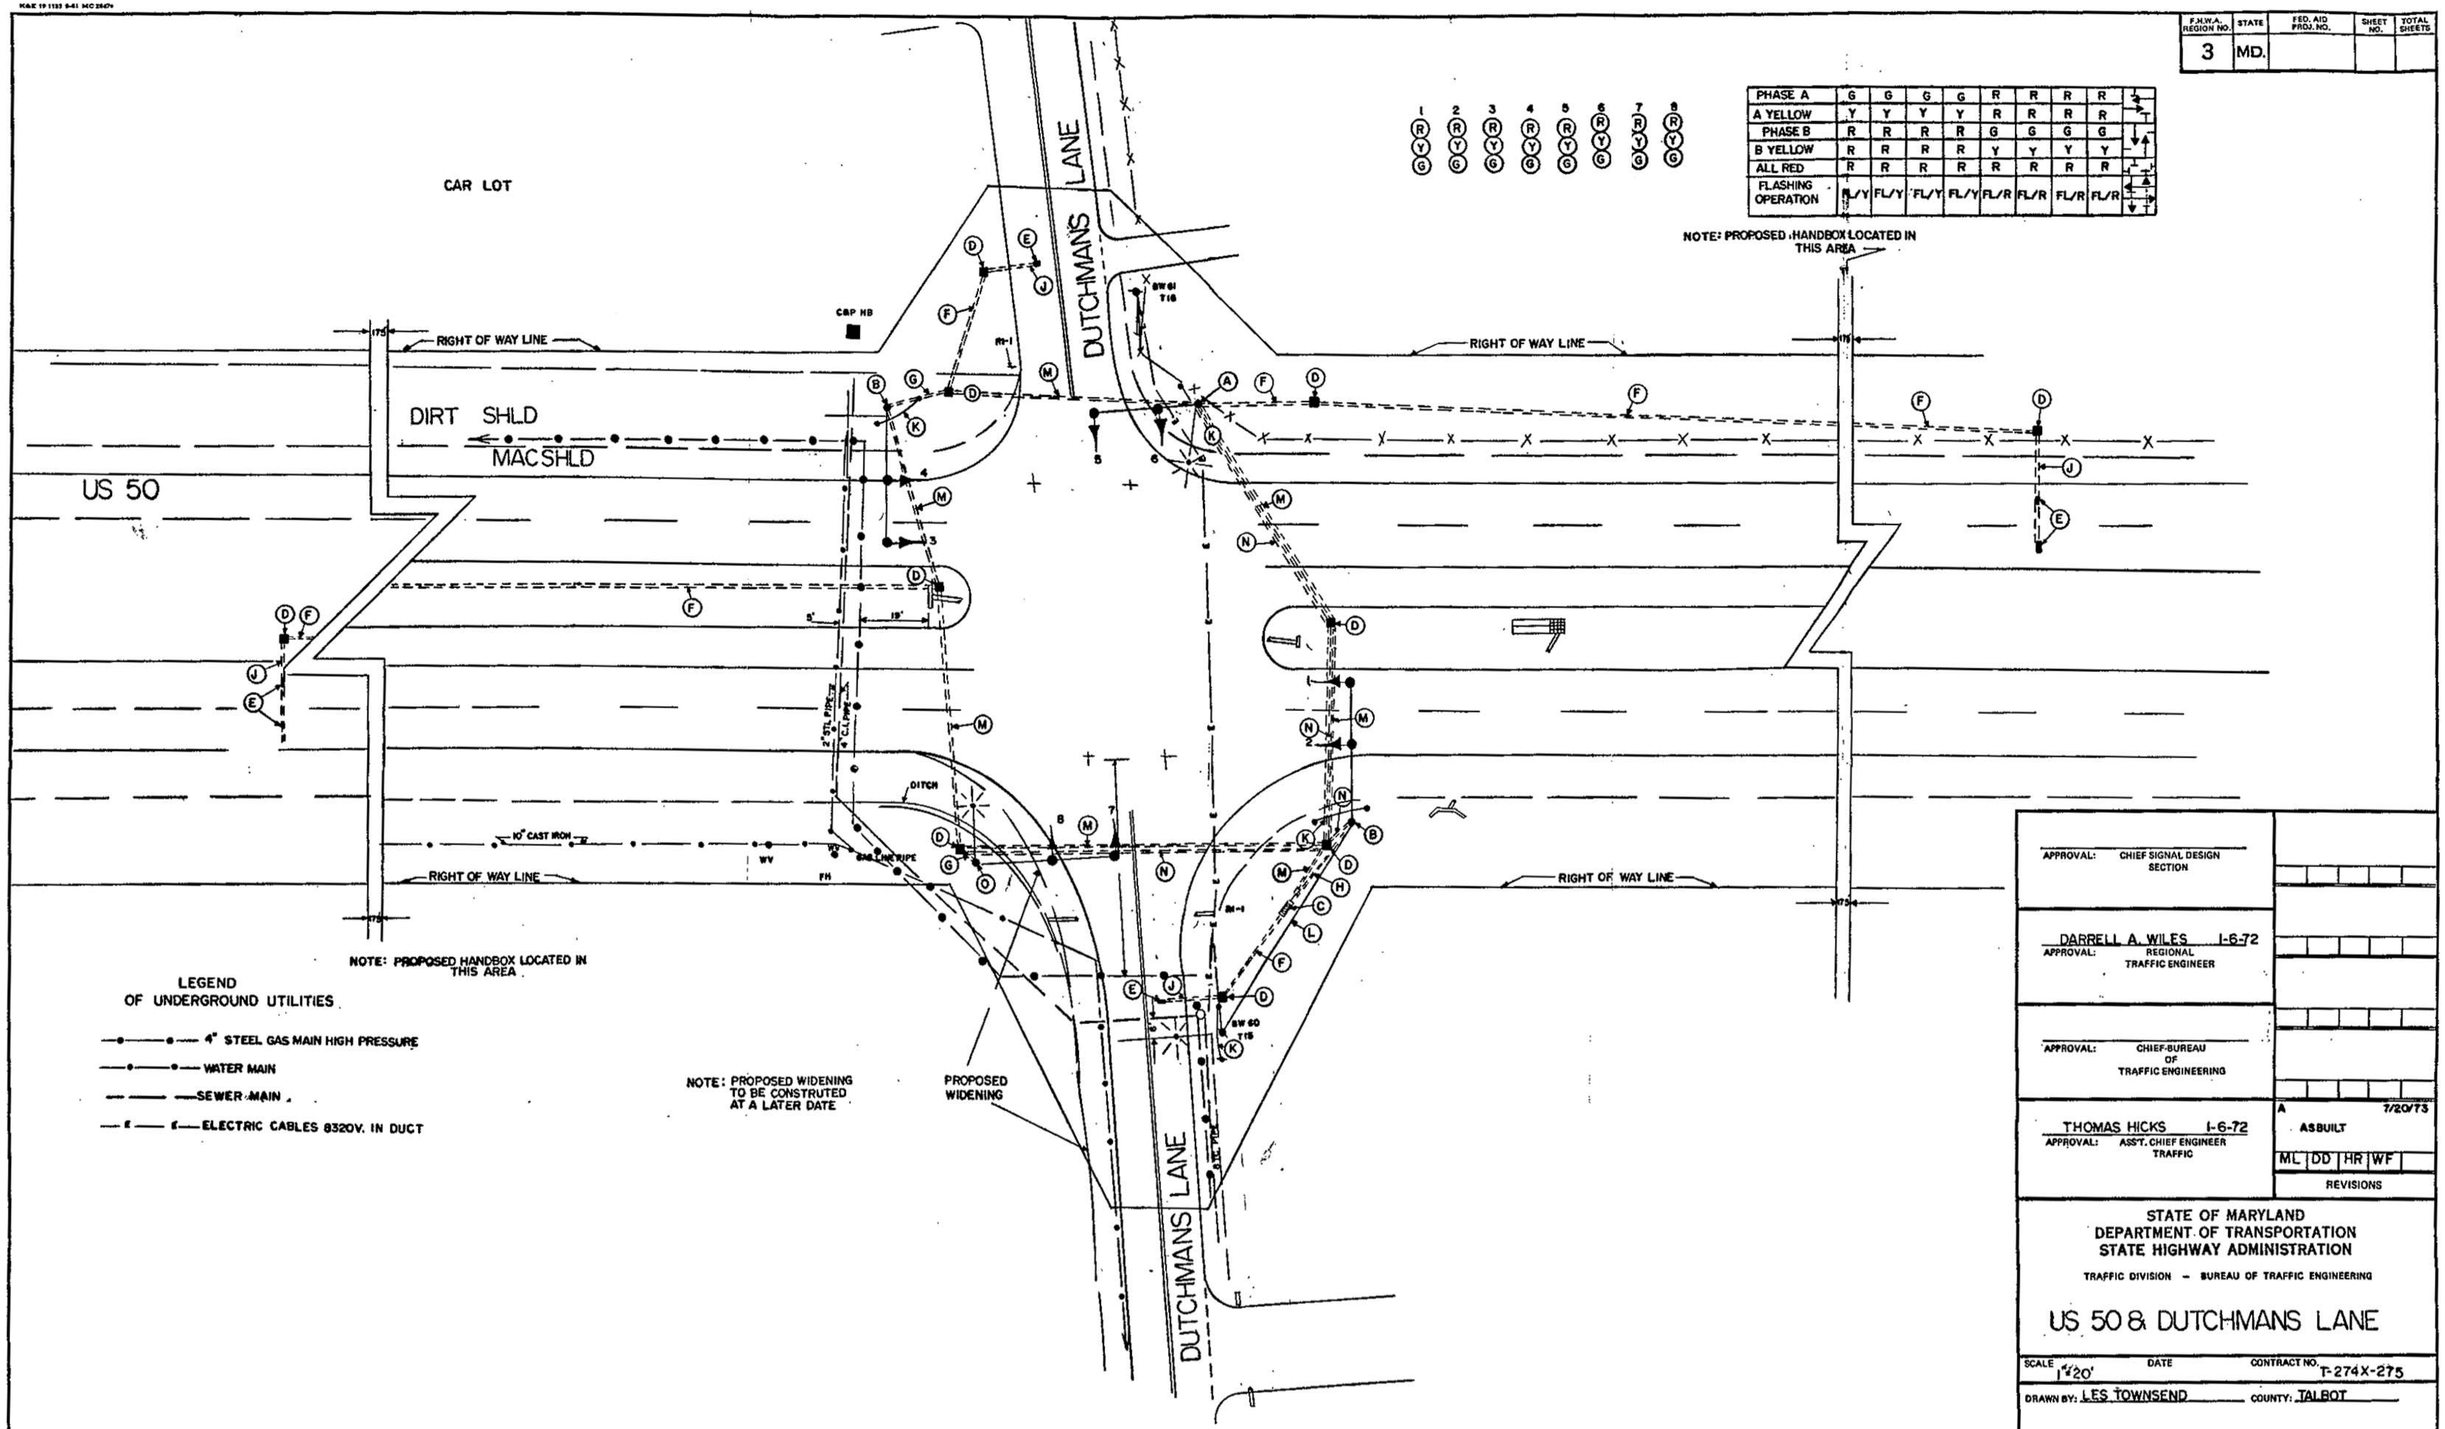

APPROVAL: CHIEF SIGNAL DESIGN SECTION

DARRELL A. WILES 1-6-72
APPROVAL: REGIONAL TRAFFIC ENGINEER

APPROVAL: CHIEF-BUREAU OF TRAFFIC ENGINEERING

THOMAS HICKS 1-6-72
APPROVAL: ASS'T. CHIEF ENGINEER TRAFFIC

A 7/20/73 ASBUILT

ML	DD	HR	WF	

REVISIONS

STATE OF MARYLAND
DEPARTMENT OF TRANSPORTATION
STATE HIGHWAY ADMINISTRATION

TRAFFIC DIVISION – BUREAU OF TRAFFIC ENGINEERING

US 50 & DUTCHMANS LANE

SCALE 1"=20' DATE CONTRACT NO. T-274X-275

DRAWN BY: LES TOWNSEND COUNTY: TALBOT

DESIGNED BY: SIGNAL NO.: 20102

CHECKED BY: J. SPENCE

DRAWING NO. TS-348A

20005012.51