F H WA REGION NO	STATE	FED. AID PROJ. NO	SHEET NO.	TOTAL SHEETS
3	MD.			

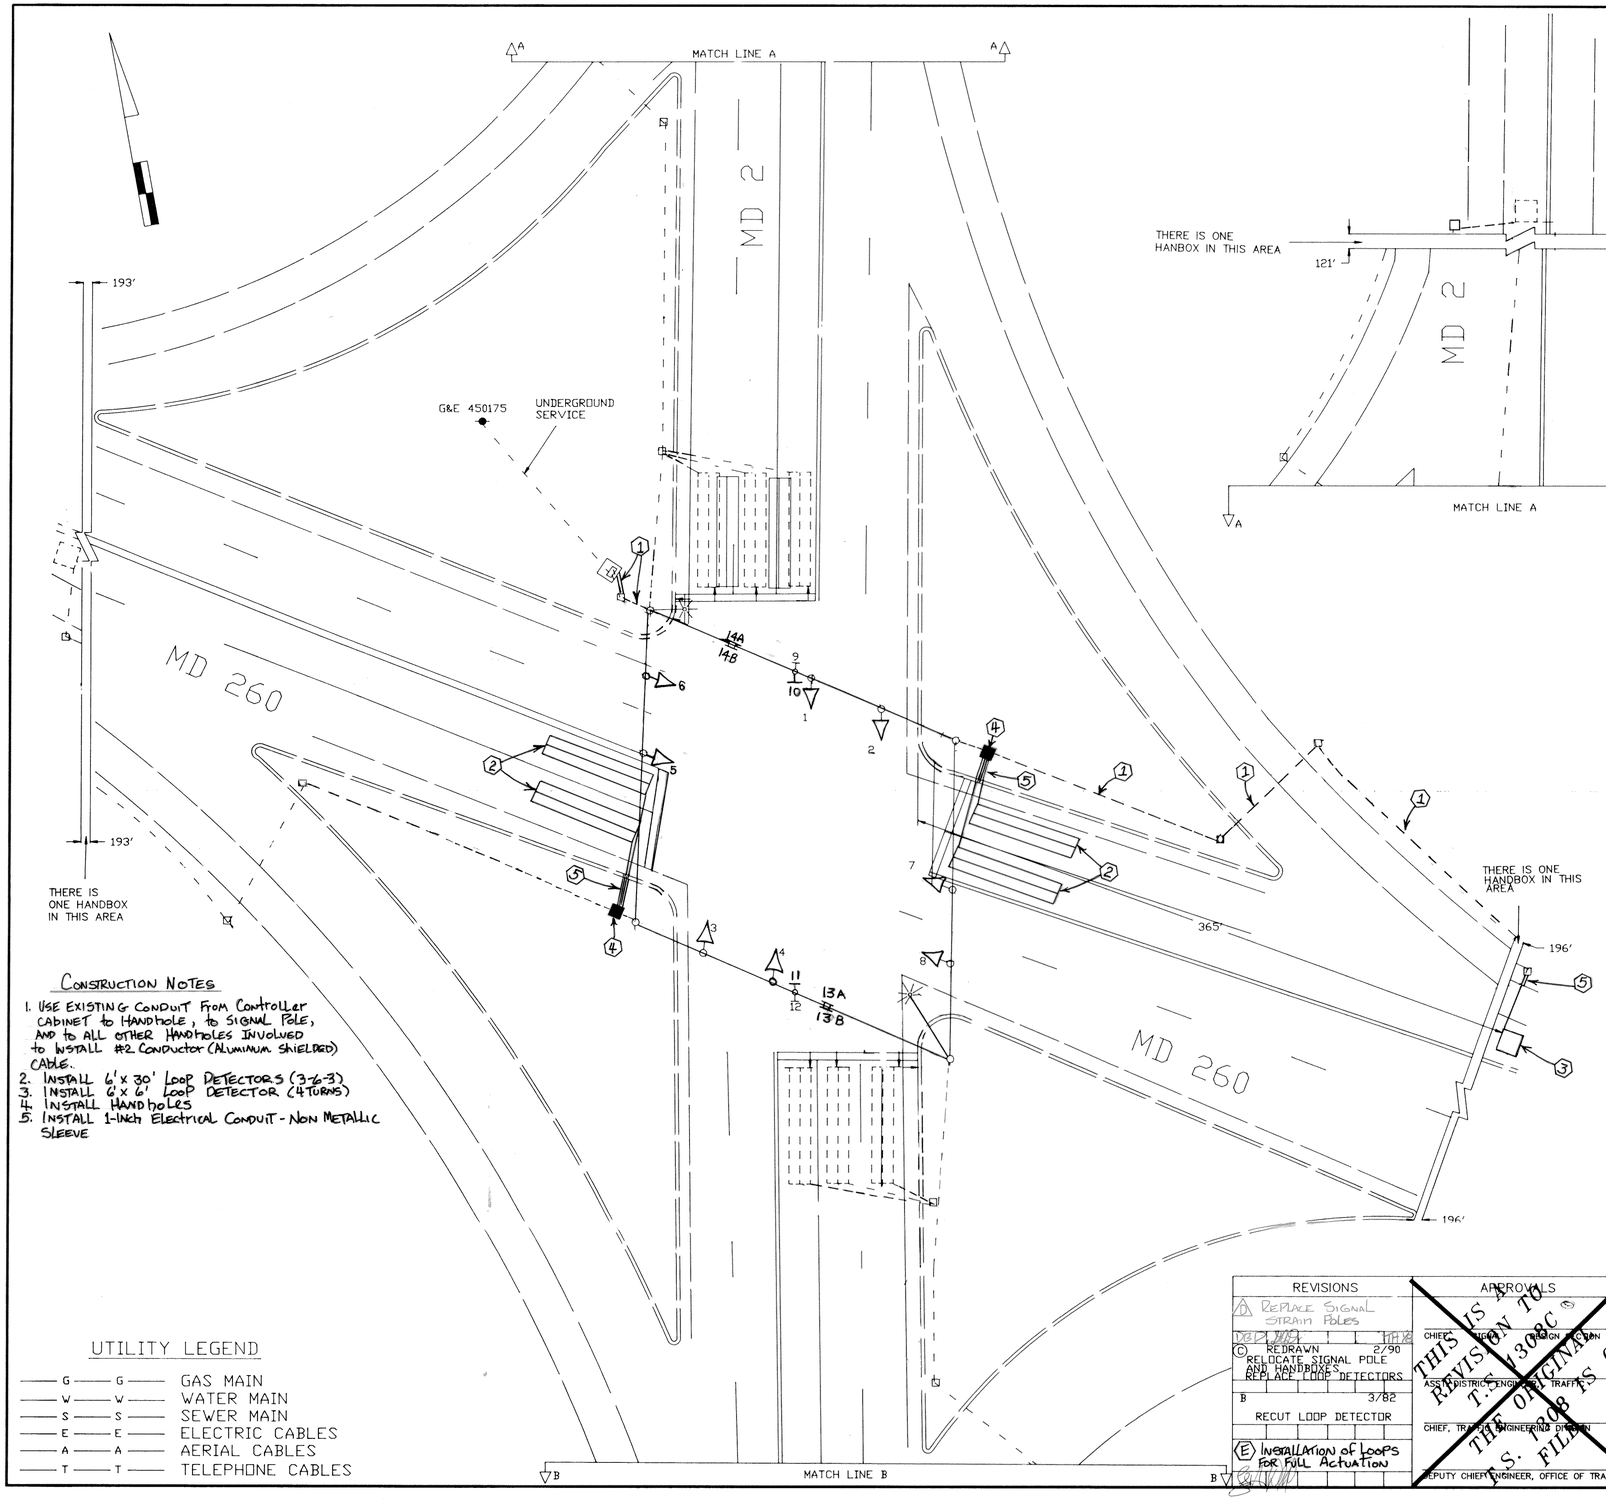

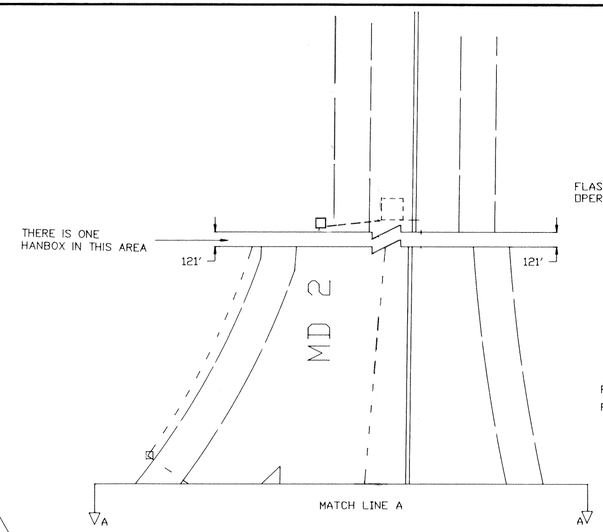

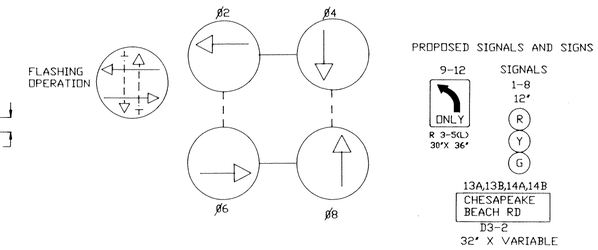

PHASES ASSOCIATED BY A DASHED LINE WILL OPERATE CONCURRENTLY
PHASES ASSOCIATED BY A SOLID LINE WILL NOT OPERATE CONCURRENTLY

NOTES
1. ALL PAVEMENT MARKINGS SHOWN ARE PROPOSED AND UNLESS OTHERWISE NOTED, ARE TO BE INSTALLED BY OTHERS IN ACCORDANCE WITH S.H.A. STANDARDS
2. "D.O." INDICATES A DELAY-OUTPUT LOOP DETECTOR

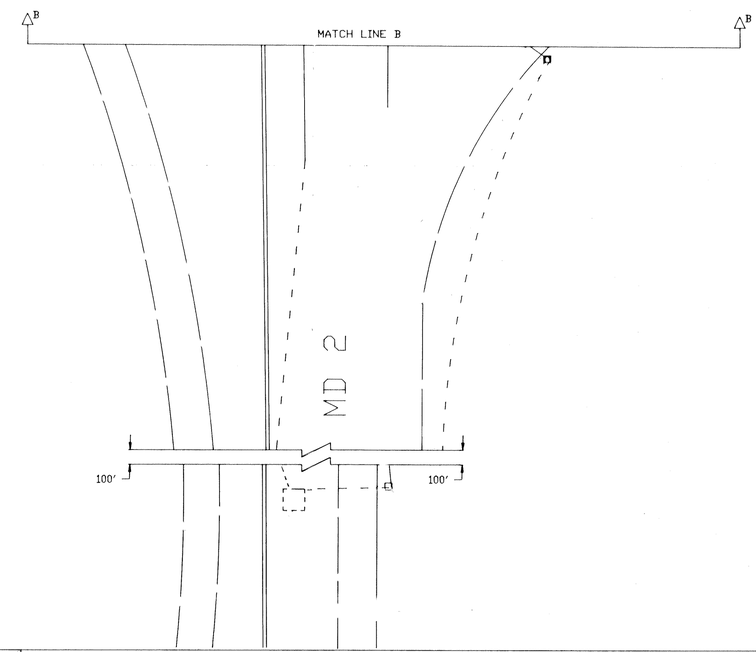

CONSTRUCTION NOTES

1. USE EXISTING CONDUIT FROM CONTROLLER CABINET to HANDHOLE, to SIGNAL POLE, AND to ALL OTHER HANDHOLES INVOLVED to INSTALL #2 CONDUCTOR (ALUMINUM SHIELDED) CABLE.
2. INSTALL 6'x 30' LOOP DETECTORS (3-6-3)
3. INSTALL 6'x 6' LOOP DETECTOR (4 TURNS)
4. INSTALL HANDHOLES
5. INSTALL 1-INCH ELECTRICAL CONDUIT - NON METALLIC SLEEVE

UTILITY LEGEND

—— G —— G ——	GAS MAIN
—— W —— W ——	WATER MAIN
—— S —— S ——	SEWER MAIN
—— E —— E ——	ELECTRIC CABLES
—— A —— A ——	AERIAL CABLES
—— T —— T ——	TELEPHONE CABLES

REVISIONS	APPROVALS
D REPLACE SIGNAL STRAIN POLES	CHIEF, SIGNAL DESIGN SECTION
C REDRAWN 2/90 RELOCATE SIGNAL POLE AND HANDBOXES REPLACE LOOP DETECTORS	ASST. DISTRICT ENGINEER, TRAFFIC
B 3/82 RECUT LOOP DETECTOR	CHIEF, TRAFFIC ENGINEERING DIVISION
E INSTALLATION of LOOPS FOR FULL ACTUATION	DEPUTY CHIEF ENGINEER, OFFICE OF TRAFFIC

THIS IS A REVISION TO T.S. 1308C THE ORIGINAL T.S. 1308 IS ON FILE

MDOT – STATE HIGHWAY ADMINISTRATION
Office of Traffic
TRAFFIC ENGINEERING DIVISION

SIGNAL # 04000234-06

DRAWN BY:
DES. BY: D ZAFIRIS
CHK. BY:

MD 2 AND MD 260

COUNTY: CALVERT

DATE: 5/1/75
SCALE: 1' = 20"
F.A.P. NO.
S.H.A. NO. 23855T2507619
TS/STD. NO. 1308 (E)
SHEET NO. ___ OF ___