
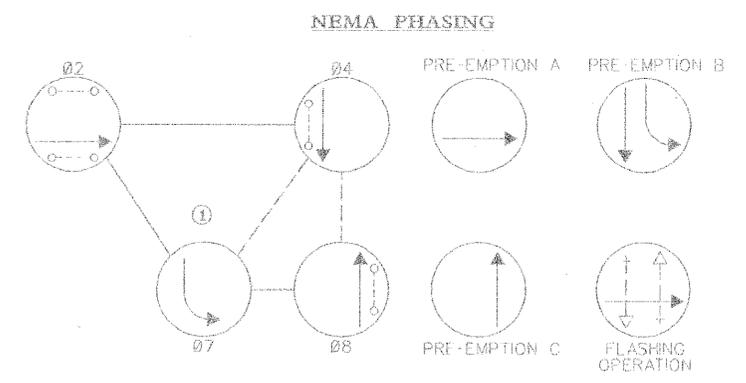


ES&A REGION NO.	STATE	FED. AID PROJ. NO.	SHEET NO.	TOTAL SHEETS
3	MD	STPG-218-1(7)E	26	66


U.S. 40 EAST (WEST WASHINGTON STREET) IS ASSUMED TO RUN IN AN EAST-WEST DIRECTION.

PROPOSED VIDEO DETECTION
a,b,c

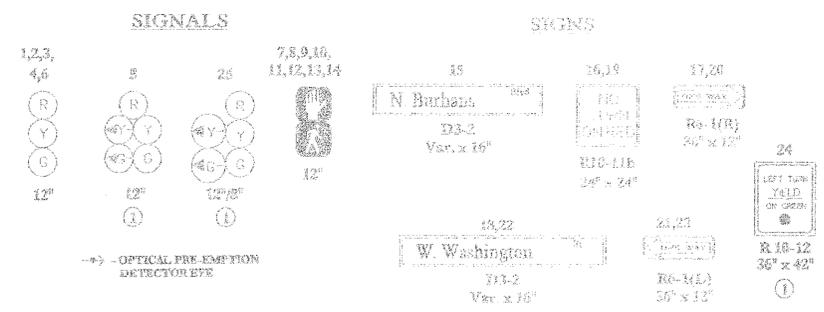

PHASING NOTES:
1. PHASES ASSOCIATED BY A SOLID LINE WILL NOT OPERATE CONCURRENTLY.
2. PHASES ASSOCIATED BY A DASHED LINE WILL OPERATE CONCURRENTLY.

A. EQUIPMENT TO BE SUPPLIED BY THE ADMINISTRATION.			
ITEM NO.	DESCRIPTION	UNITS	QUANTITY
9086	VIDEO DETECTION INTERFACE EQUIPMENT 1-4 CAMERAS	EA	1
B. EQUIPMENT TO BE FURNISHED AND/OR INSTALLED BY THE CONTRACTOR.			
ITEM NO.	DESCRIPTION	UNITS	QUANTITY
8058	VIDEO DETECTION CAMERA	EA	3
8009	CONTROL CABLE, 300 FOOT VIDEO DETECTION CAMERA TO CONTROLLER	EA	3

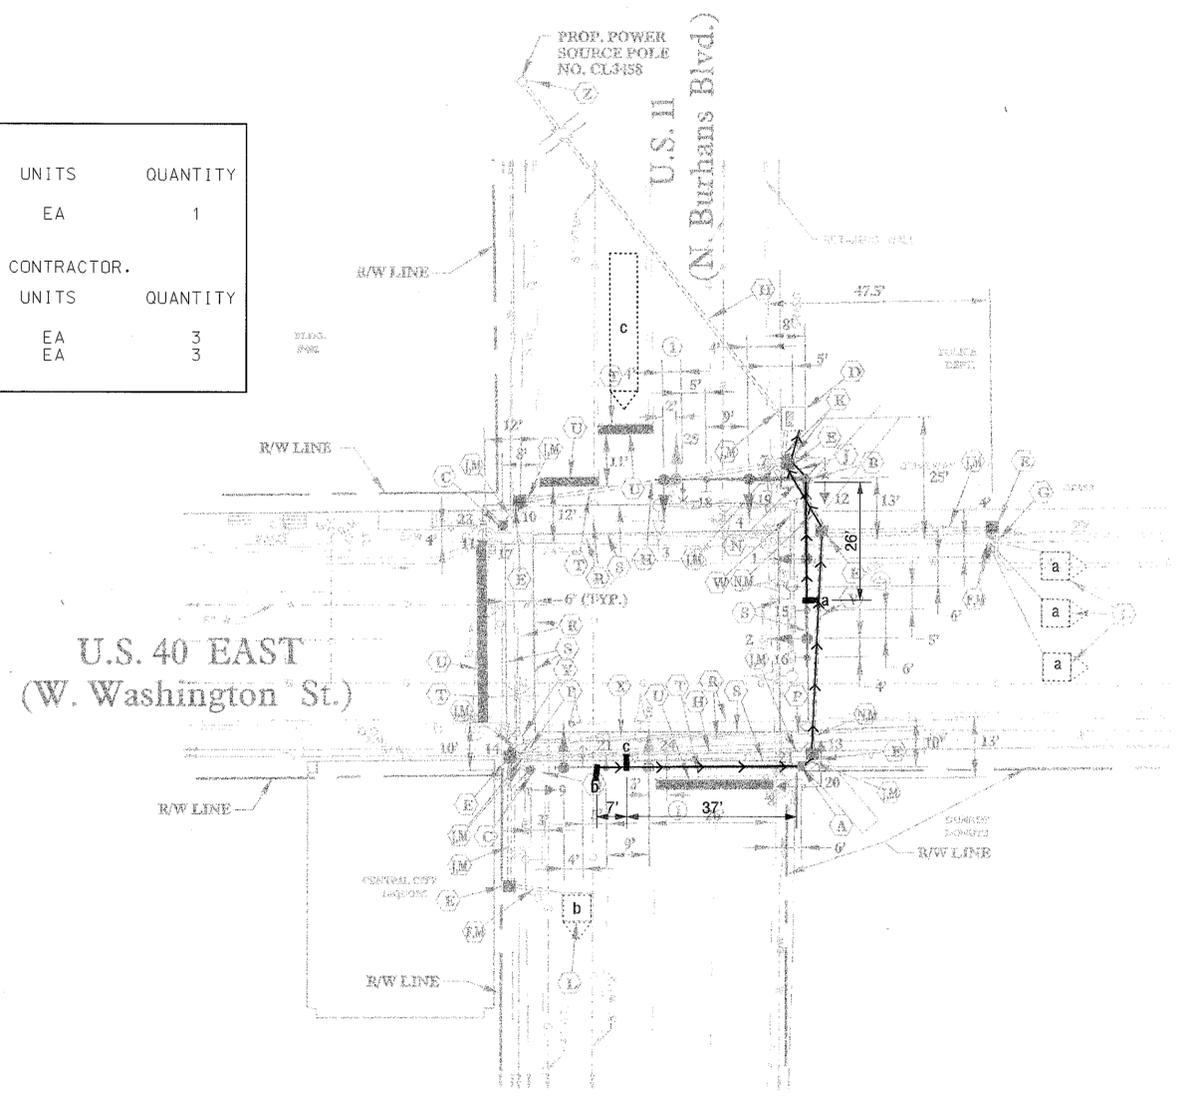

- GENERAL NOTES**
- VIDEO CAMERA LOCATION / ALIGNING SHALL BE COORDINATED WITH THE SHA ENGINEER.
 - THE CONTRACTOR SHALL CONTACT SHA TO SCHEDULE RETROFITTING OF THE CONTROLLER EQUIPMENT IN ORDER TO OPERATE VIDEO DETECTION EQUIPMENT.
 - THE CONTRACTOR SHALL BE RESPONSIBLE FOR TERMINATING ALL VIDEO DETECTION CAMERA CABLES TO THE APPROPRIATE TERMINALS AND PROPERLY LABEL EACH CABLE SO THAT SHA FORCES CAN MAKE THE FINAL CONNECTIONS.
 - THE INSTALLATION OF PROPOSED VIDEO DETECTION EQUIPMENT SHALL NECESSITATE THE REMOVAL OF EXISTING CABLES ASSOCIATED WITH THE PRESENCE LOOP DETECTORS BEING REPLACED BY VIDEO DETECTION.
 - ALL EXISTING TRAFFIC SIGNAL EQUIPMENT REMOVED SHALL BECOME THE PROPERTY OF THE SIGNAL CONTRACTOR UPON COMPLETION OF THE SIGNAL MODIFICATIONS.
 - ALL UNUSED SIGNAL CABLES SHALL BE REMOVED AND DISPOSED.

VIDEO CAMERA LEGEND
→ = VIDEO CABLE (PATH TO CONTROLLER)

UTILITY LEGEND

— G — G —	GAS MAIN
— W — W —	WATER MAIN
— S — S —	SEWER MAIN
— SD — SD —	STORM DRAIN
— TV — TV —	CABLE TELEVISION
— E — E —	ELECTRIC CABLES
— T — T —	TELEPHONE CABLES
— A — A —	AERIAL CABLES

SABRA, WANG & ASSOCIATES, INC.
1504 JOH AVENUE
SUITE 160
BALTIMORE, MD 21227
(410) 737-6564
WWW.SABRA-WANG.COM

REVISIONS	APPROVALS
1. INSTALL E/P LEFT TURN	CRONIN
2. INSTALL VIDEO DETECTION	FILE

SHA MDOT - STATE HIGHWAY ADMINISTRATION
Office of Traffic & Safety
TRAFFIC ENGINEERING DESIGN DIVISION

CH#: WA180482/1852
TOD#: AT208-20
TIMS# G594
LOG ML 2100107.27

US 40 East (West Washington St.)
at US II (North Burhans Blvd.)
COUNTY: WASHINGTON

DRAWN BY: T. COURVILLE
DES. BY: J. LAWRENCE
CHK. BY:

DATE: 05/30/97
SCALE: 1" = 20'

F.A.P. NO. STPG-218-1(7)E
S.H.A. NO. WA9535185

TS/STD. NO. 3697A
SHEET NO. 26 OF 66

FILE: F:\2002\12_2001\201\Task32.dgn User: jleu/6/6/97