F H W A REGION NO.	STATE	FED. AID PROJ. NO.	SHEET NO.	TOTAL SHEETS
3	MD		4	15

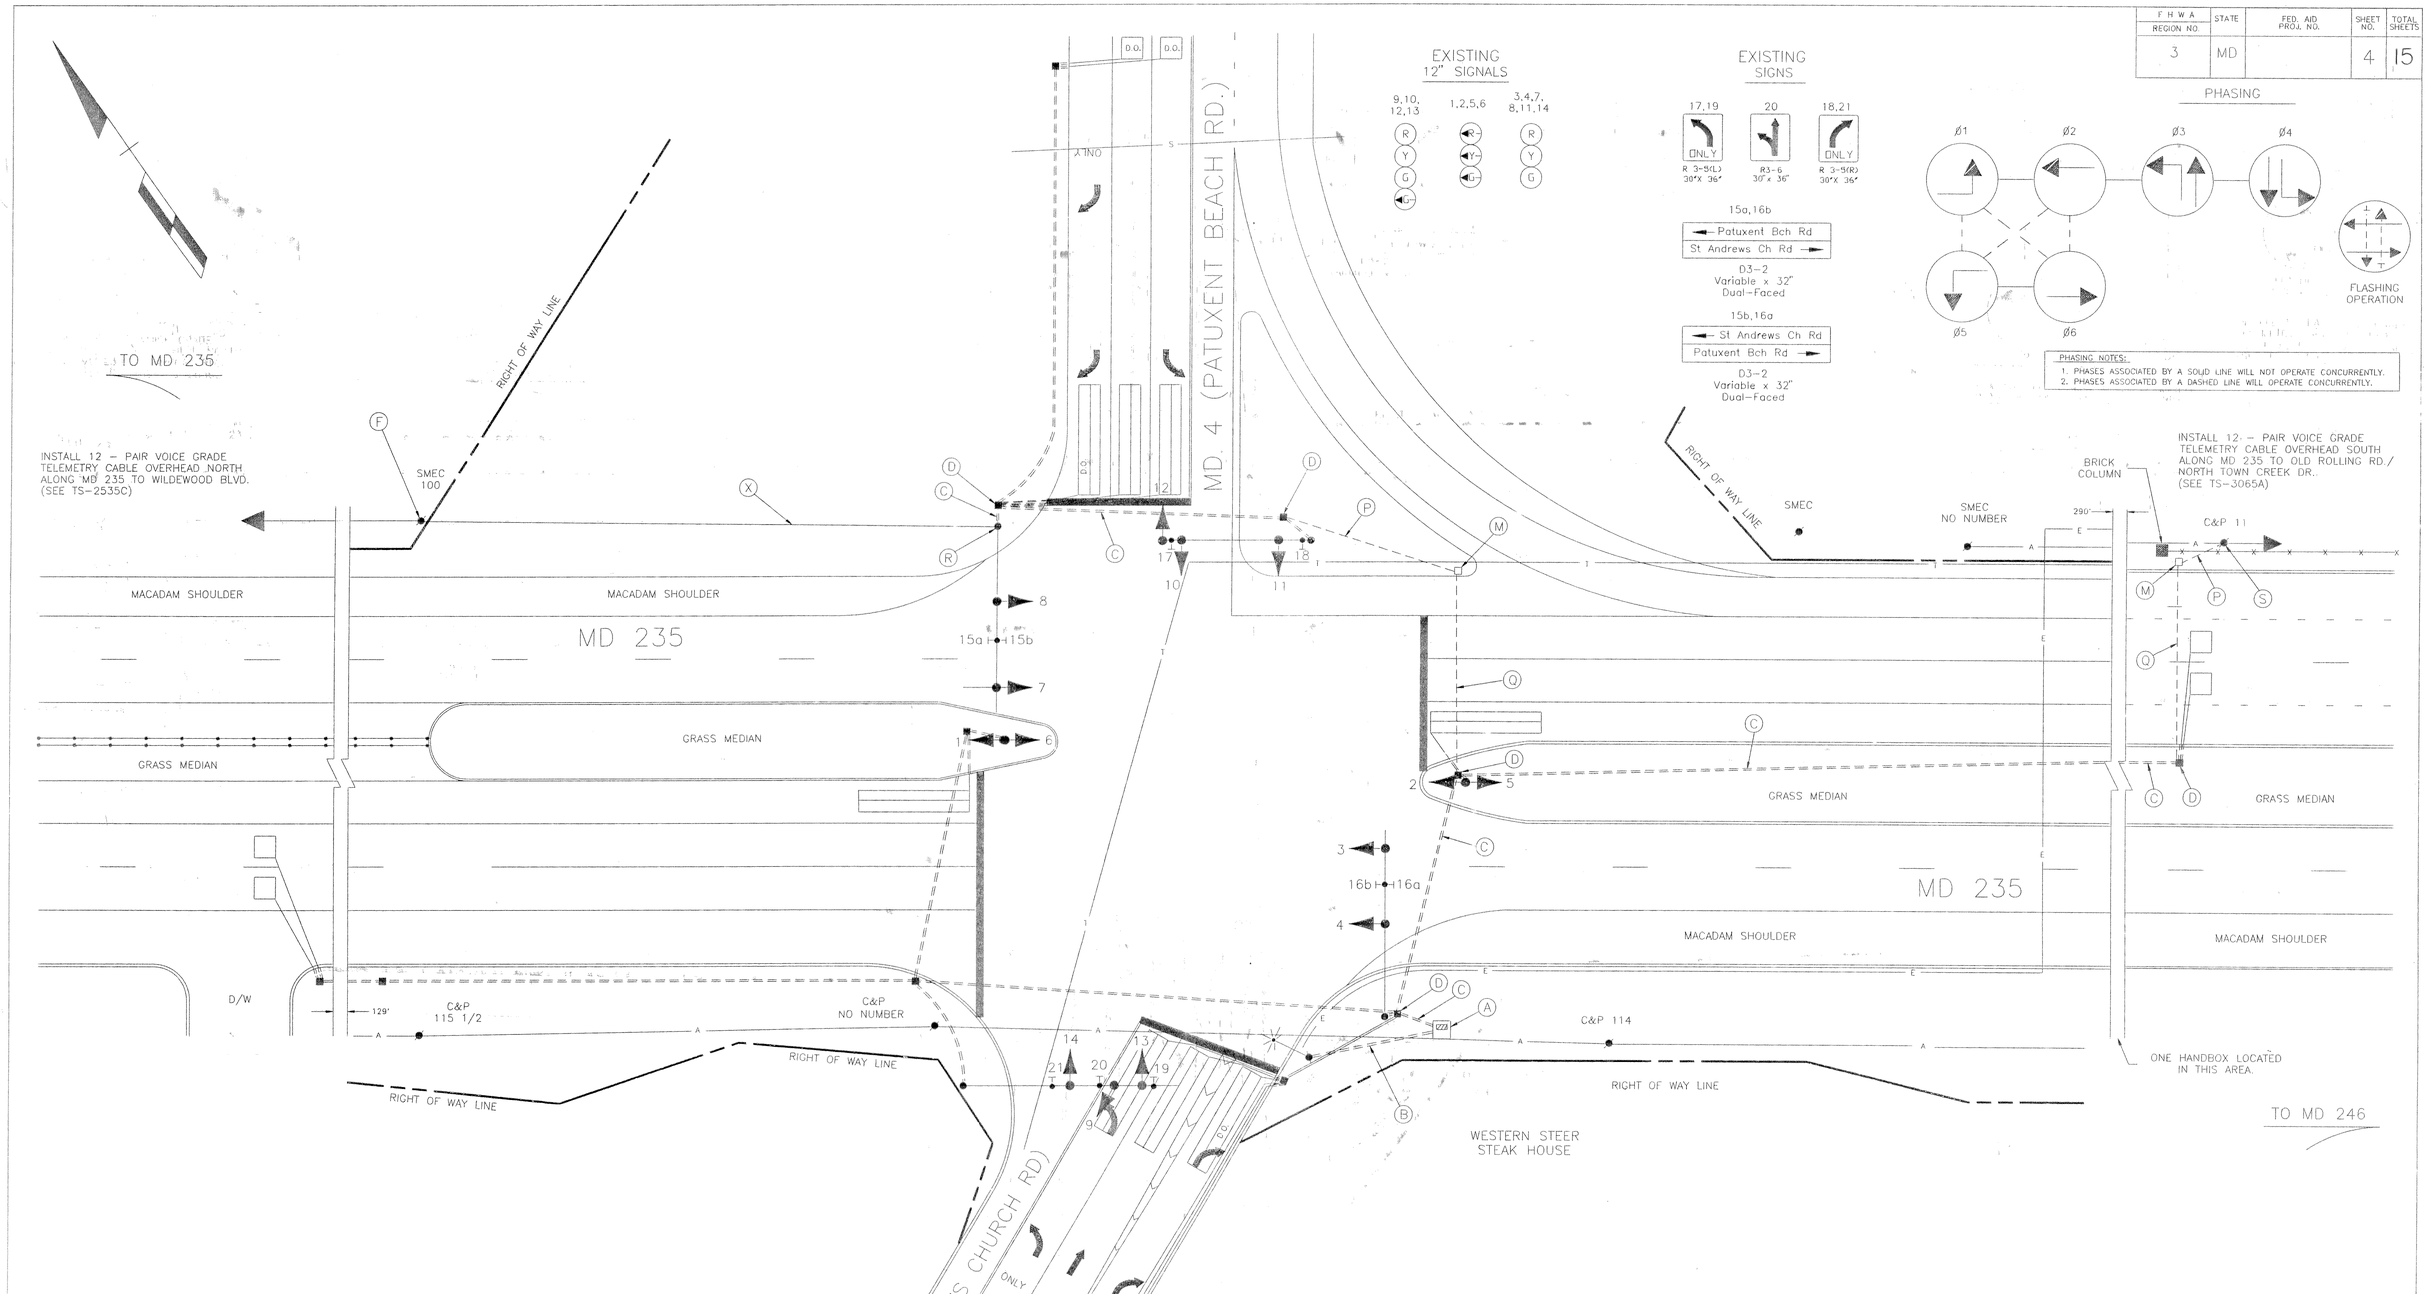

LEGEND OF UNDERGROUND AND OVERHEAD UTILITIES

AERIAL CABLE	A	A	A
ELECTRIC	E	E	E
TELEPHONE	T	T	T
GAS	G	G	G
SEWER	S	S	S
WATER	W	W	W
CABLE TV	TV	TV	TV

STREET TRAFFIC STUDIES, LTD.
Gateway International
1302 Concourse Drive, Suite 104
Linthicum, Maryland 21090
(410) 859-3553
2221D

REVISIONS

D 11-20-92	ADD I/C AND ASBUILT
SHA NO. : REZ	
C 7-90	SPLIT MD 4 PHASING AND ADDED OPTIONAL S/B DOUBLE LEFT TURN
B 12-18-87	NEW GEOMETRICS AND SIGNAL RELOCATION. NEW PHASING. SHA NO. 855-25006.
A 9-10-83	ASBUILT
DA	

APPROVALS

CHIEF, SIGNAL DESIGN SECTION
ASST. DISTRICT ENGINEER, TRAFFIC
CHIEF, TRAFFIC ENGINEERING DESIGN DIVISION
DIRECTOR, OFFICE OF TRAFFIC AND SAFETY
ORIGINAL ON FILE

MDOT – STATE HIGHWAY ADMINISTRATION

Office of Traffic and Safety

TRAFFIC ENGINEERING DESIGN DIVISION

SIGNAL NUMBER : LOC MILE :

DRAWN BY: BRUCE THOMPSON DD
DES. BY:
CHK. BY:

MD 235 AND MD 4

COUNTY ST. MARYS

DATE: 10-6-78
SCALE: 1"=20'

F.A.P. NO. NHG-265-1(7) E
S.H.A. NO. SM-767-501-585

TS/STD. NO. 1637-D

SHEET NO. 4 OF 15

F#50

18023550667