F H WA REGION NO	STATE	FED. AID PROJ. NO	SHEET NO.	TOTAL SHEETS
3	MD.			

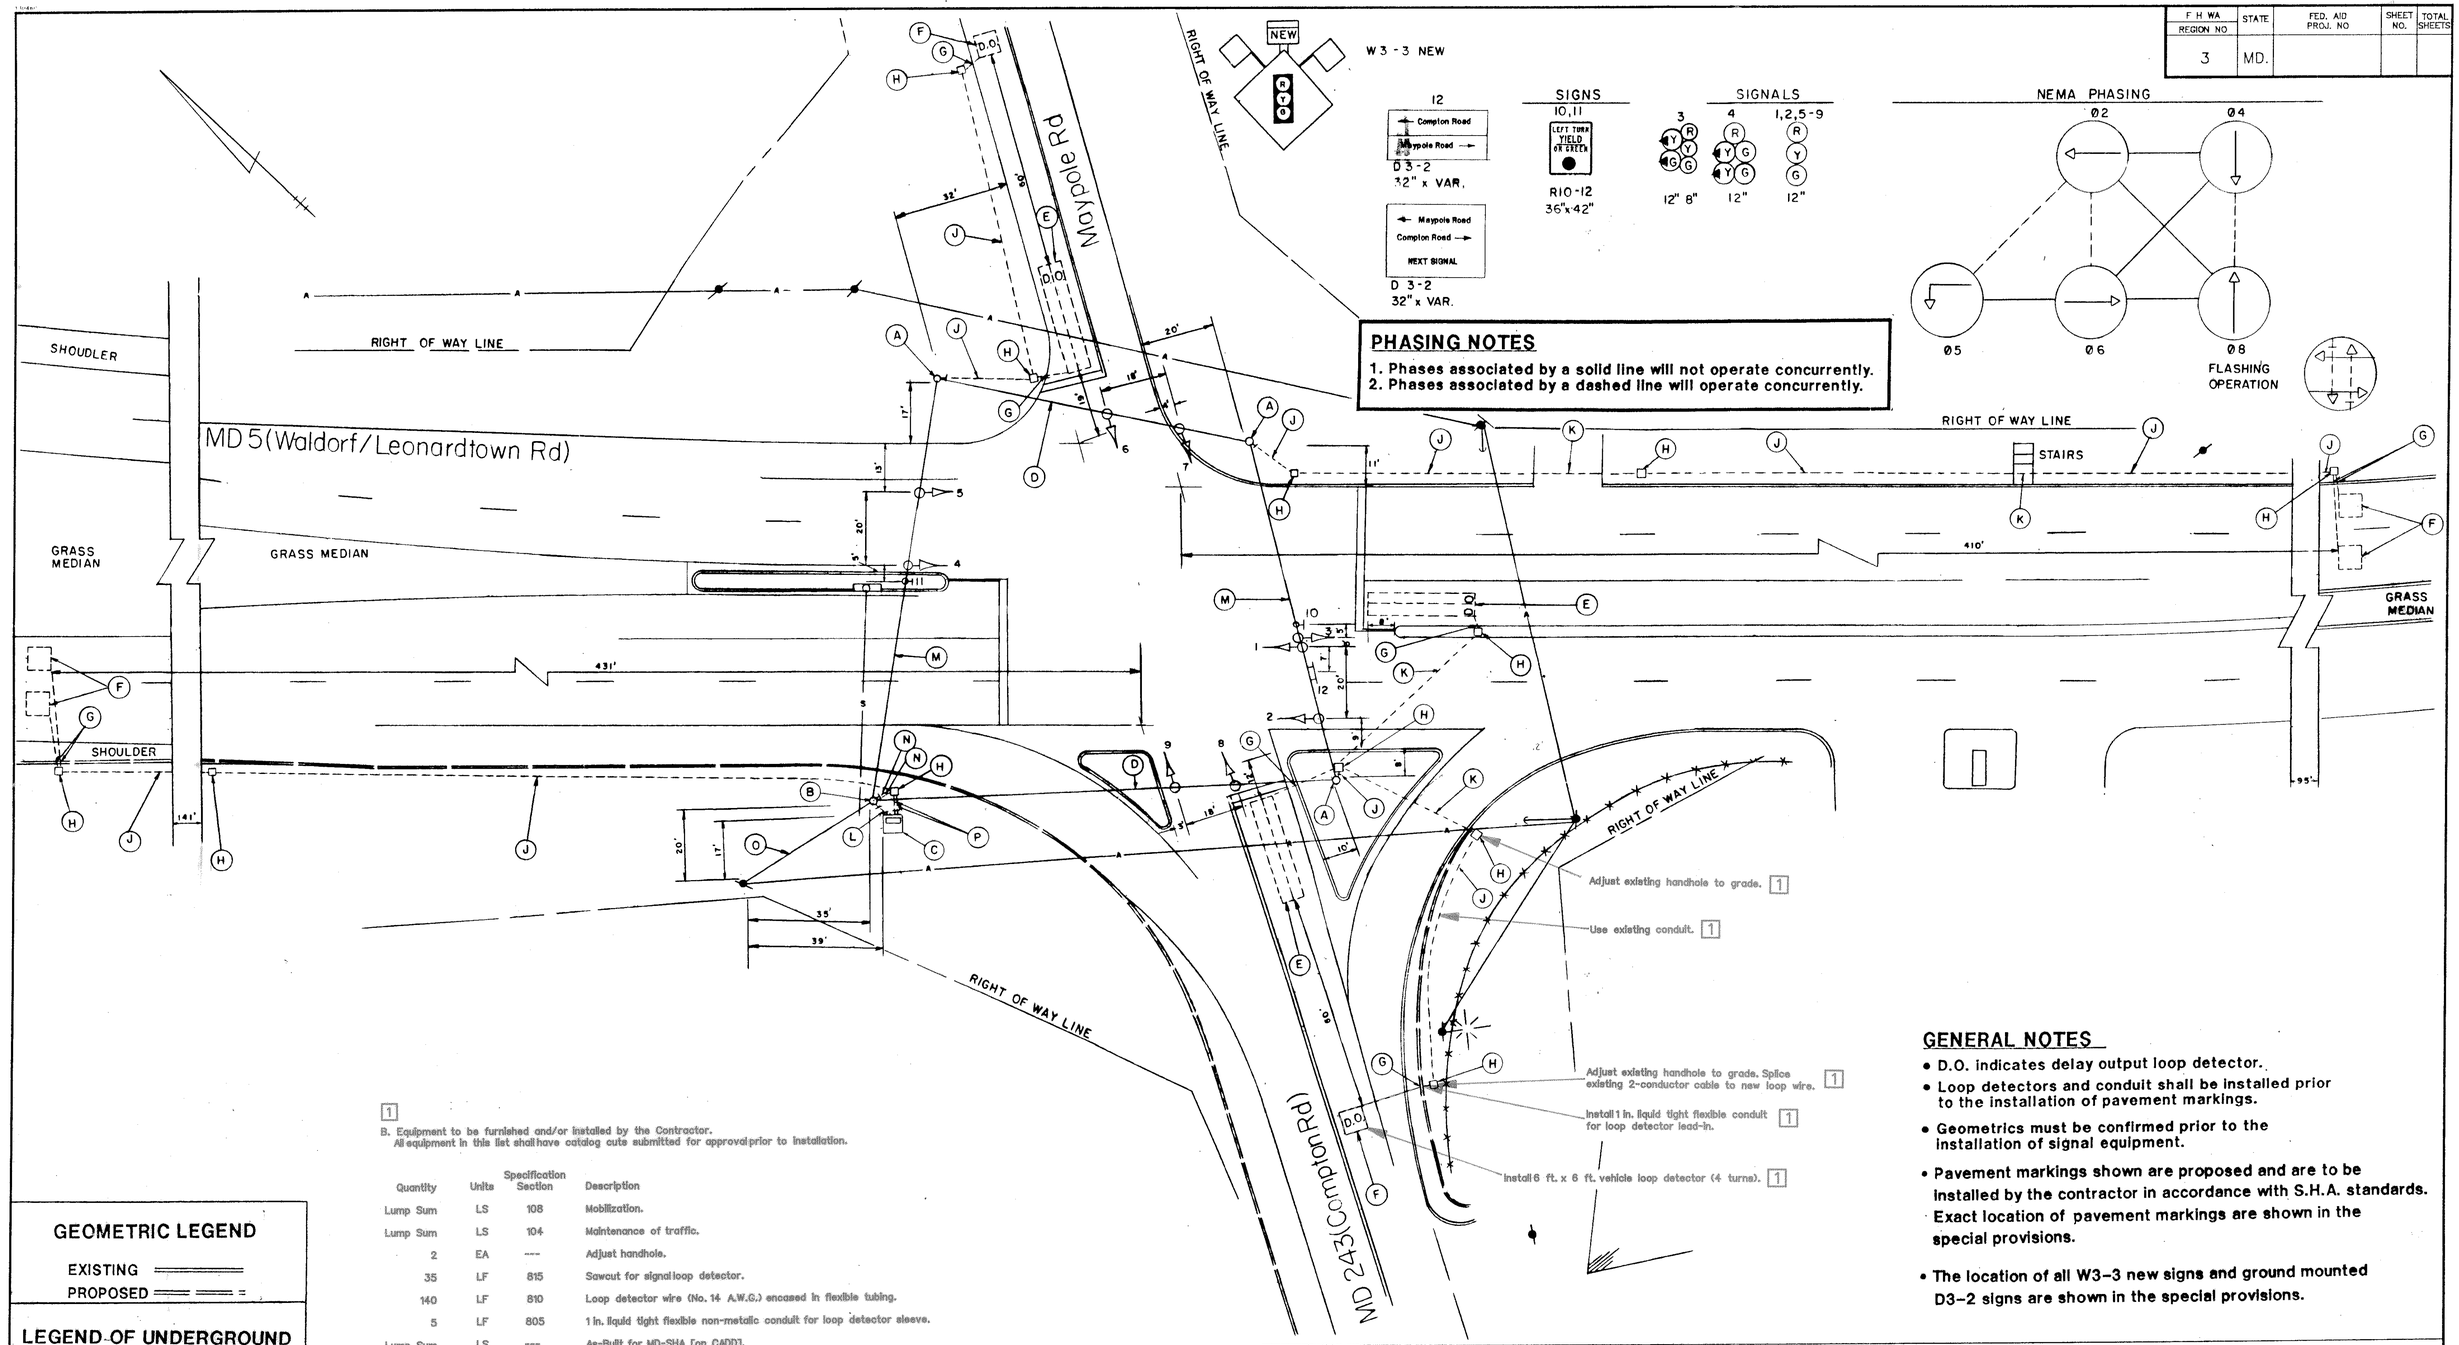

1

B. Equipment to be furnished and/or installed by the Contractor.
All equipment in this list shall have catalog cuts submitted for approval prior to installation.

Quantity	Units	Specification Section	Description
Lump Sum	LS	108	Mobilization.
Lump Sum	LS	104	Maintenance of traffic.
2	EA	----	Adjust handhole.
35	LF	815	Sawcut for signal loop detector.
140	LF	810	Loop detector wire (No. 14 A.W.G.) encased in flexible tubing.
5	LF	805	1 in. liquid tight flexible non-metallic conduit for loop detector sleeve.
Lump Sum	LS	----	As-Built for MD-SHA (on CADD).

GENERAL NOTES

- D.O. indicates delay output loop detector.
- Loop detectors and conduit shall be installed prior to the installation of pavement markings.
- Geometrics must be confirmed prior to the installation of signal equipment.
- Pavement markings shown are proposed and are to be installed by the contractor in accordance with S.H.A. standards. Exact location of pavement markings are shown in the special provisions.
- The location of all W3-3 new signs and ground mounted D3-2 signs are shown in the special provisions.

GEOMETRIC LEGEND

EXISTING
PROPOSED

LEGEND OF UNDERGROUND AND OVERHEAD UTILITIES

GAS — G — G — G —
SEWER — S — S — S —
WATER — W — W — W —
ELECTRIC — E — E — E
CABLE TV — TV — TV — TV
TELEPHONE — T — T — T —
AERIAL CABLE — A — A —

THE TRAFFIC GROUP, INC.
414 East Joppa Road
Towson, Maryland 21204
Telephone 301-583-8405

REVISIONS	APPROVALS
	CHIEF, SIGNAL DESIGN SECTION 2/14/89
	ASST. DISTRICT ENGINEER, TRAFFIC 2/14/89
	CHIEF, BUREAU OF TRAFFIC ENGINEERING 2/14/89
Modify handholes & loops due to new geometrics 1	DEPUTY CHIEF ENGINEER, OFFICE OF TRAFFIC 2/16/89

1 Red Line Revision January 5, 2000

MARYLAND DEPARTMENT OF TRANSPORTATION
STATE HIGHWAY ADMINISTRATION – OFFICE OF TRAFFIC
BUREAU OF TRAFFIC ENGINEERING

DRAWN BY: MAM
DES. BY: M.A.M.
CHK. BY: 2-10-89

MD 5 AND MD 243

COUNTY: ST MARY'S

DATE: 11/9/88
SCALE: 1"=20'
F.A.P. NO.
S.H.A. NO. BW-193-801-512
TS/FILE NO. 2537
SHEET NO. ___ OF ___

18000530.32