F.H.W.A. REGION NO.	STATE	FED. AID PROJ. NO.	SHEET NO.	TOTAL SHEETS
3	MD.		2	5

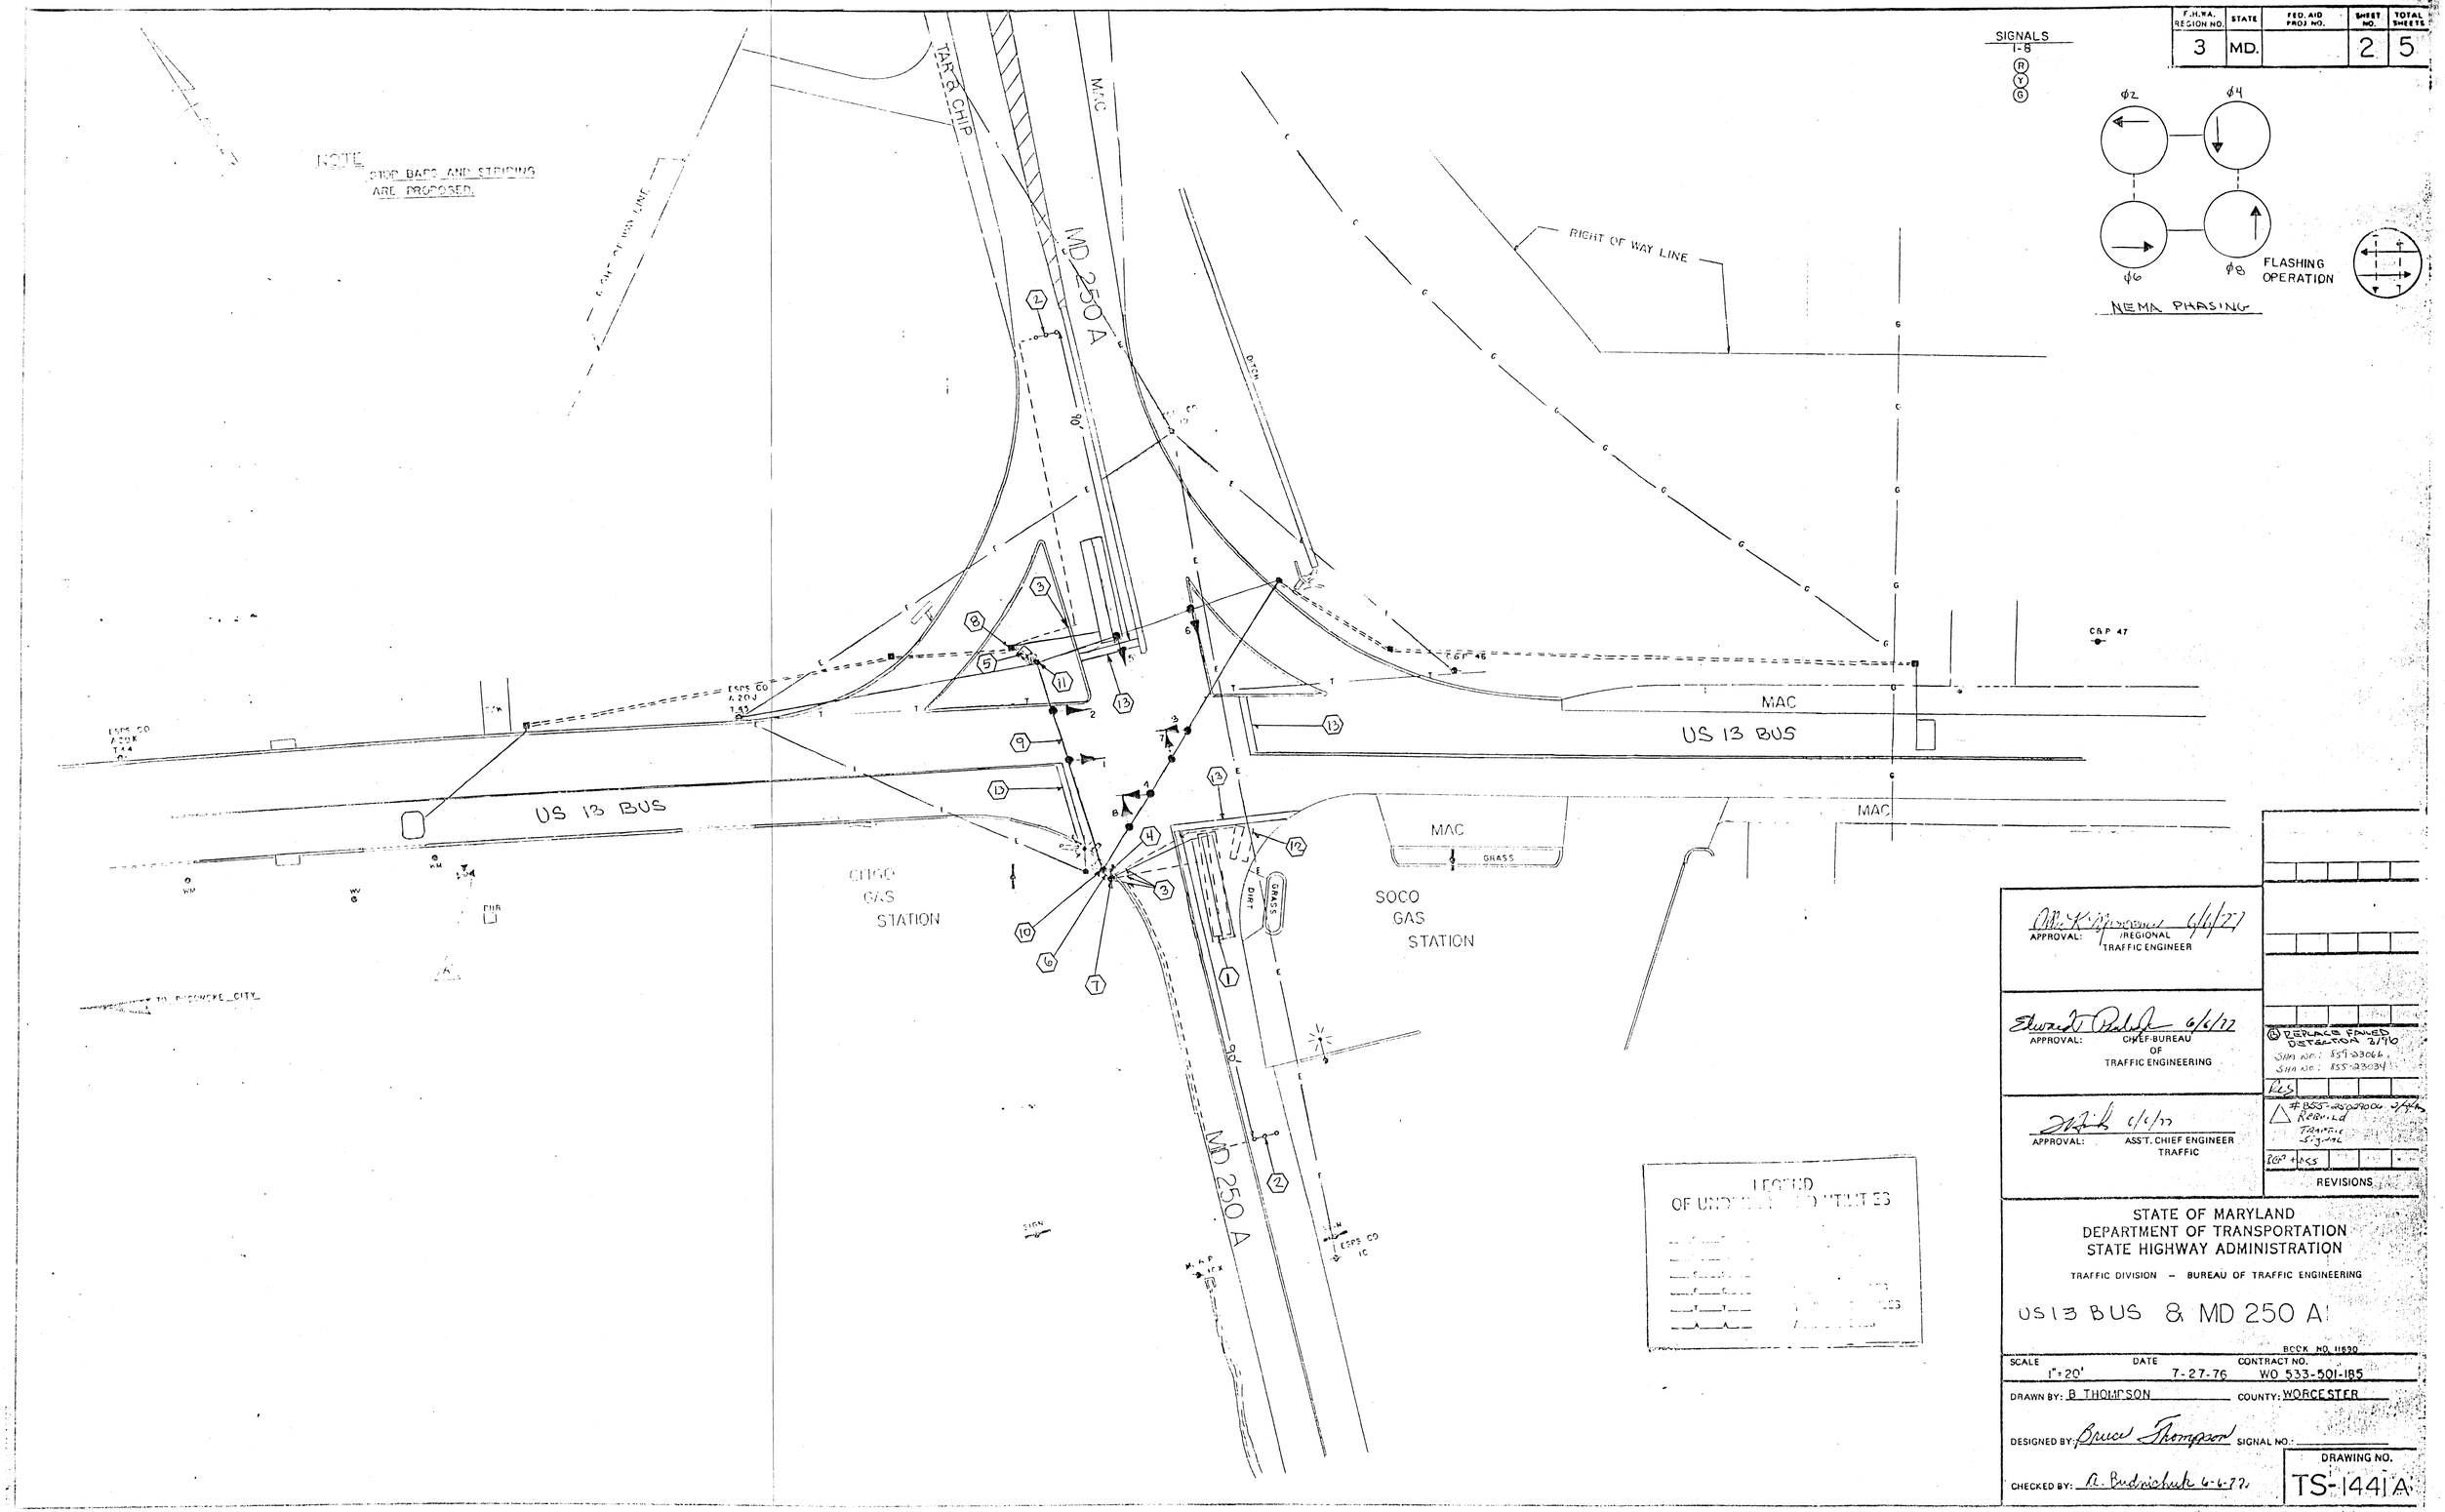

APPROVAL: [signature] 6/6/77 REGIONAL TRAFFIC ENGINEER

APPROVAL: [signature] 6/6/77 CHIEF-BUREAU OF TRAFFIC ENGINEERING

APPROVAL: [signature] 6/6/77 ASS'T. CHIEF ENGINEER TRAFFIC

REPLACE FAILED DETECTION 3/90
SHA NO.: 859-23066
SHA NO.: 855-23034
RES
#855-25029006 2/4/76 REBUILD TRAFFIC SIGNAL
REP + ASS
REVISIONS

STATE OF MARYLAND
DEPARTMENT OF TRANSPORTATION
STATE HIGHWAY ADMINISTRATION

TRAFFIC DIVISION – BUREAU OF TRAFFIC ENGINEERING

US 13 BUS & MD 250 A

BOOK NO. 11690

SCALE	DATE	CONTRACT NO.
1" = 20'	7-27-76	WO 533-501-185

DRAWN BY: B THOMPSON COUNTY: WORCESTER

DESIGNED BY: Bruce Thompson SIGNAL NO.:

CHECKED BY: A. Budnichuk 6-6-77

DRAWING NO. TS-1441A

23A25000.01